


Plat of Survey
of

Lots 5 and 6 of Roughwood Park, a subdivision located in the Northeast 1/4 of the Southwest 1/4 and the Southeast 1/4 of the Northwest 1/4 of Section 36, T 4 N, R 16 E, Town of Lagrange, Walworth County, Wisconsin.

Surveyed for: **Al Busa**
3345 North Arlington Heights Road
Suite M
Arlington Heights, Illinois 60004

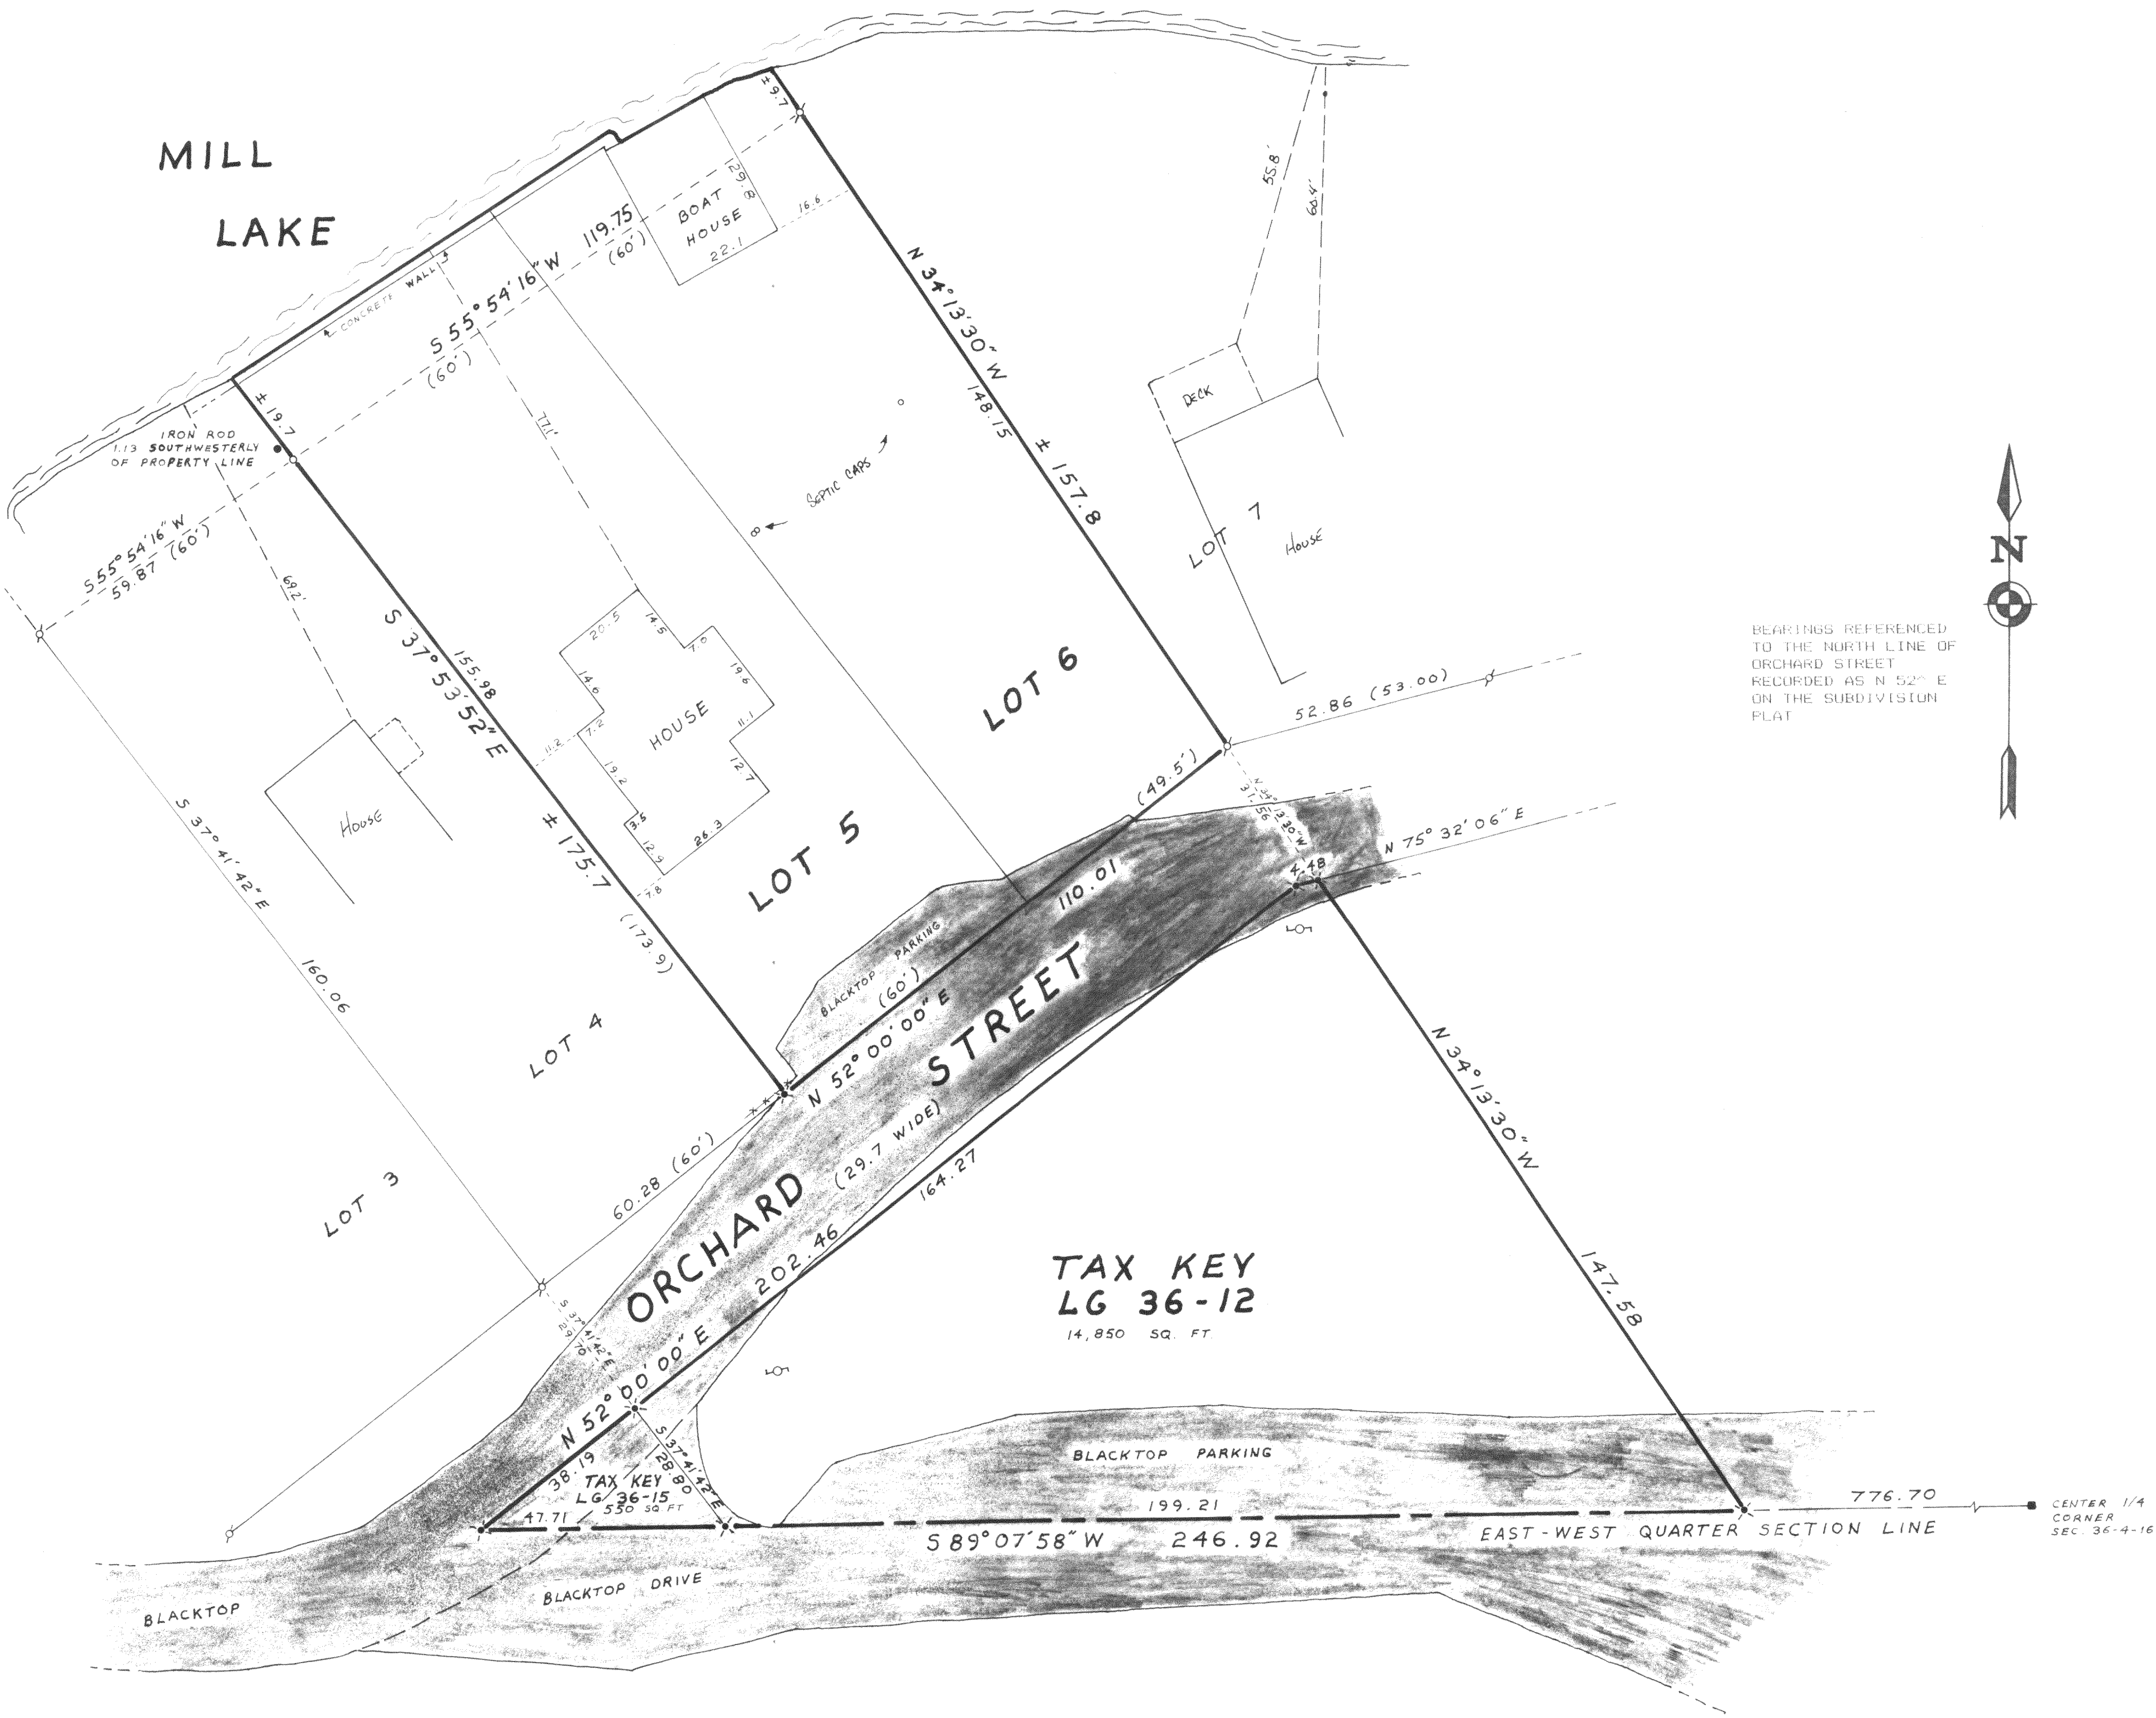


Copyright © 1995 by Jensen Surveying & Mapping S.C.

All rights reserved. No part of this survey plat may be reproduced or transmitted in any form by any means - graphic, electronic, or mechanical, including photocopying, tracing, or information storage and retrieval systems - without permission in writing from Thomas P.A. Jensen, Jensen Surveying & Mapping S.C.

I, Thomas P.A. Jensen, Wisconsin Registered Land Surveyor, do hereby certify that this survey was performed by me, or under my direction in full compliance with the owner's / agent's instructions and Chapter A-E 7 of the Wisconsin Administrative Code "Minimum Standards for Property Surveys", and that this map is as accurate representation thereof to the best of my knowledge and belief.


Note: This survey plat is not certified unless signed and sealed in red ink.

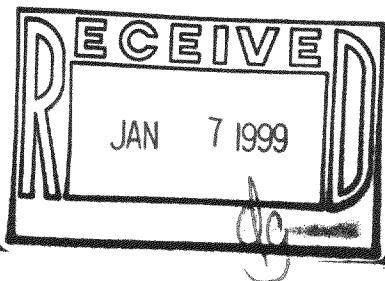


Sheet no. 1 of 1 sheets.
Job reference number
1995.100

Legend
X - RAILROAD SPIKE
O - IRON PIPE
P - FOUND IRON PIPE
P - POWER POLE
() - RECORDED DIMENSION
- FENCE
• - FOUND IRON ROD

JENSEN SURVEYING & MAPPING S.C.
45 South Wisconsin Street P.O. Box 322
Elkhorn, Wisconsin 53121
(414) 723-3434

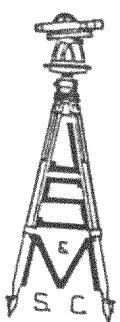

Scale: 1" = 20'

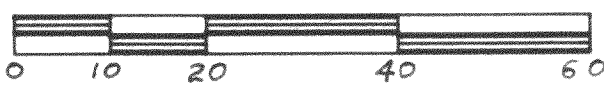

Mapping date: 11-9-95
Revisions: _____

1995.100

HRP-4 416-1409