


BOUNDARY & TOPOGRAPHIC MAPPING

LOT 1 OF ZEE SUBDIVISION

LOCATED IN SECTION 36, TOW 4 NORTH, RANGE 16 EAST
WALWORTH COUNTY, WISCONSIN

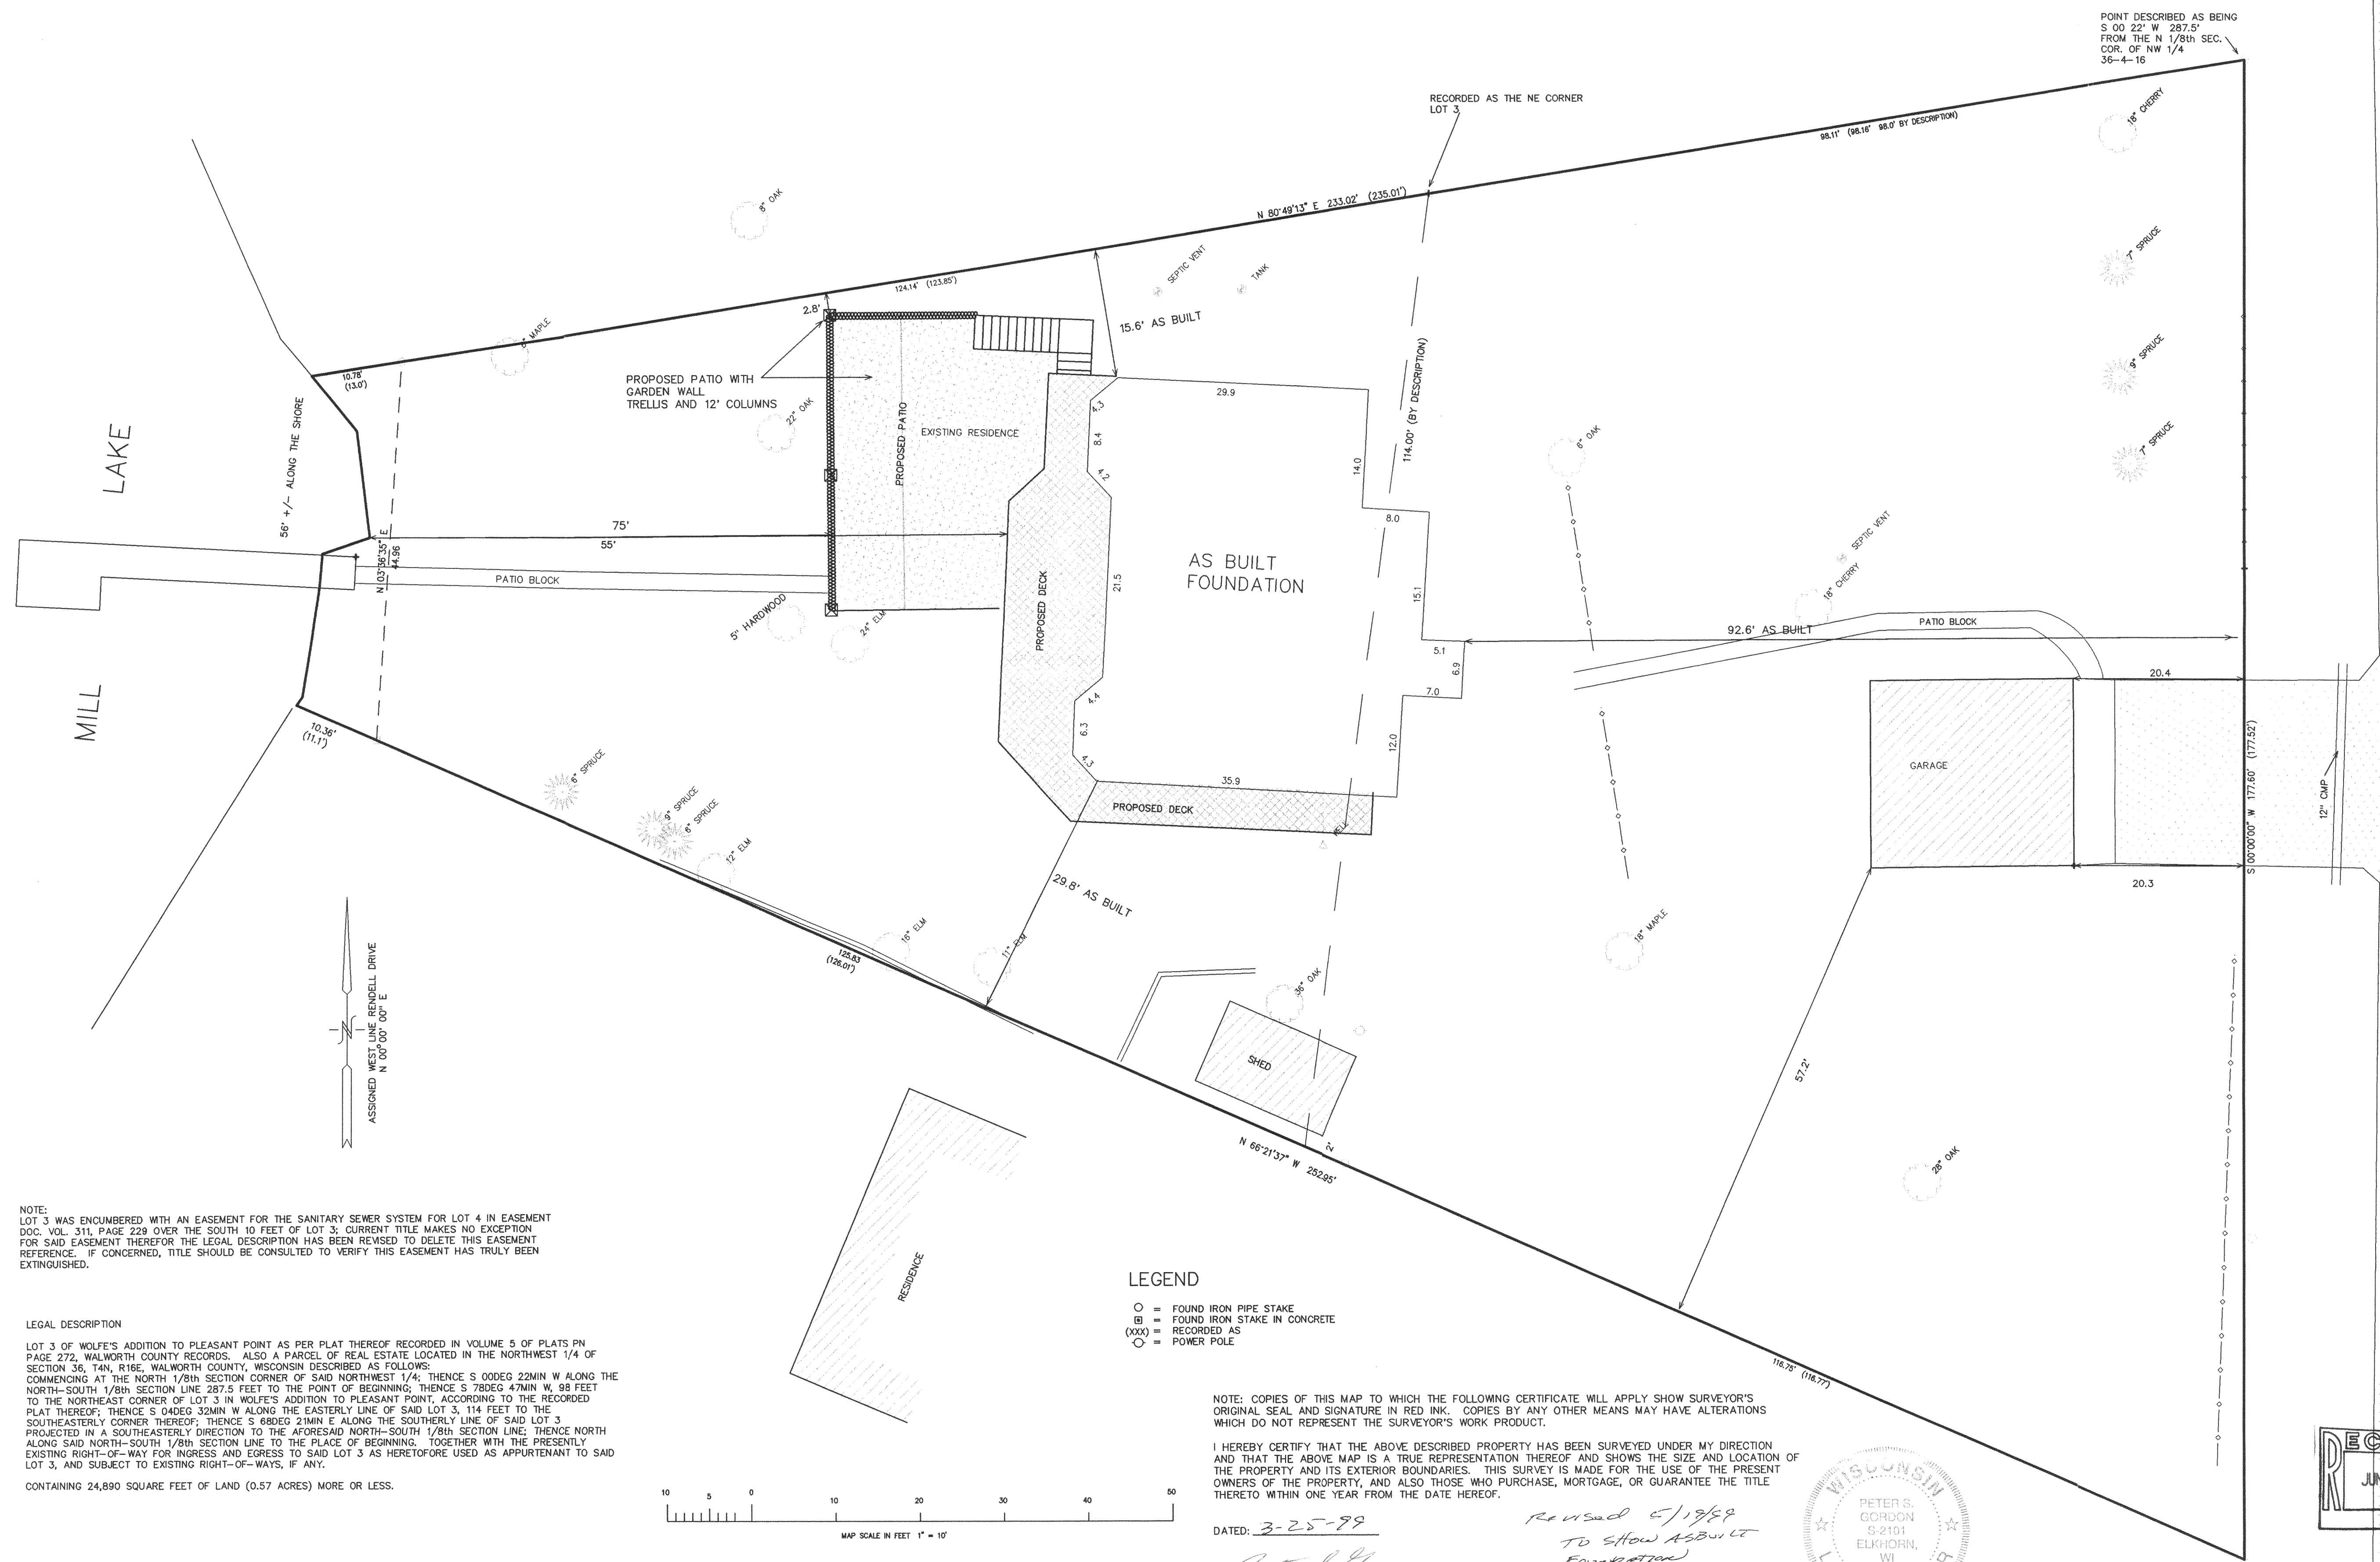

NOTE:
LOT 3 WAS ENCUMBERED WITH AN EASEMENT FOR THE SANITARY SEWER SYSTEM FOR LOT 4 IN EASEMENT DOC. VOL. 311, PAGE 229 OVER THE SOUTH 10 FEET OF LOT 3; CURRENT TITLE MAKES NO EXCEPTION FOR SAID EASEMENT THEREFOR THE LEGAL DESCRIPTION HAS BEEN REVISED TO DELETE THIS EASEMENT REFERENCE. IF CONCERNED, TITLE SHOULD BE CONSULTED TO VERIFY THIS EASEMENT HAS TRULY BEEN EXTINGUISHED.

LEGAL DESCRIPTION
LOT 3 OF WOLFE'S ADDITION TO PLEASANT POINT AS PER PLAT THEREOF RECORDED IN VOLUME 5 OF PLATS PN PAGE 272, WALWORTH COUNTY RECORDS. ALSO A PARCEL OF REAL ESTATE LOCATED IN THE NORTHWEST 1/4 OF SECTION 36, T4N, R16E, WALWORTH COUNTY, WISCONSIN DESCRIBED AS FOLLOWS:
COMMENCING AT THE NORTH 1/8th SECTION CORNER OF SAID NORTHWEST 1/4; THENCE S 00DEG 22MIN W ALONG THE NORTH-SOUTH 1/8th SECTION LINE 287.5 FEET TO THE POINT OF BEGINNING; THENCE S 78DEG 47MIN W, 98 FEET TO THE NORTHEAST CORNER OF LOT 3 IN WOLFE'S ADDITION TO PLEASANT POINT, ACCORDING TO THE RECORDED PLAT THEREOF; THENCE S 04DEG 30MIN W ALONG THE EASTERLY LINE OF SAID LOT 3, 114 FEET TO THE SOUTHEASTERLY CORNER THEREOF; THENCE S 68DEG 21MIN E ALONG THE SOUTHERLY LINE OF SAID LOT 3 PROJECTED IN A SOUTHEASTERLY DIRECTION TO THE AFORESAID NORTH-SOUTH 1/8th SECTION LINE; THENCE NORTH ALONG SAID NORTH-SOUTH 1/8th SECTION LINE TO THE PLACE OF BEGINNING. TOGETHER WITH THE PRESENTLY EXISTING RIGHT-OF-WAY FOR INGRESS AND EGRESS TO SAID LOT 3 AS HERETOFORE USED AS APPURTENANT TO SAID LOT 3, AND SUBJECT TO EXISTING RIGHT-OF-WAYS, IF ANY.
CONTAINING 24,890 SQUARE FEET OF LAND (0.57 ACRES) MORE OR LESS.





- LEGEND**
- = FOUND IRON PIPE STAKE
 - ⊕ = FOUND IRON STAKE IN CONCRETE
 - (XX) = RECORDED AS
 - ⊖ = POWER POLE

NOTE: COPIES OF THIS MAP TO WHICH THE FOLLOWING CERTIFICATE WILL APPLY SHOW SURVEYOR'S ORIGINAL SEAL AND SIGNATURE IN RED INK. COPIES BY ANY OTHER MEANS MAY HAVE ALTERATIONS WHICH DO NOT REPRESENT THE SURVEYOR'S WORK PRODUCT.

I HEREBY CERTIFY THAT THE ABOVE DESCRIBED PROPERTY HAS BEEN SURVEYED UNDER MY DIRECTION AND THAT THE ABOVE MAP IS A TRUE REPRESENTATION THEREOF AND SHOWS THE SIZE AND LOCATION OF THE PROPERTY AND ITS EXTERIOR BOUNDARIES. THIS SURVEY IS MADE FOR THE USE OF THE PRESENT OWNERS OF THE PROPERTY, AND ALSO THOSE WHO PURCHASE, MORTGAGE, OR GUARANTEE THE TITLE THERETO WITHIN ONE YEAR FROM THE DATE HEREOF.

DATE: 3-25-99
Peter S. Gordon
 PETER S. GORDON R.L.S. 2101

*Revised 5/19/99
To show AS BUILT
Foundation*

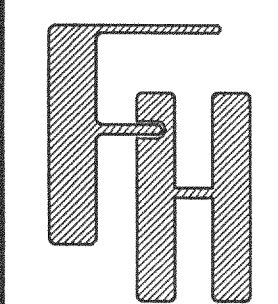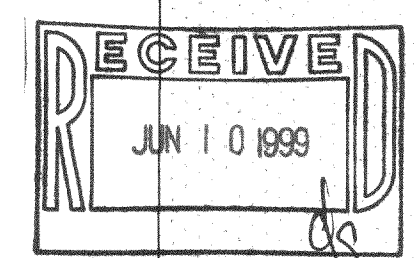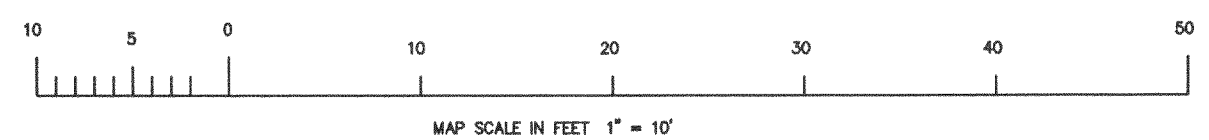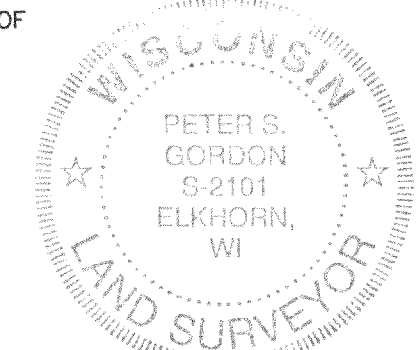

WORK ORDERED BY:
 RICHARD ZENGER
 N7673 RENDELL DRIVE
 ELKHORN, WI.

FARRIS, HANSEN & ASSOCIATES, INC.
 Engineering, Architecture, Surveying
 7 Ridgeway Court P. O. Box 437
 ELKHORN, WISCONSIN 53121
 Office: (414) 723-2098
 Fax: (414) 723-5886

REVISIONS
 12-14-98
 SHOW PROPOSED ADD.

PROJECT NO.
 4385
 DATE
 11-06-98
 SHEET NO.
 1 OF 1

HZE-1 416-1443