


PLAT OF SURVEY
LOT 10 EXCLUDING THE WESTERLY 10' THEREOF
AND THE WESTERLY 35' OF LOT 11
1st ADDITION TO LAUDERDALE PARK
 LOCATED IN SECTION 25, TOWN 4 NORTH, RANGE 16 EAST,
 WALWORTH COUNTY, WISCONSIN

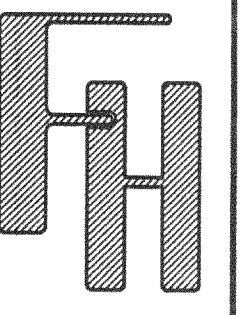



PLAT OF SURVEY

WORK ORDERED BY -
 PAUL E. JOSEPH
 C/O KEETE REAL ESTATE
 P.O. BOX 460
 LAKE GENEVA, WI 53147

FARRIS, HANSEN & ASSOCIATES, INC.
 Engineering, Architecture, Surveying
 7 Ridgeway Court, P.O. Box 437
 ELKHORN, WISCONSIN 53121
 Office: (414) 723-2098
 Fax: (414) 723-5886


REVISIONS

PROJECT NO.
5020
 DATE
06/01/98
 SHEET NO.
1 OF 1

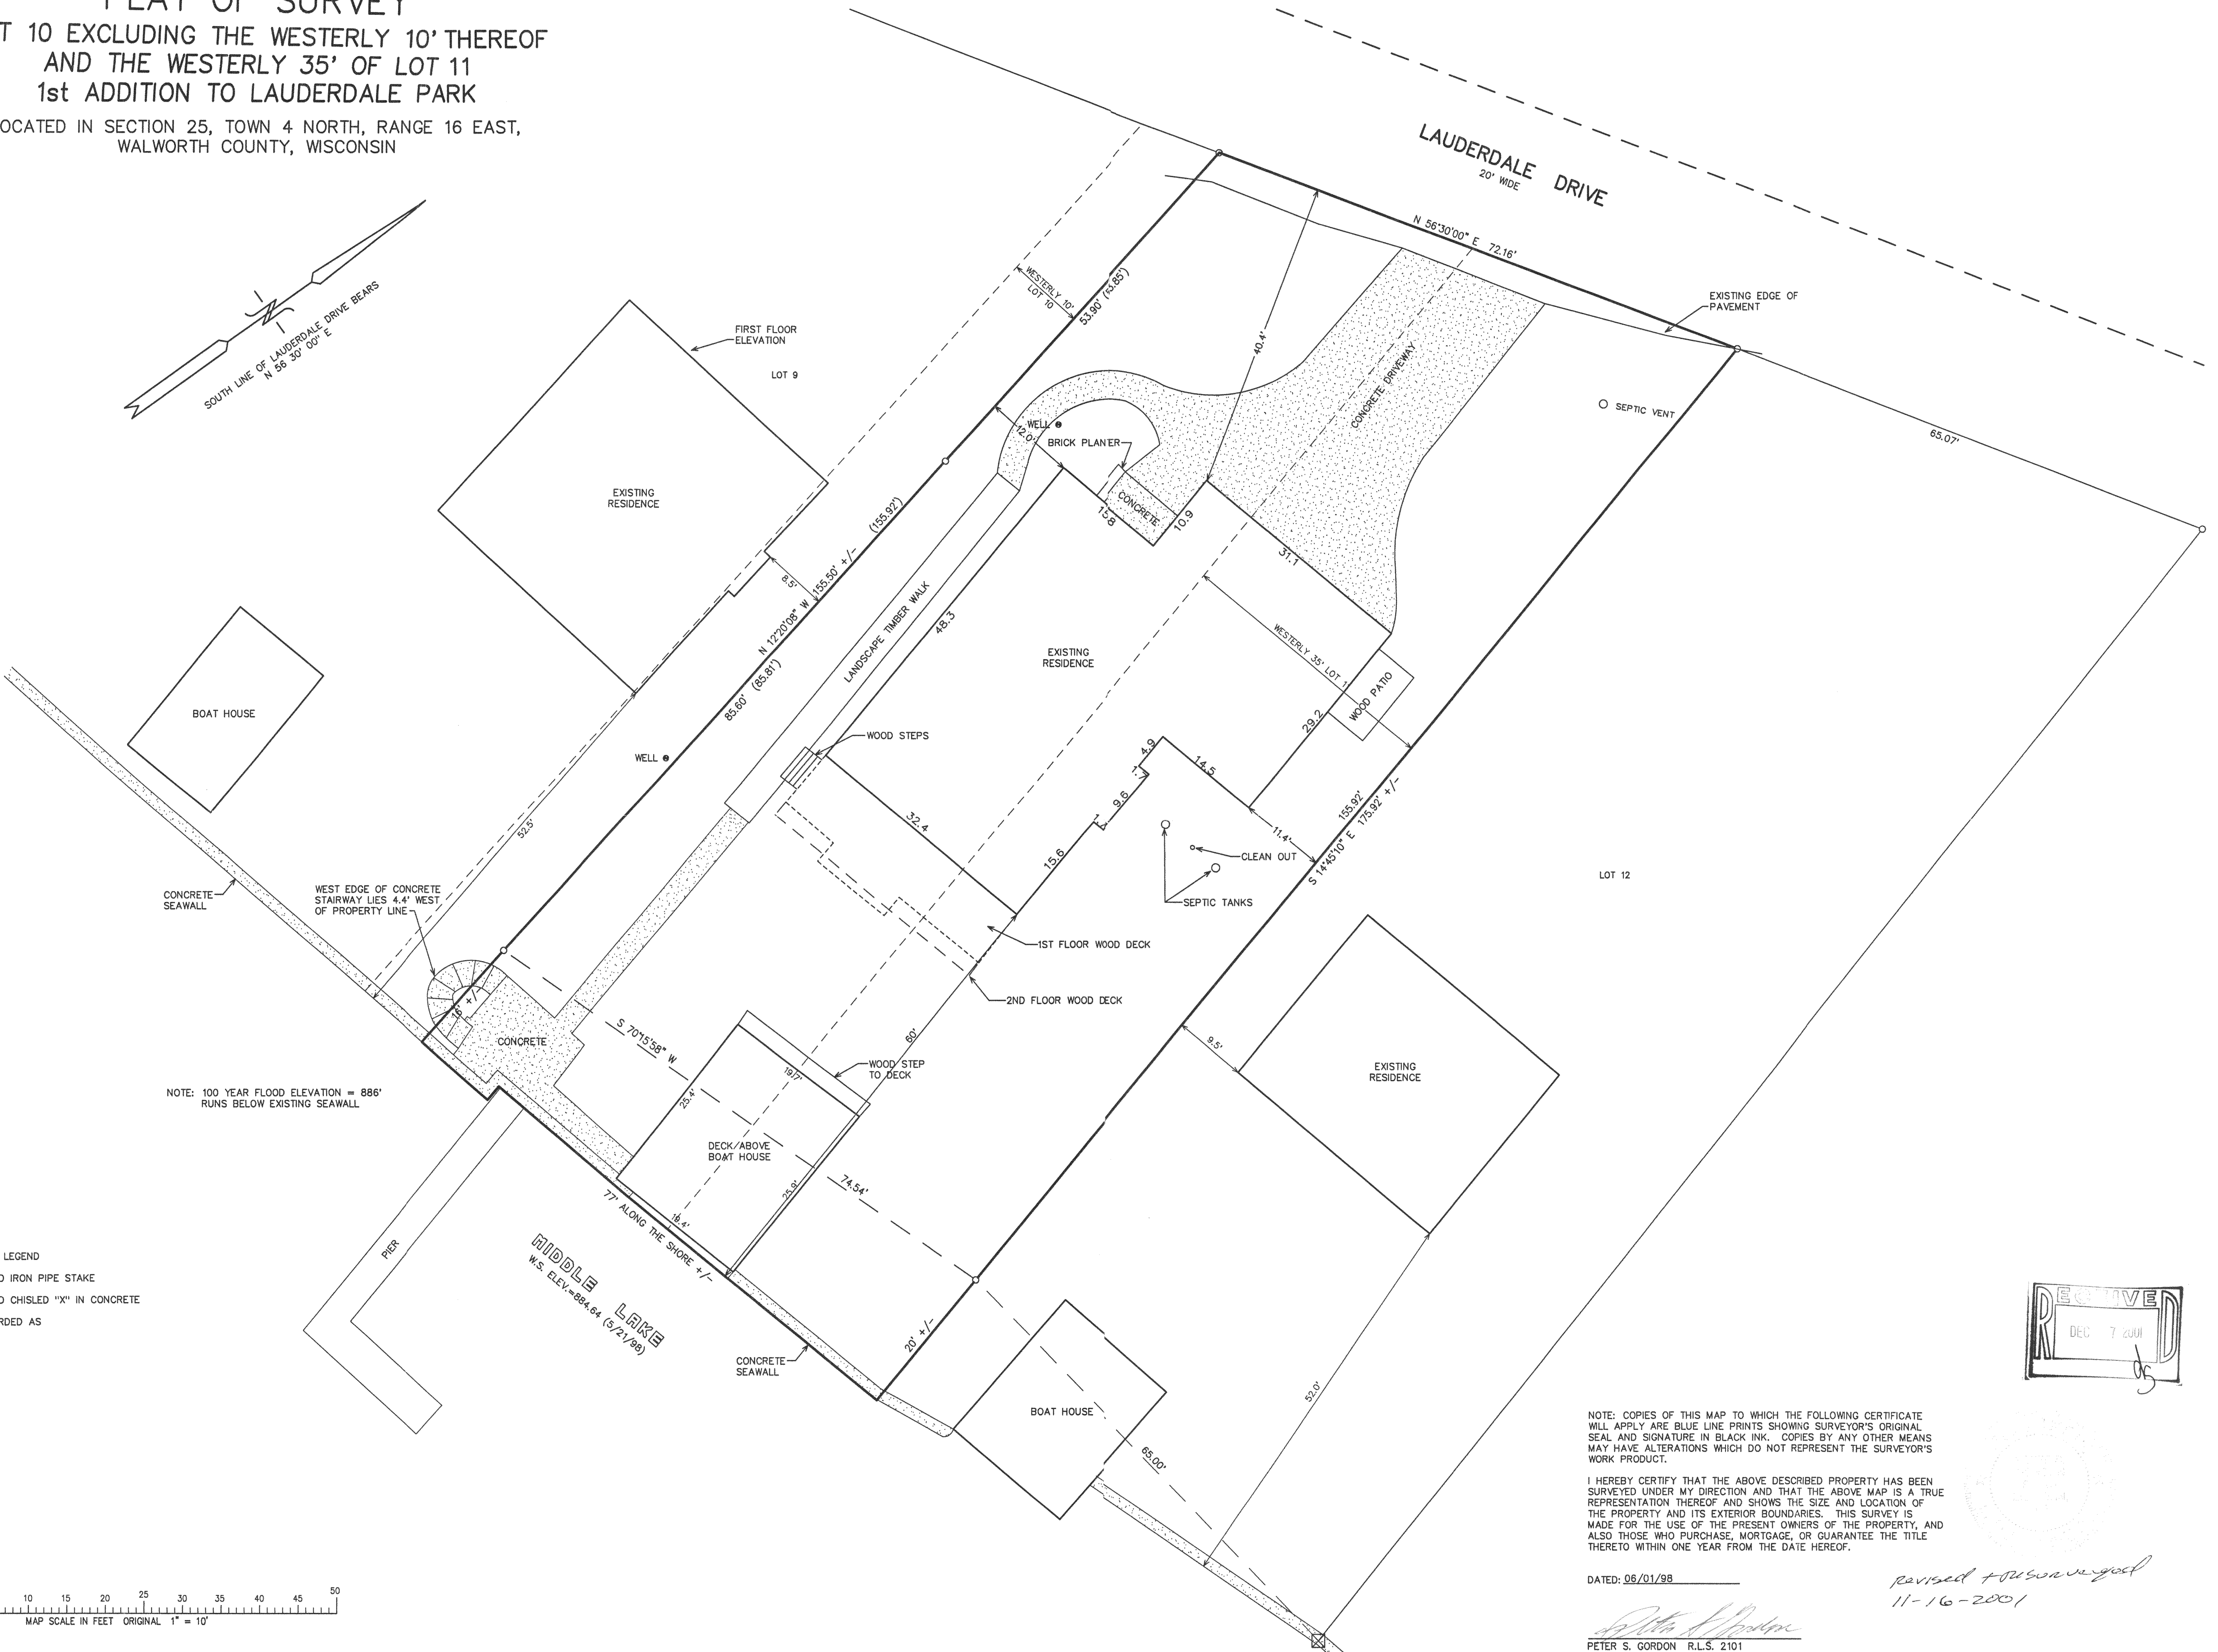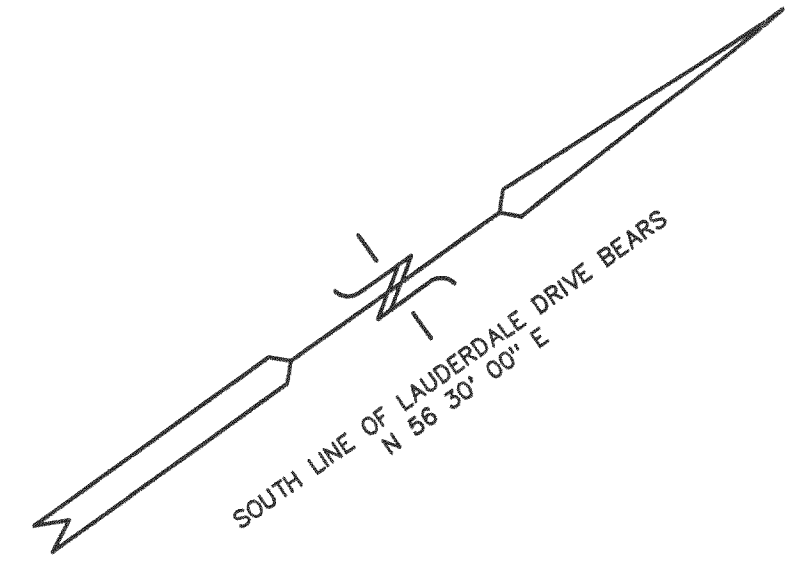

NOTE: 100 YEAR FLOOD ELEVATION = 886'
 RUNS BELOW EXISTING SEAWALL

- LEGEND
- = FOUND IRON PIPE STAKE
 - ⊗ = FOUND CHISELED "X" IN CONCRETE
 - (XXX) = RECORDED AS

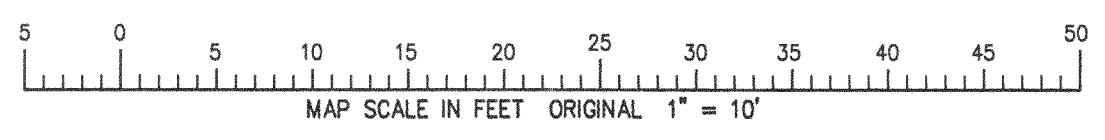


NOTE: COPIES OF THIS MAP TO WHICH THE FOLLOWING CERTIFICATE WILL APPLY ARE BLUE LINE PRINTS SHOWING SURVEYOR'S ORIGINAL SEAL AND SIGNATURE IN BLACK INK. COPIES BY ANY OTHER MEANS MAY HAVE ALTERATIONS WHICH DO NOT REPRESENT THE SURVEYOR'S WORK PRODUCT.

I HEREBY CERTIFY THAT THE ABOVE DESCRIBED PROPERTY HAS BEEN SURVEYED UNDER MY DIRECTION AND THAT THE ABOVE MAP IS A TRUE REPRESENTATION THEREOF AND SHOWS THE SIZE AND LOCATION OF THE PROPERTY AND ITS EXTERIOR BOUNDARIES. THIS SURVEY IS MADE FOR THE USE OF THE PRESENT OWNERS OF THE PROPERTY, AND ALSO THOSE WHO PURCHASE, MORTGAGE, OR GUARANTEE THE TITLE THERETO WITHIN ONE YEAR FROM THE DATE HEREOF.

DATED: 06/01/98

 PETER S. GORDON R.L.S. 2101

revised for survey
 11-16-2001

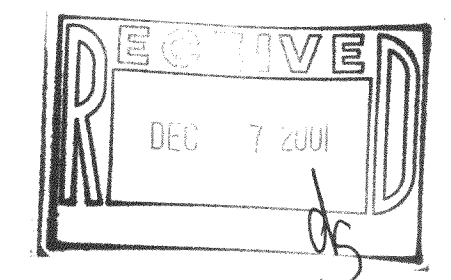

HWP-31

416-1743

REV 1 6 2001