


HAROLD H. KOLB

REGISTERED PROFESSIONAL LAND SURVEYOR
LAKE GENEVA, WISCONSIN

BAY DRIVE 66' WIDE

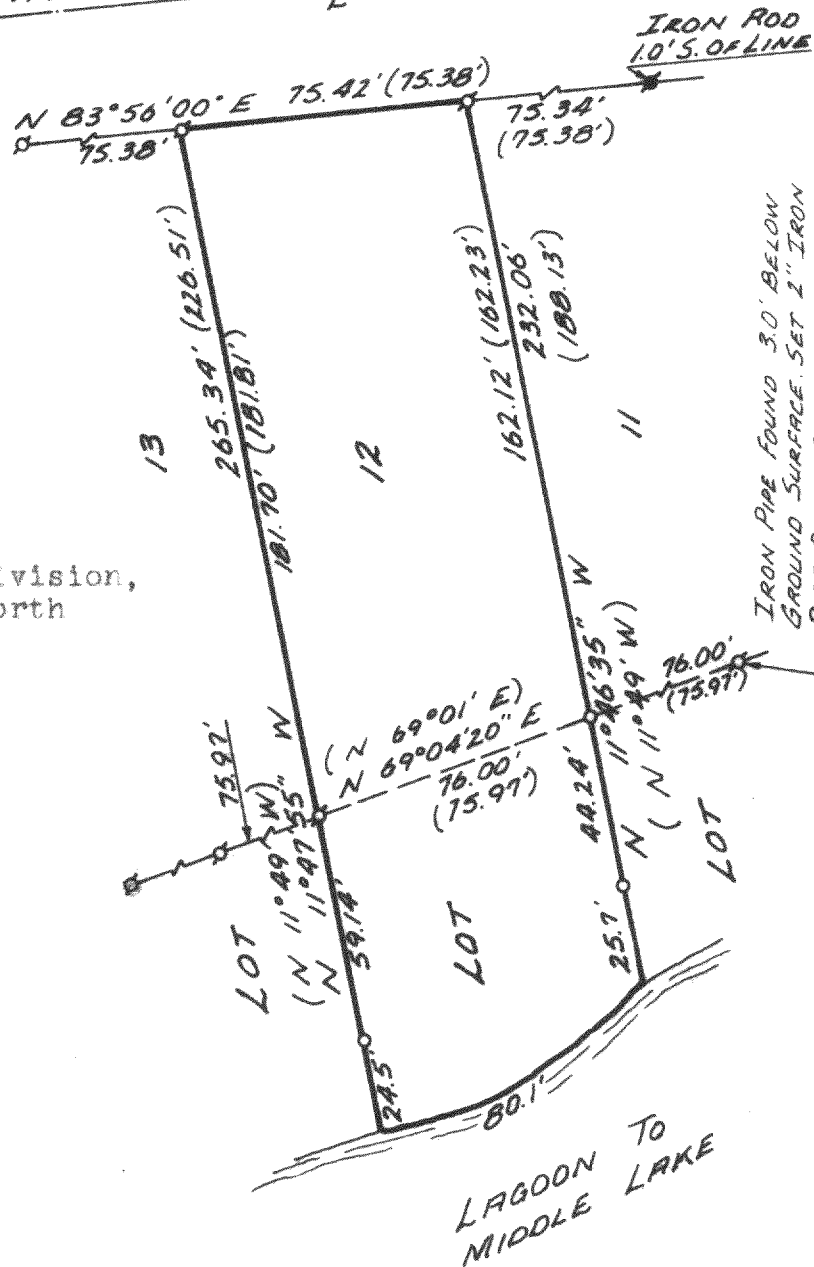

PLAT OF SURVEY OF

Lot 12, Bubbling Springs Subdivision,
Section 34, T.4N, R.16E, Walworth
County, Wisconsin.


Ordered by: Angie Stenstrom



SCALE: 1"=50'

LEGEND

- φ - IRON PIPE FOUND
- - IRON PIPE PLACED
- - IRON ROD FOUND
- x - SPIKE
- () - PLATTED AS

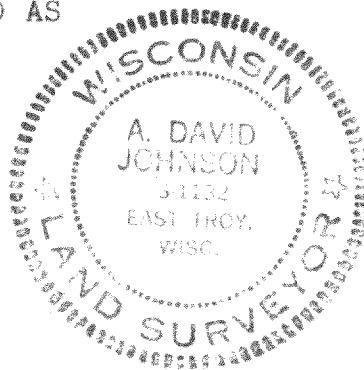

I, A. David Johnson, DO HEREBY CERTIFY THAT I HAVE SURVEYED THE PROPERTY HEREON DESCRIBED ACCORDING TO THE OFFICIAL RECORDS, AND THAT THE PLAT HEREON IS A CORRECT REPRESENTATION OF THE LOT LINES.

A. David Johnson
A. DAVID JOHNSON
WISCONSIN REGISTERED LAND SURVEYOR, S1132
DATE OCTOBER 1, 1976

HBS-12

416-252