

LEGEND


- FOUND IRON PIPE
- ⋈ FOUND IRON ROD
- FOUND P.K. NAIL
- ⌒ UTILITY POLE
- () RECORDED AS

PLAT OF SURVEY -OF-

LOT NINE (9), IN THE PLAT OF "OAK PARK", A SUBDIVISION IN PART OF THE SOUTHEAST 1/4 OF SECTION 26, TOWN 4 NORTH, RANGE 16 EAST, WHICH PLAT IS RECORDED IN VOLUME 6 OF PLATS, ON PAGE 18, WALWORTH COUNTY, WISCONSIN, TOGETHER WITH RIGHT OF WAY AS NOW TRAVELLED.


SURVEY FOR: KAREN OSTERMEIER OF
KEEFE REAL ESTATE

SURVEY ADDRESS: W5525 OAK PARK ROAD,
ELKHORN, WI 53121


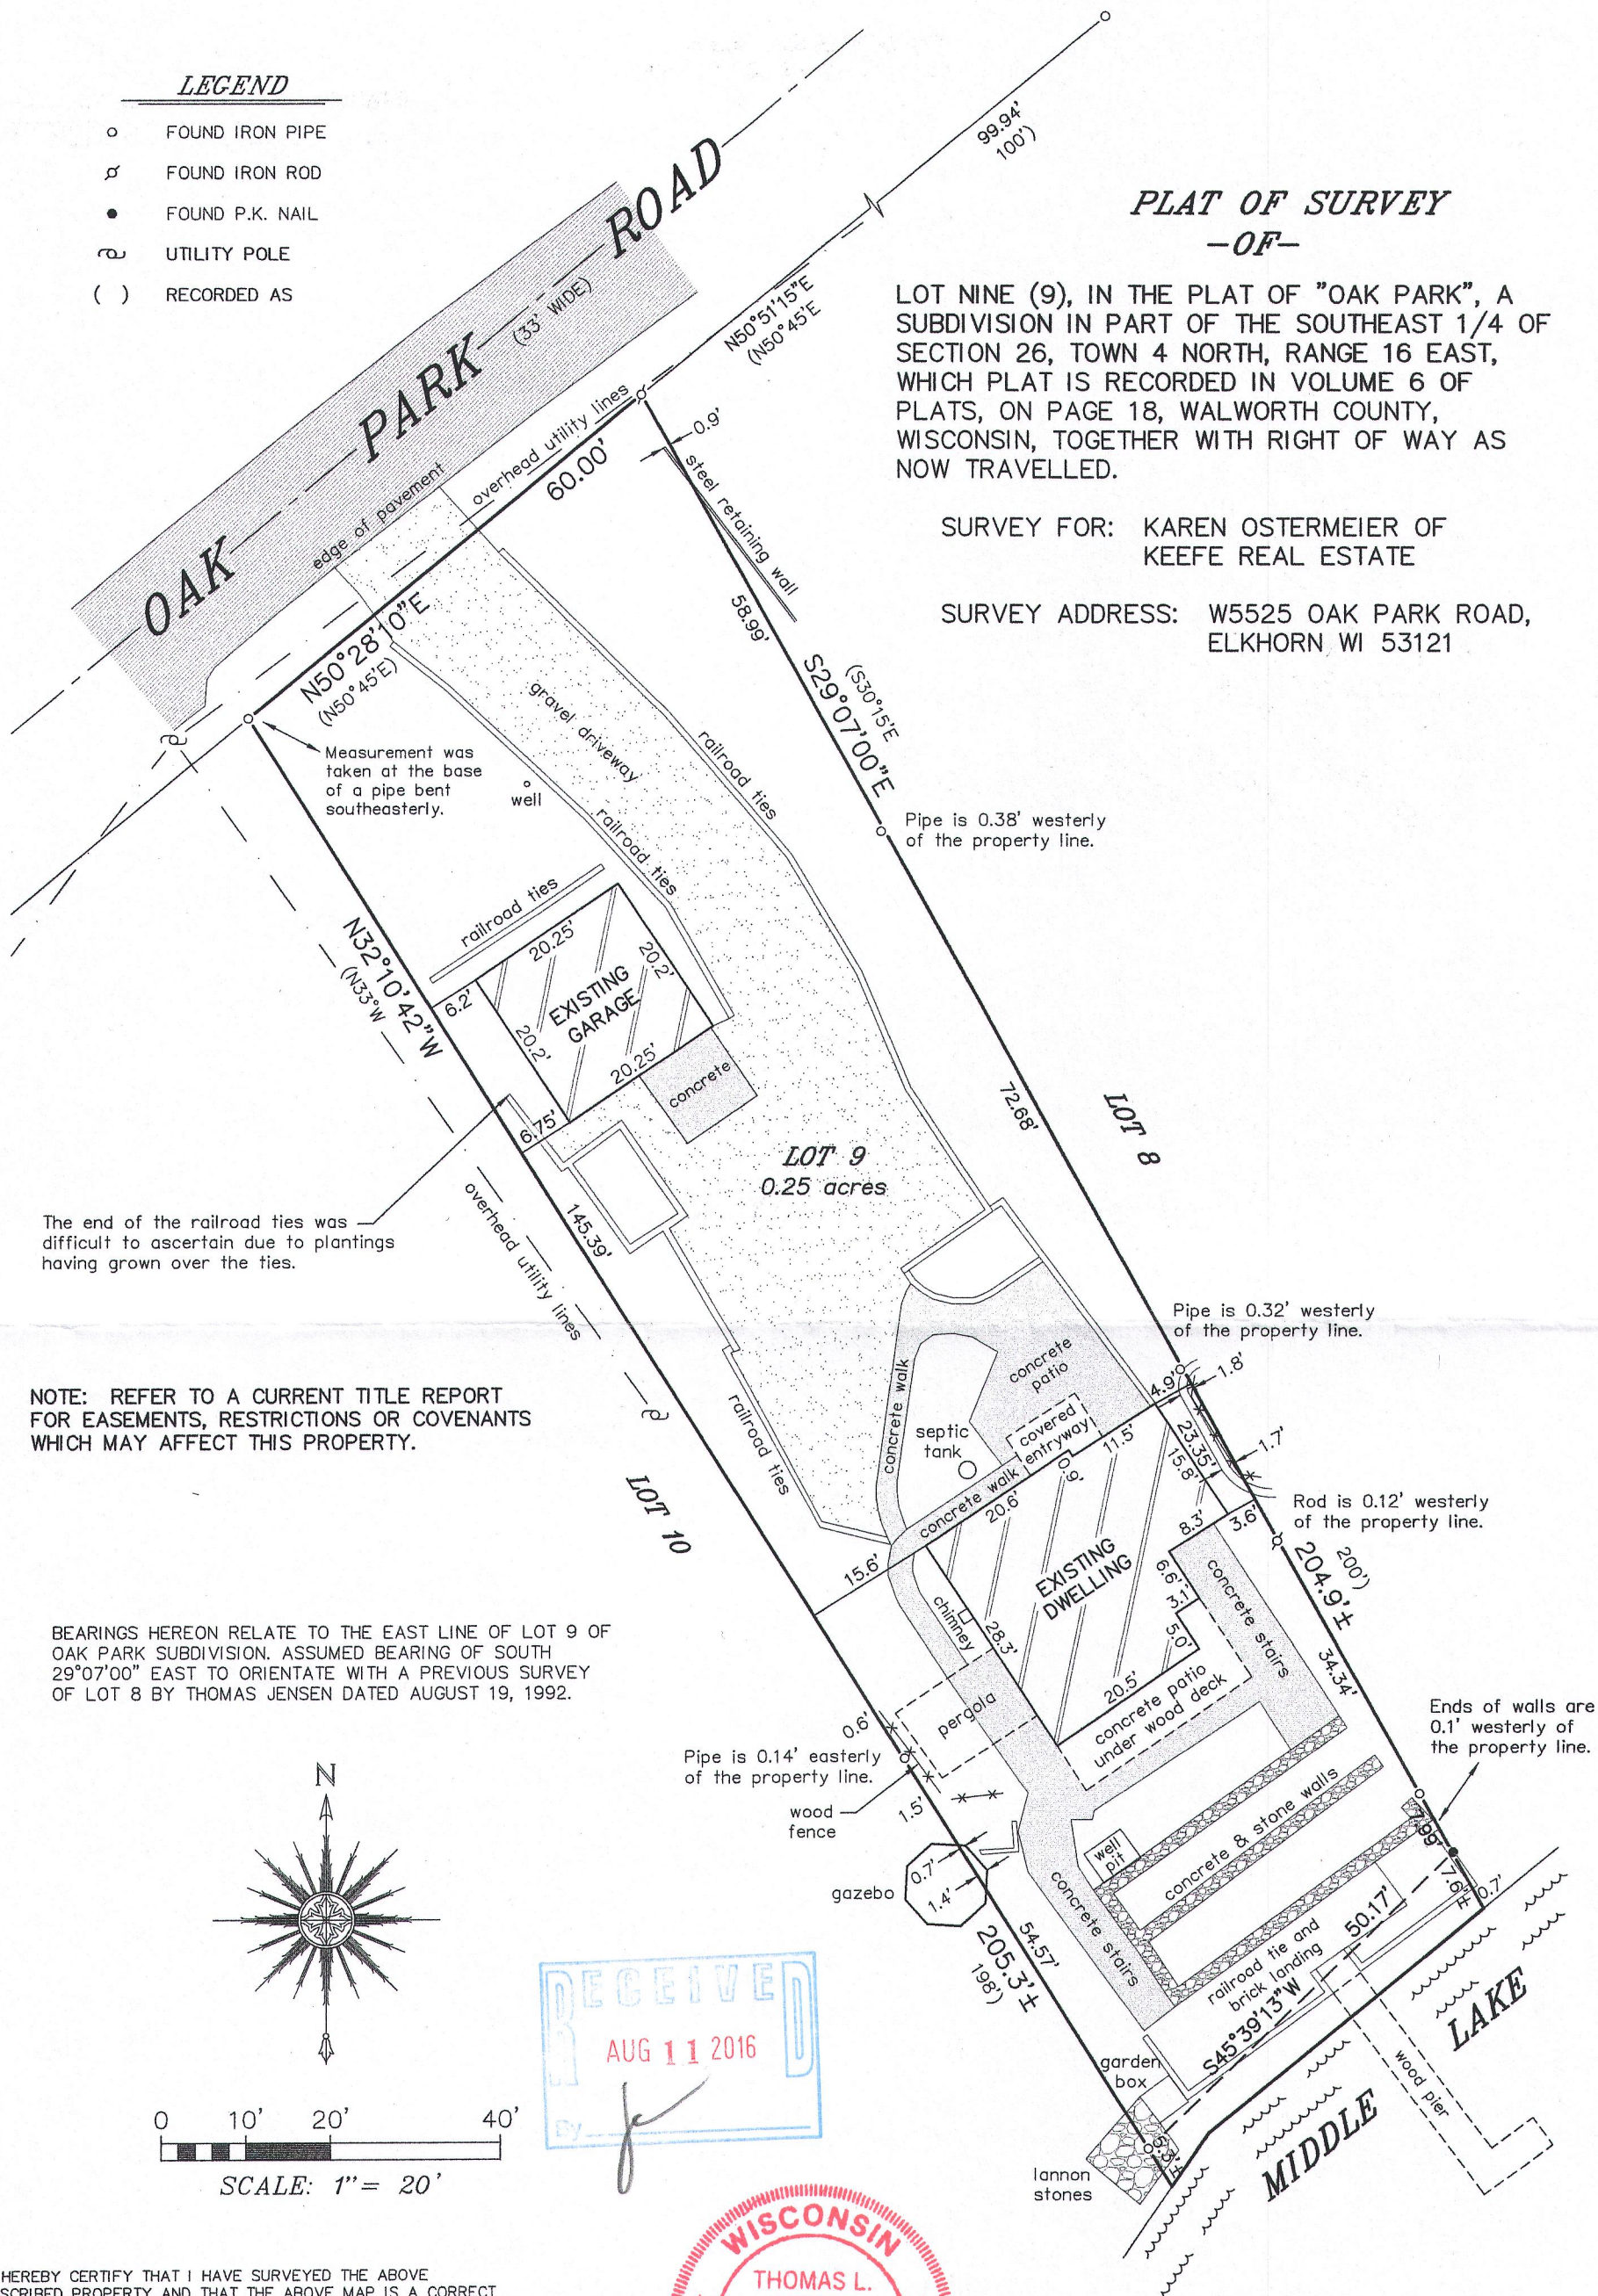


NOTE: REFER TO A CURRENT TITLE REPORT FOR EASEMENTS, RESTRICTIONS OR COVENANTS WHICH MAY AFFECT THIS PROPERTY.

BEARINGS HEREON RELATE TO THE EAST LINE OF LOT 9 OF OAK PARK SUBDIVISION. ASSUMED BEARING OF SOUTH 29°07'00" EAST TO ORIENTATE WITH A PREVIOUS SURVEY OF LOT 8 BY THOMAS JENSEN DATED AUGUST 19, 1992.

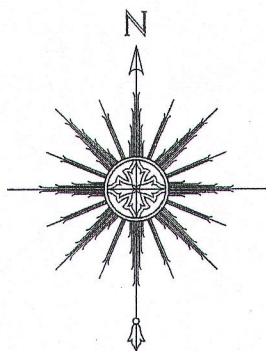

SCALE: 1" = 20'

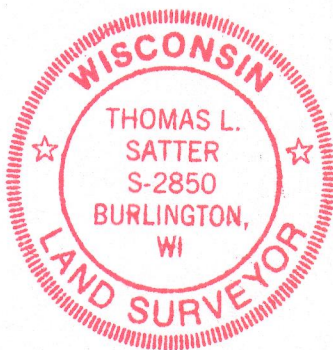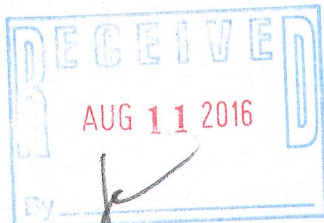

"I HEREBY CERTIFY THAT I HAVE SURVEYED THE ABOVE DESCRIBED PROPERTY AND THAT THE ABOVE MAP IS A CORRECT REPRESENTATION THEREOF AND SHOWS THE SIZE AND LOCATION OF THE PROPERTY, ITS EXTERIOR BOUNDARIES, THE LOCATION OF ALL VISIBLE STRUCTURES AND DIMENSIONS OF ALL PRINCIPAL BUILDINGS THEREON, BOUNDARY FENCES, APPARENT EASEMENTS, ROADWAYS AND ENCROACHMENTS, IF ANY."

"THIS SURVEY IS MADE FOR THE USE OF THE PRESENT OWNERS OF THE PROPERTY, AND THOSE WHO PURCHASE, MORTGAGE, OR GUARANTEE THE TITLE THERETO WITHIN ONE YEAR FROM DATE HEREOF."

SATTER SURVEYING, LLC
LAND SURVEYS, MAPPING AND PLANNING
272 ORIGIN STREET
BURLINGTON, WI 53105
262-661-4239

THIS IS NOT AN ORIGINAL PRINT
UNLESS THIS SEAL IS RED.

Thomas L. Satter
THOMAS L. SATTER S-2850

JULY 22, 2016
DATE

071609
JOB NUMBER