


SURVEY WITH HOUSE LOCATION  
OF LOT 14 OF ARROWHEAD PARK  
ADDITION NUMBER 1

LOCATED IN SECTION 35, T4N, R16E, WALWORTH COUNTY, WISCONSIN

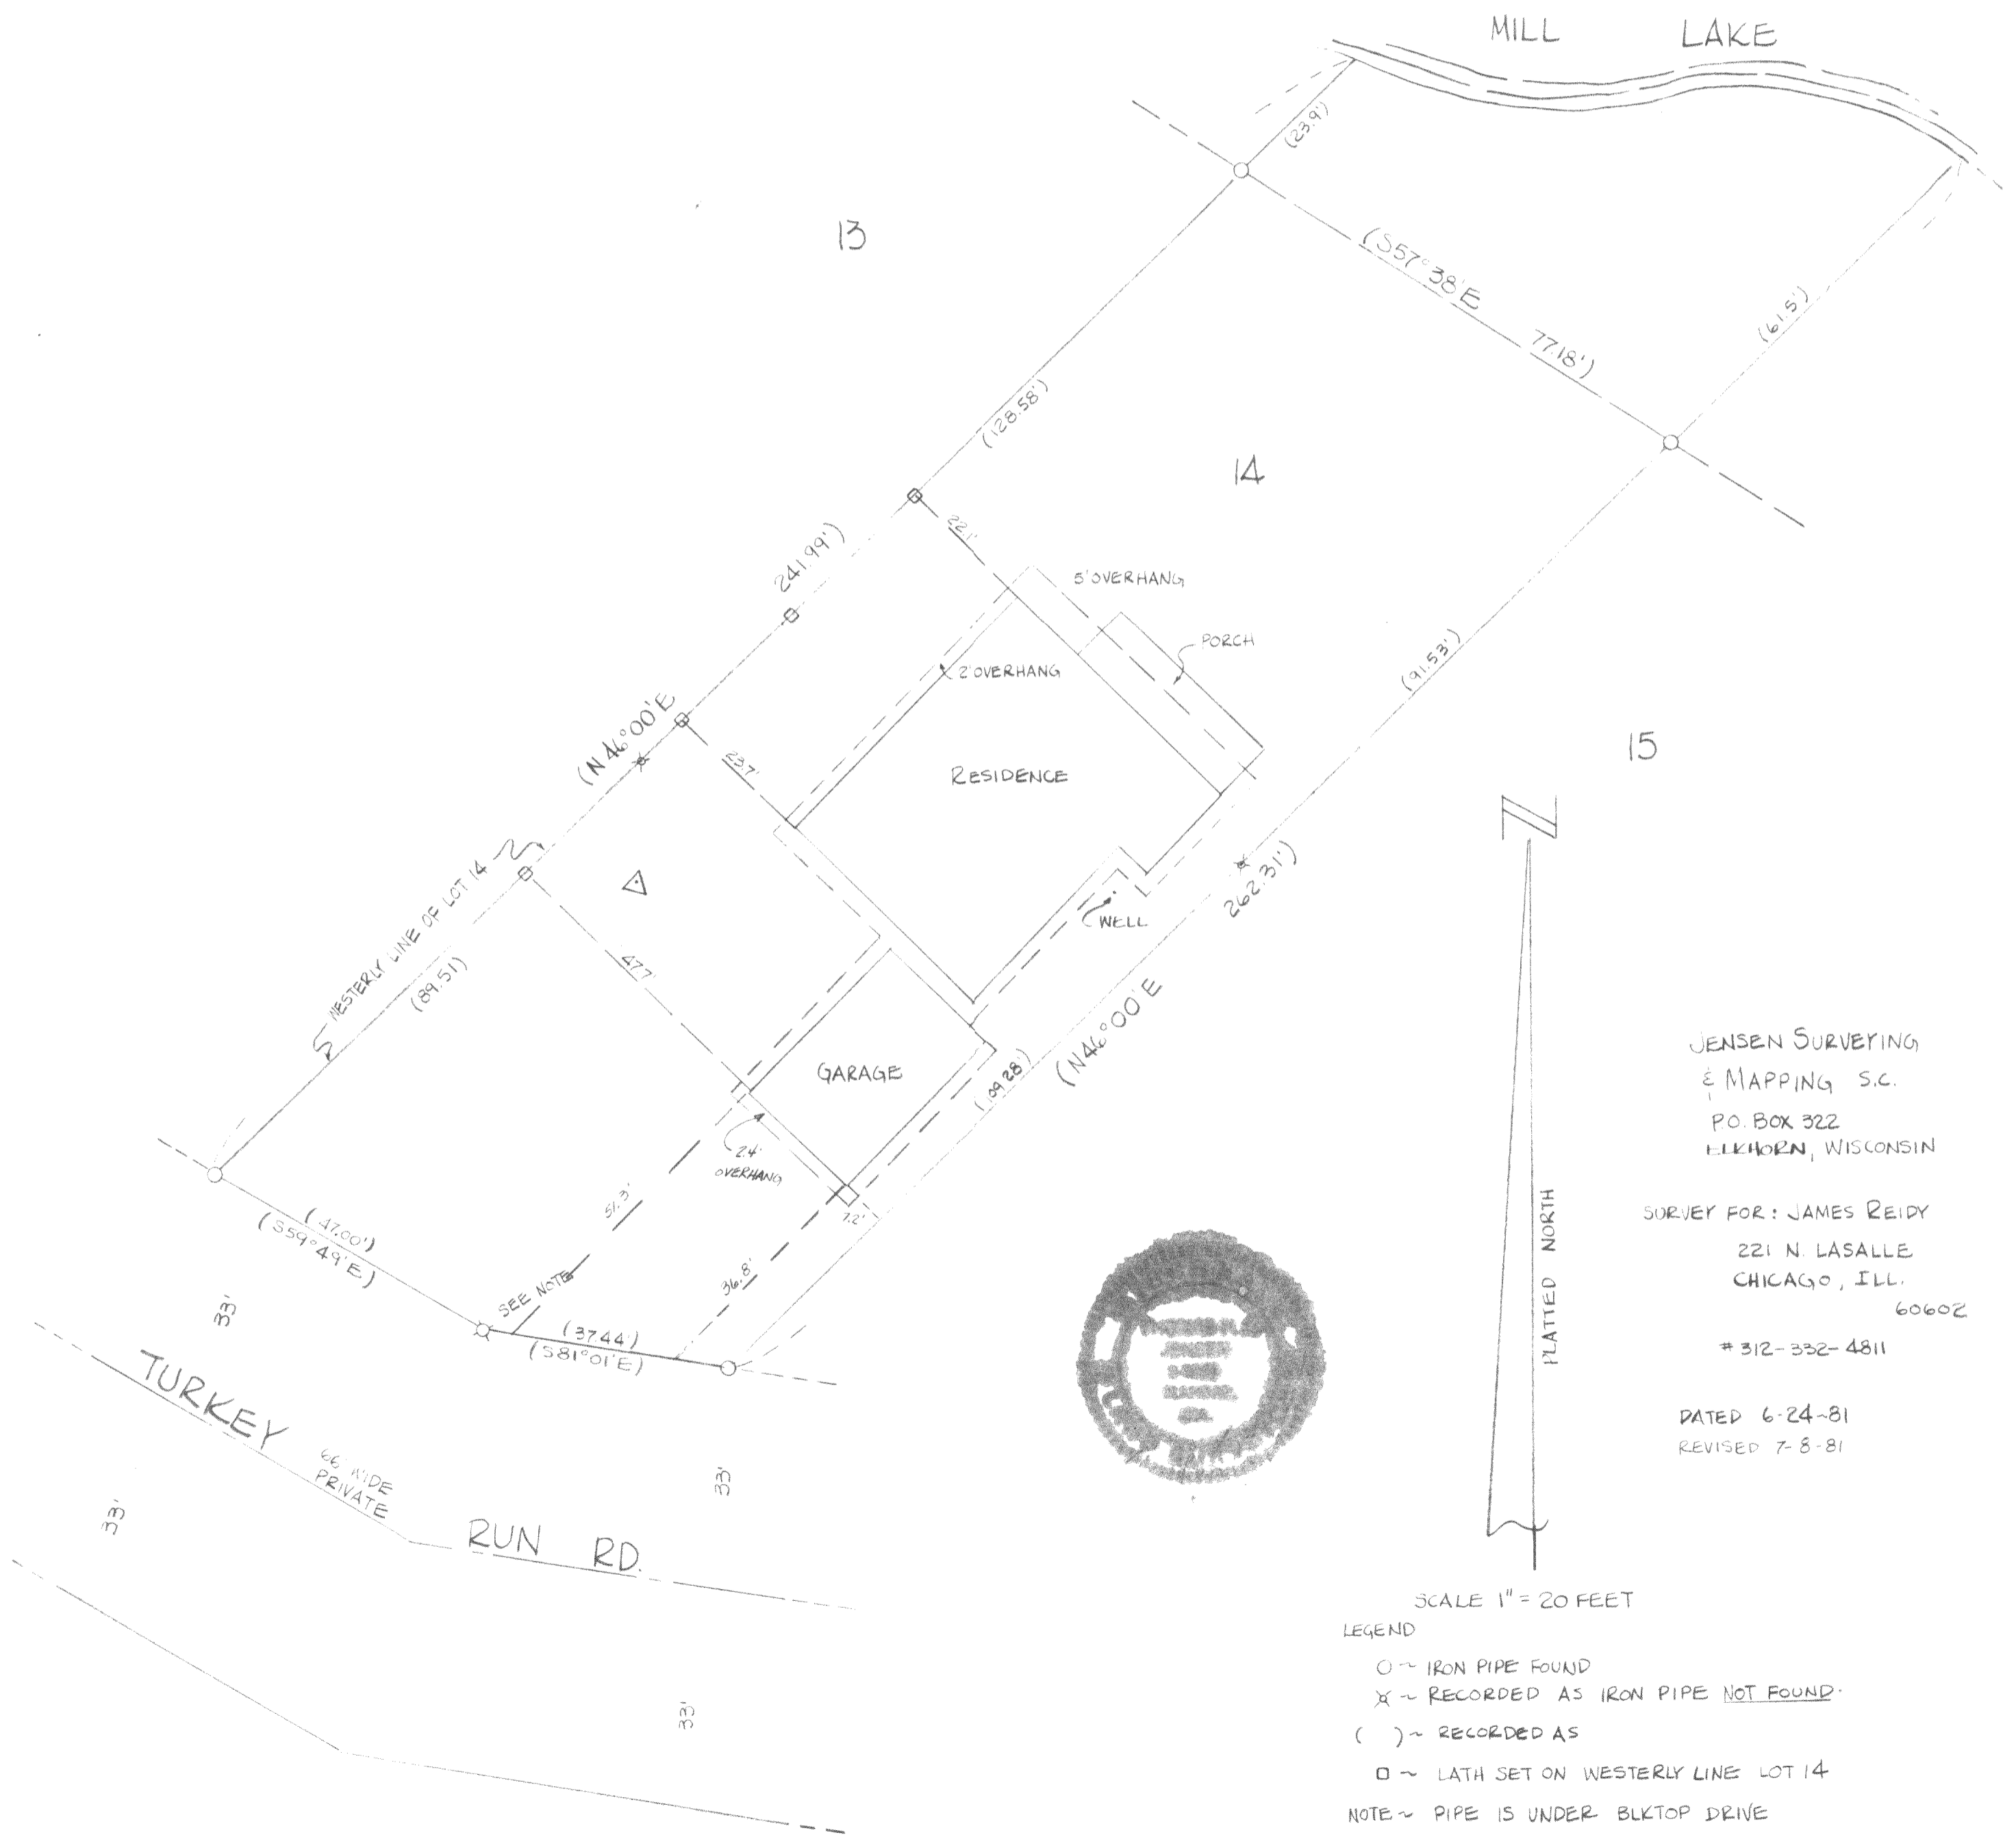


JENSEN SURVEYING  
& MAPPING S.C.  
P.O. BOX 322  
ELKHORN, WISCONSIN

SURVEY FOR: JAMES REIDY  
221 N. LASALLE  
CHICAGO, ILL.  
60602

# 312-332-4811

DATED 6-24-81  
REVISED 7-8-81

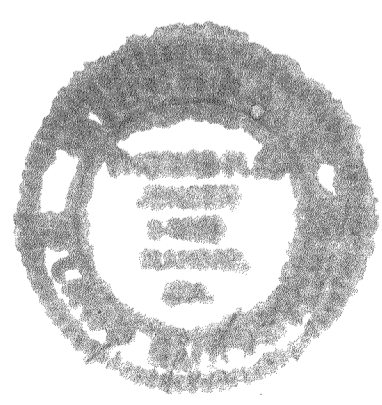

- SCALE 1" = 20 FEET
- LEGEND
- O ~ IRON PIPE FOUND
  - X ~ RECORDED AS IRON PIPE NOT FOUND
  - ( ) ~ RECORDED AS
  - ~ LATH SET ON WESTERLY LINE LOT 14
  - NOTE ~ PIPE IS UNDER BLKTOP DRIVE
  - △ ~ SEPTIC VENT STACK