


PLAT OF SURVEY LOT 23 AND EASTERLY 12' OF LOT 22 DROUGHTVILLE PARK

LOCATED IN THE NW 1/4 OF NW 1/4 OF SECTION 36 AND THE SW 1/4 OF SW 1/4 OF SECTION 25,
ALL IN TOWN 4 NORTH, RANGE 16 EAST, TOWN OF LAGRANGE, WALWORTH COUNTY, WISCONSIN



- LEGEND
- = FOUND IRON PIPE STAKE
 - = FOUND IRON REBAR STAKE
 - {XXX} = RECORDED AS

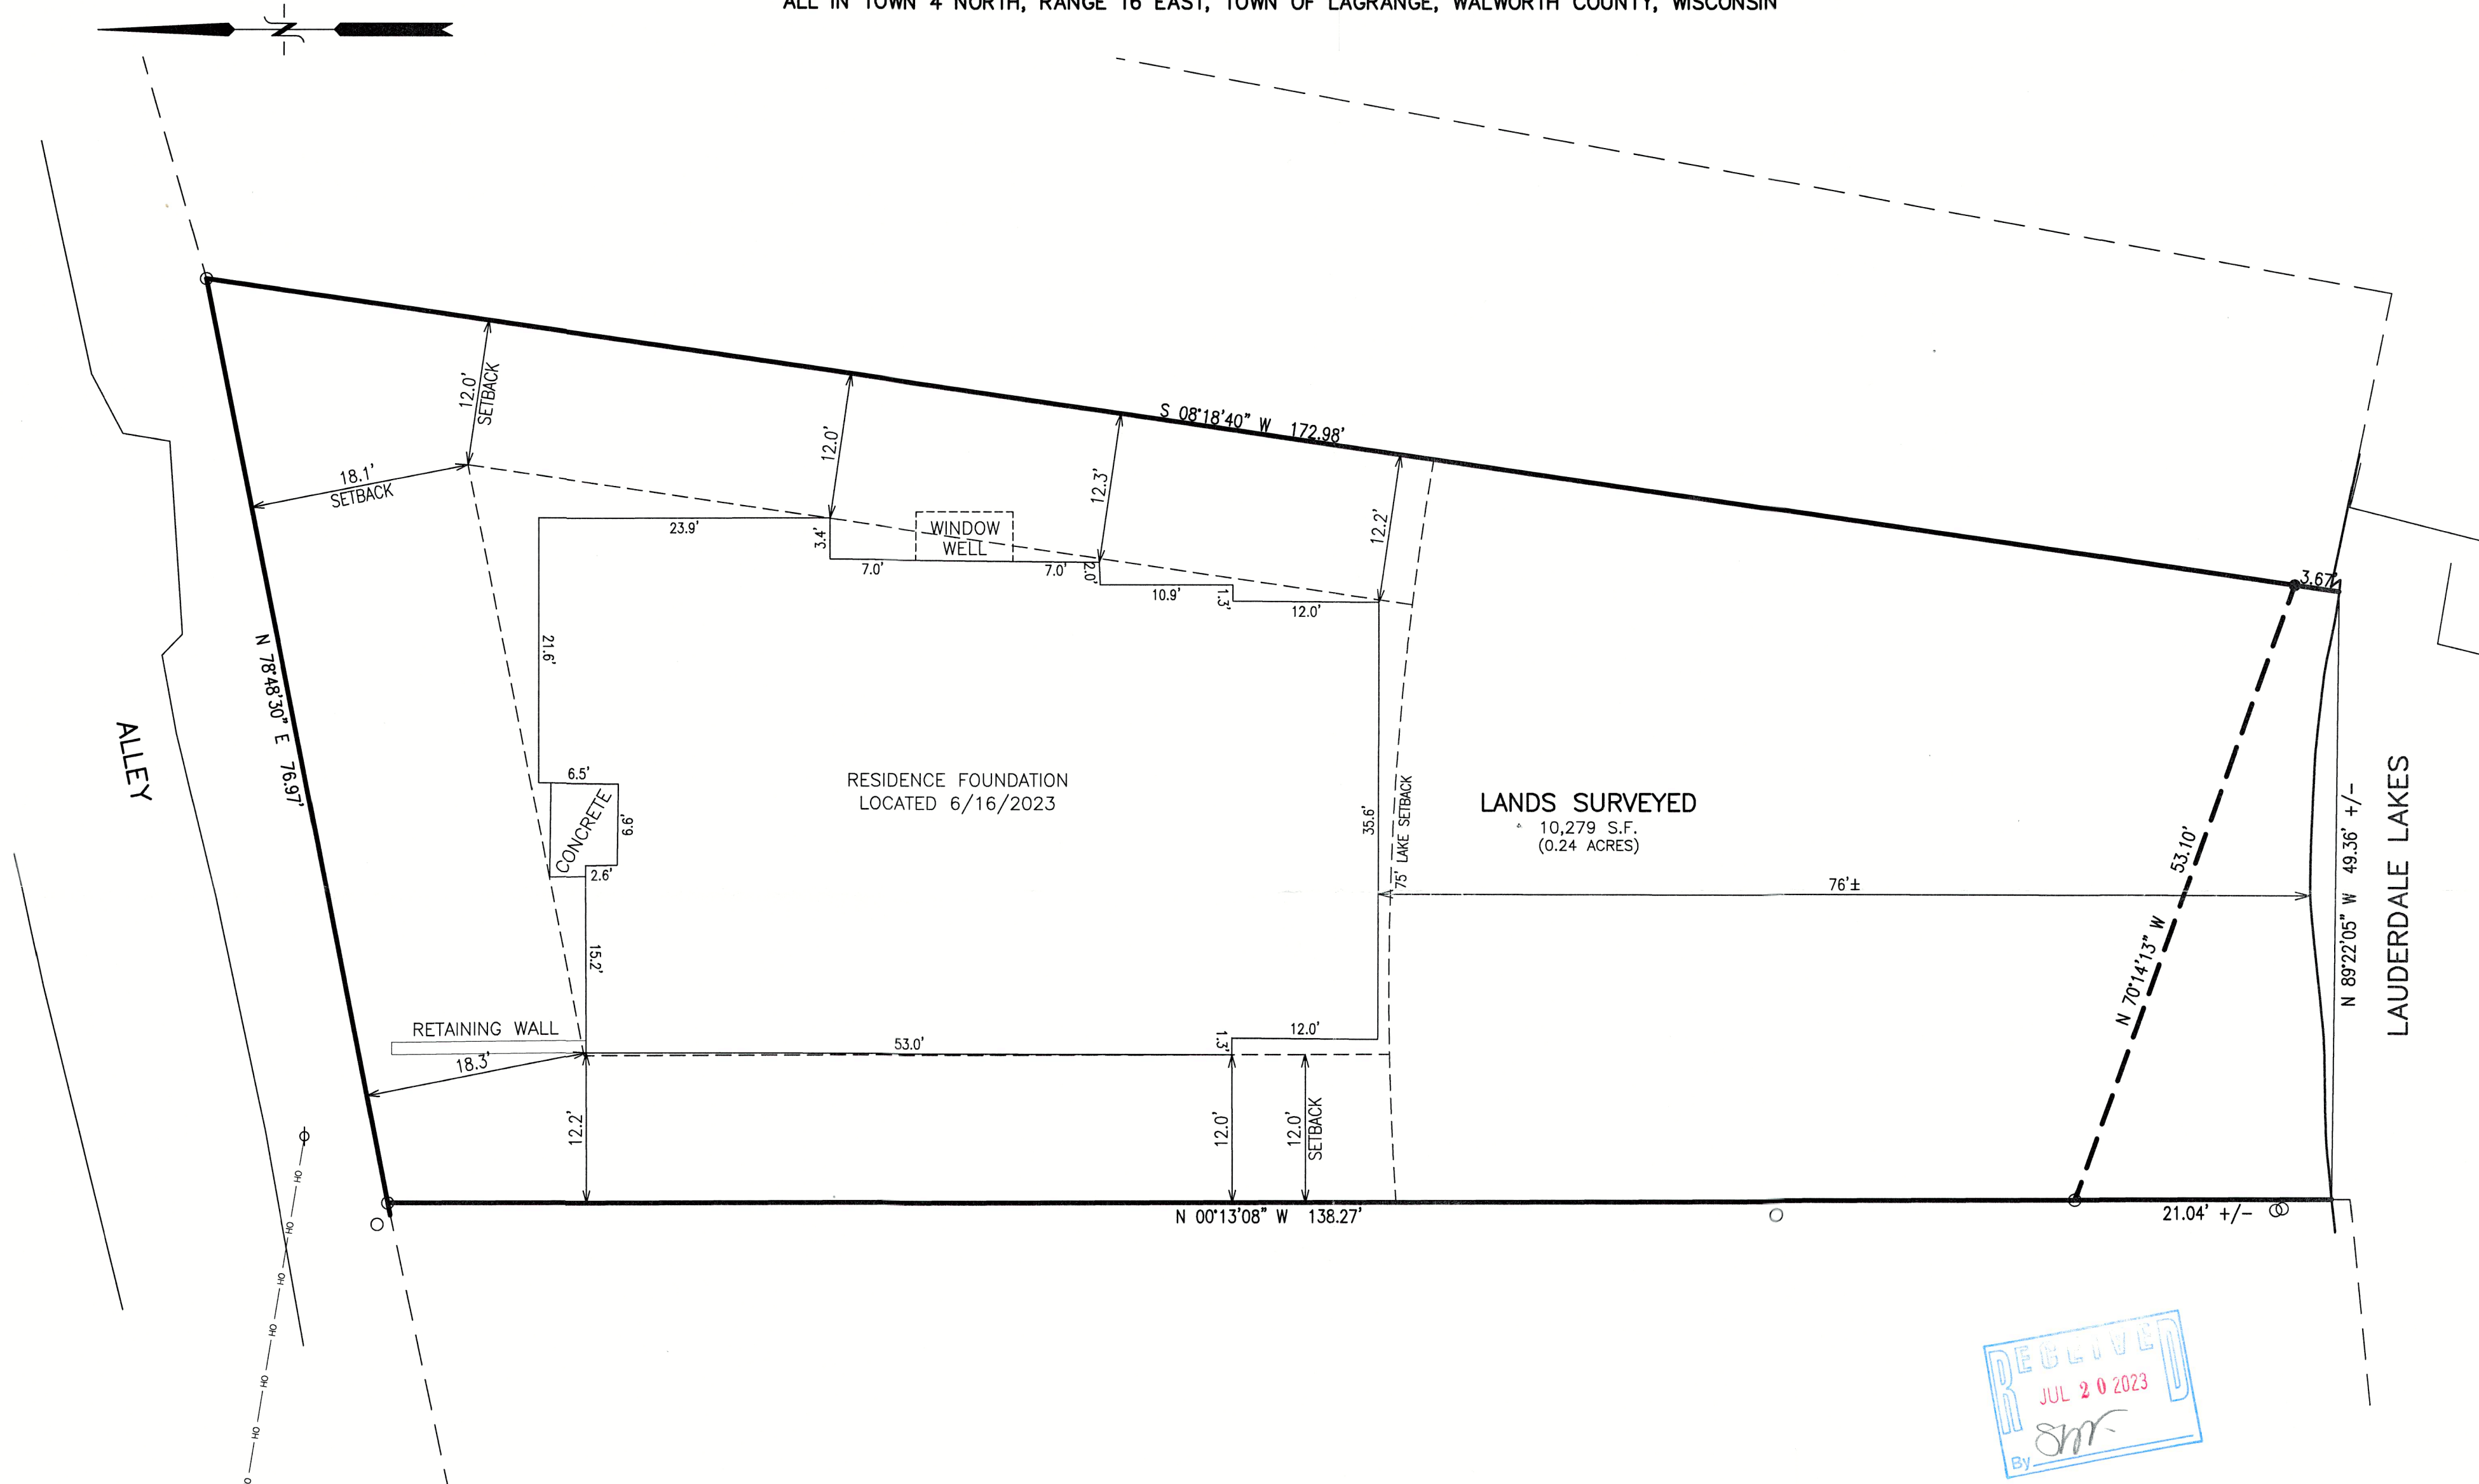


NOTE: COPIES OF THIS MAP TO WHICH THE FOLLOWING CERTIFICATE WILL APPLY
SHOW THE SURVEYOR'S ORIGINAL SEAL AND SIGNATURE IN RED INK. COPIES BY ANY
OTHER MEANS MAY HAVE ALTERATIONS WHICH DO NOT REPRESENT THE SURVEYOR'S
WORK PRODUCT.

I HEREBY CERTIFY THAT THE ABOVE DESCRIBED PROPERTY HAS BEEN SURVEYED
UNDER MY DIRECTION AND THAT THE ABOVE MAP IS A TRUE REPRESENTATION
THEREOF AND SHOWS THE SIZE AND LOCATION OF THE PROPERTY AND ITS EXTERIOR
BOUNDARIES. THIS SURVEY IS MADE FOR THE USE OF THE PRESENT OWNERS OF
THE PROPERTY, AND ALSO THOSE WHO PURCHASE, MORTGAGE, OR GUARANTEE THE
TITLE THERETO WITHIN ONE YEAR FROM THE DATE HEREOF.

DATED: 10/16/2022

REVISED 6/20/2023 TO SHOW
RESIDENCE FOUNDATION AS BUILT.

CHRISTOPHER A. HODGES P.L.S. 2760

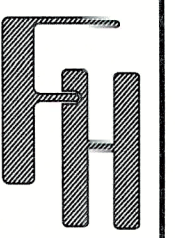

PLAT OF SURVEY
5219 STEWART DRIVE
TOWN OF LAGRANGE, WI

WORK ORDERED BY -
THELEN TOTAL CONSTRUCTION, INC
ELKHORN, WISCONSIN

FARRIS, HANSEN & ASSOCIATES, INC.
ENGINEERING - ARCHITECTURE - SURVEYING
7 RIDGWAY COURT P.O. BOX 437
ELKHORN, WISCONSIN 53121
OFFICE: (262) 723-2098 FAX: (262) 723-5886

REVISIONS

PROJECT NO.
9067.22
DATE:
10/16/22
SHEET NO.
1 OF 1

X:\PROJECTS\9067\9067_22\ACAD\9067_22 As Built.dwg

HDP-23B

416-3437