
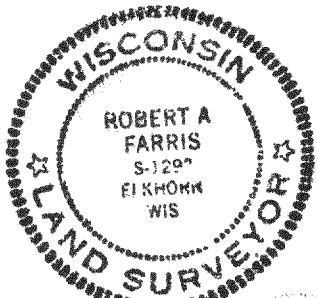
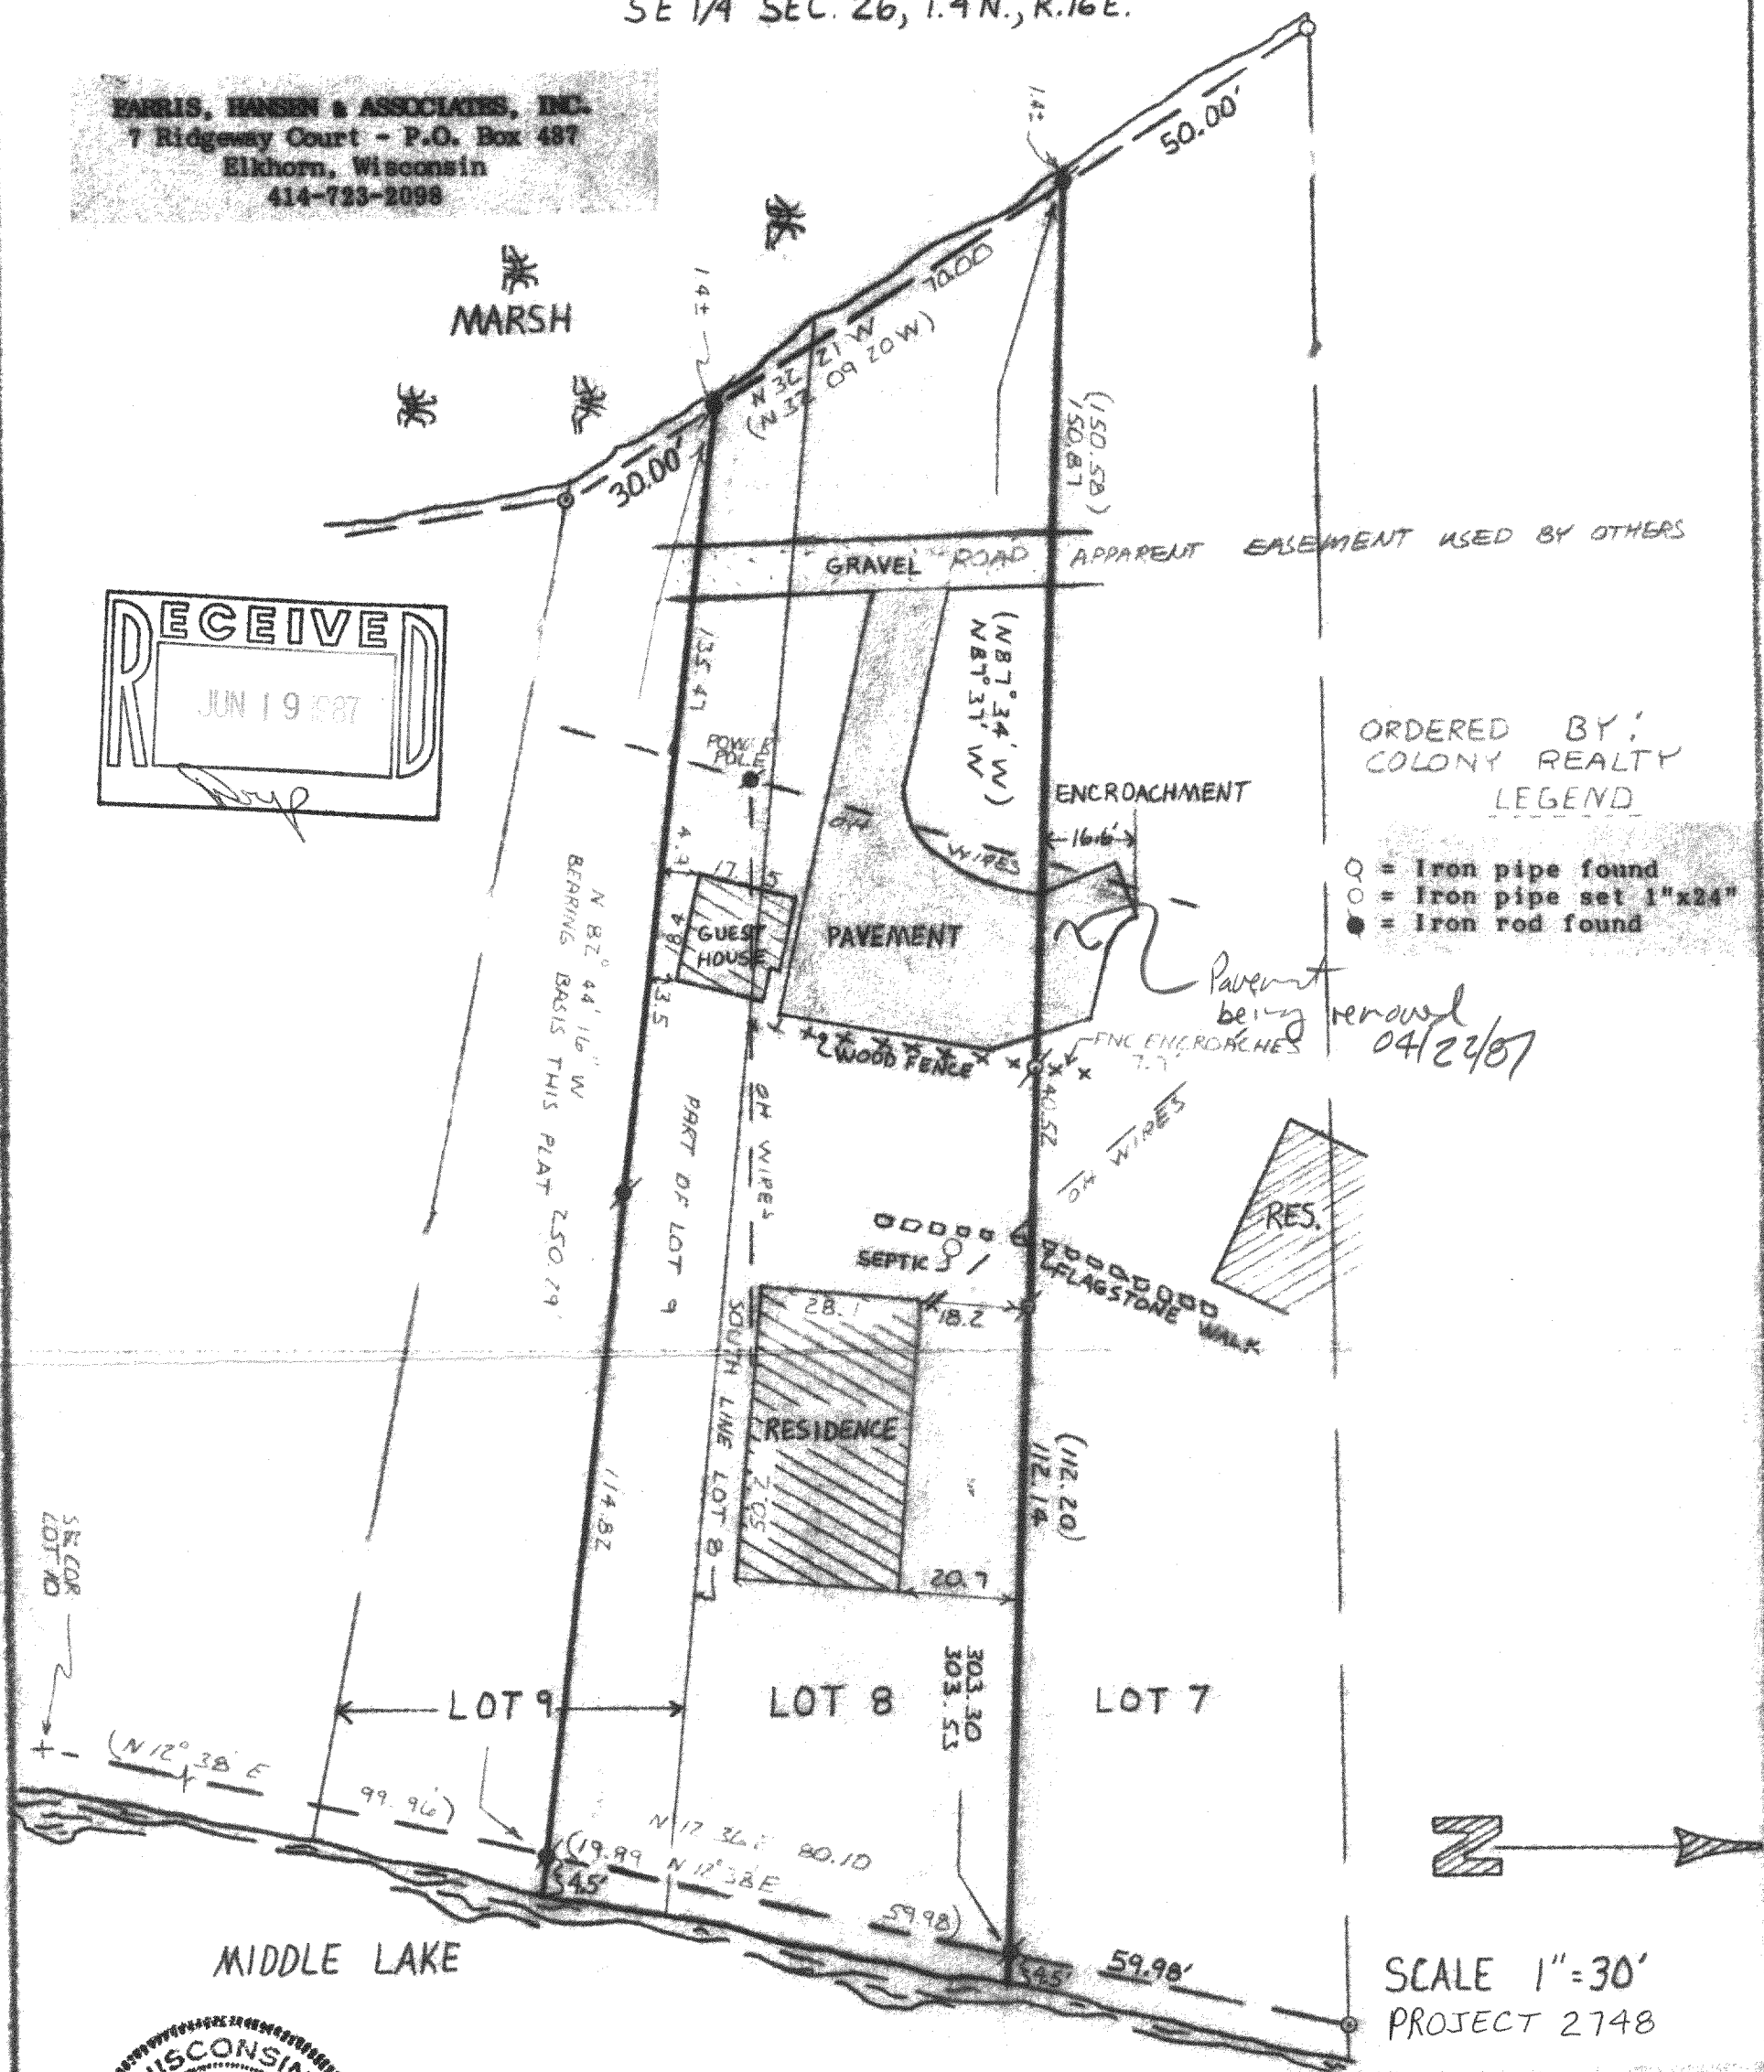


FARRIS, HANSEN & ASSOCIATES, INC.
7 Ridgeway Court - P.O. Box 487
Elkhorn, Wisconsin
414-723-2098

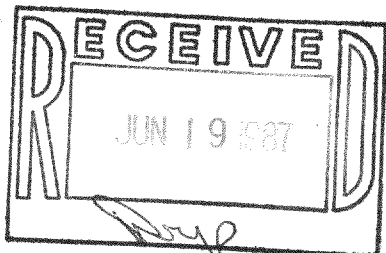

I hereby certify that I have surveyed the above described property and that the above map is a true representation thereof and shows the size and location of the property, its exterior boundaries, the location of all visible structures and dimensions of all principal buildings thereon, boundary fences, apparent easements, roadways and visible encroachments, if any. This survey is made for the use of the present owners of the property, and also those who purchase, mortgage, or guarantee the title thereto within one (1) year from the date hereof.

Robert M. Jarvis

DATED THIS 26 DAY OF MAR 1987

Lot 8 in the Plat of Ingleside Point, located in section 26, Town 4 North, Range 16 East, Town of LaGrange, Walworth County, Wisconsin according to the plat thereof recorded in Volume 5 of Plats on pages 151 and 152, and also that part of Lot 9 in said Ingleside Point described as follows: Commencing at an iron rod on a meander line at the Southeast corner of Lot 10 of said Ingleside Point, said iron rod located North 75deg. 00min. West 8.20 feet more or less from the shore of Middle Lake; thence North 12deg. 38min. East 99.96 feet to an iron rod and the place of beginning; thence North 82deg. 44min. 16sec. West 250.29 feet to an iron rod on a meander line, said rod is located South 82deg. 44min. 16sec. East 1.4 feet more or less from a marsh; thence Northwesterly along said meander line 20.00 feet more or less to a point on the South line of Lot 8 of Ingleside Point; thence Easterly along the South line of said Lot 8 to a point on the meander line located 19.99 feet North 12deg. 38min. East from the place of beginning; thence South 12deg. 38min. West 19.99 feet to the place of beginning, also all of the land between the above described meander line and the shore of Middle Lake on the East and the marsh on the West.