


BOUNDARY & TOPOGRAPHIC SURVEY SITE GRADING, DRAINAGE & EROSION CONTROL PLAN LOCATED IN SECTION 26, TOWN 4 NORTH, RANGE 16 EAST, WALWORTH COUNTY, WISCONSIN

3. The land referred to in the Commitment is described as follows:


Commencing at the NE corner of Lot 22, of Block 2, Green Lake Park, a subdivision located in Section 26, T4N, R16E, Walworth County, Wisconsin, thence S 48° 45' E 39.90 feet to an iron stake, thence S 64° 56' E 40.00 feet to an iron stake, thence S 78° 01' E 65.00 feet to an iron stake, thence N 88° 14' E 110.17 feet to an iron stake, thence S 72° 23' E 42.65 feet to an iron stake, thence S 63° 39' E 35.50 feet to an iron stake, thence S 22° 28' E 78.07 feet to an iron stake, thence S 2° 07' W 141.62 feet to an iron stake, thence S 0° 19' E 141.79 feet to an iron stake to the place of beginning of this description; thence S 00° 03' 27" E 72.20 feet; thence S 47° 52' 33" W 101.20 feet; thence N 59° 10' 17" W 178.04 feet to the shore of Green Lake; thence E and N along said shore line 50.00 feet more or less; thence S 89° 46' 32" E 195.62 feet to the place of beginning.

Tax Key Number: HGP 00018J

PROPERTY ADDRESS:
LL865 WEST SHORE DRIVE
TOWN OF LAGRANGE

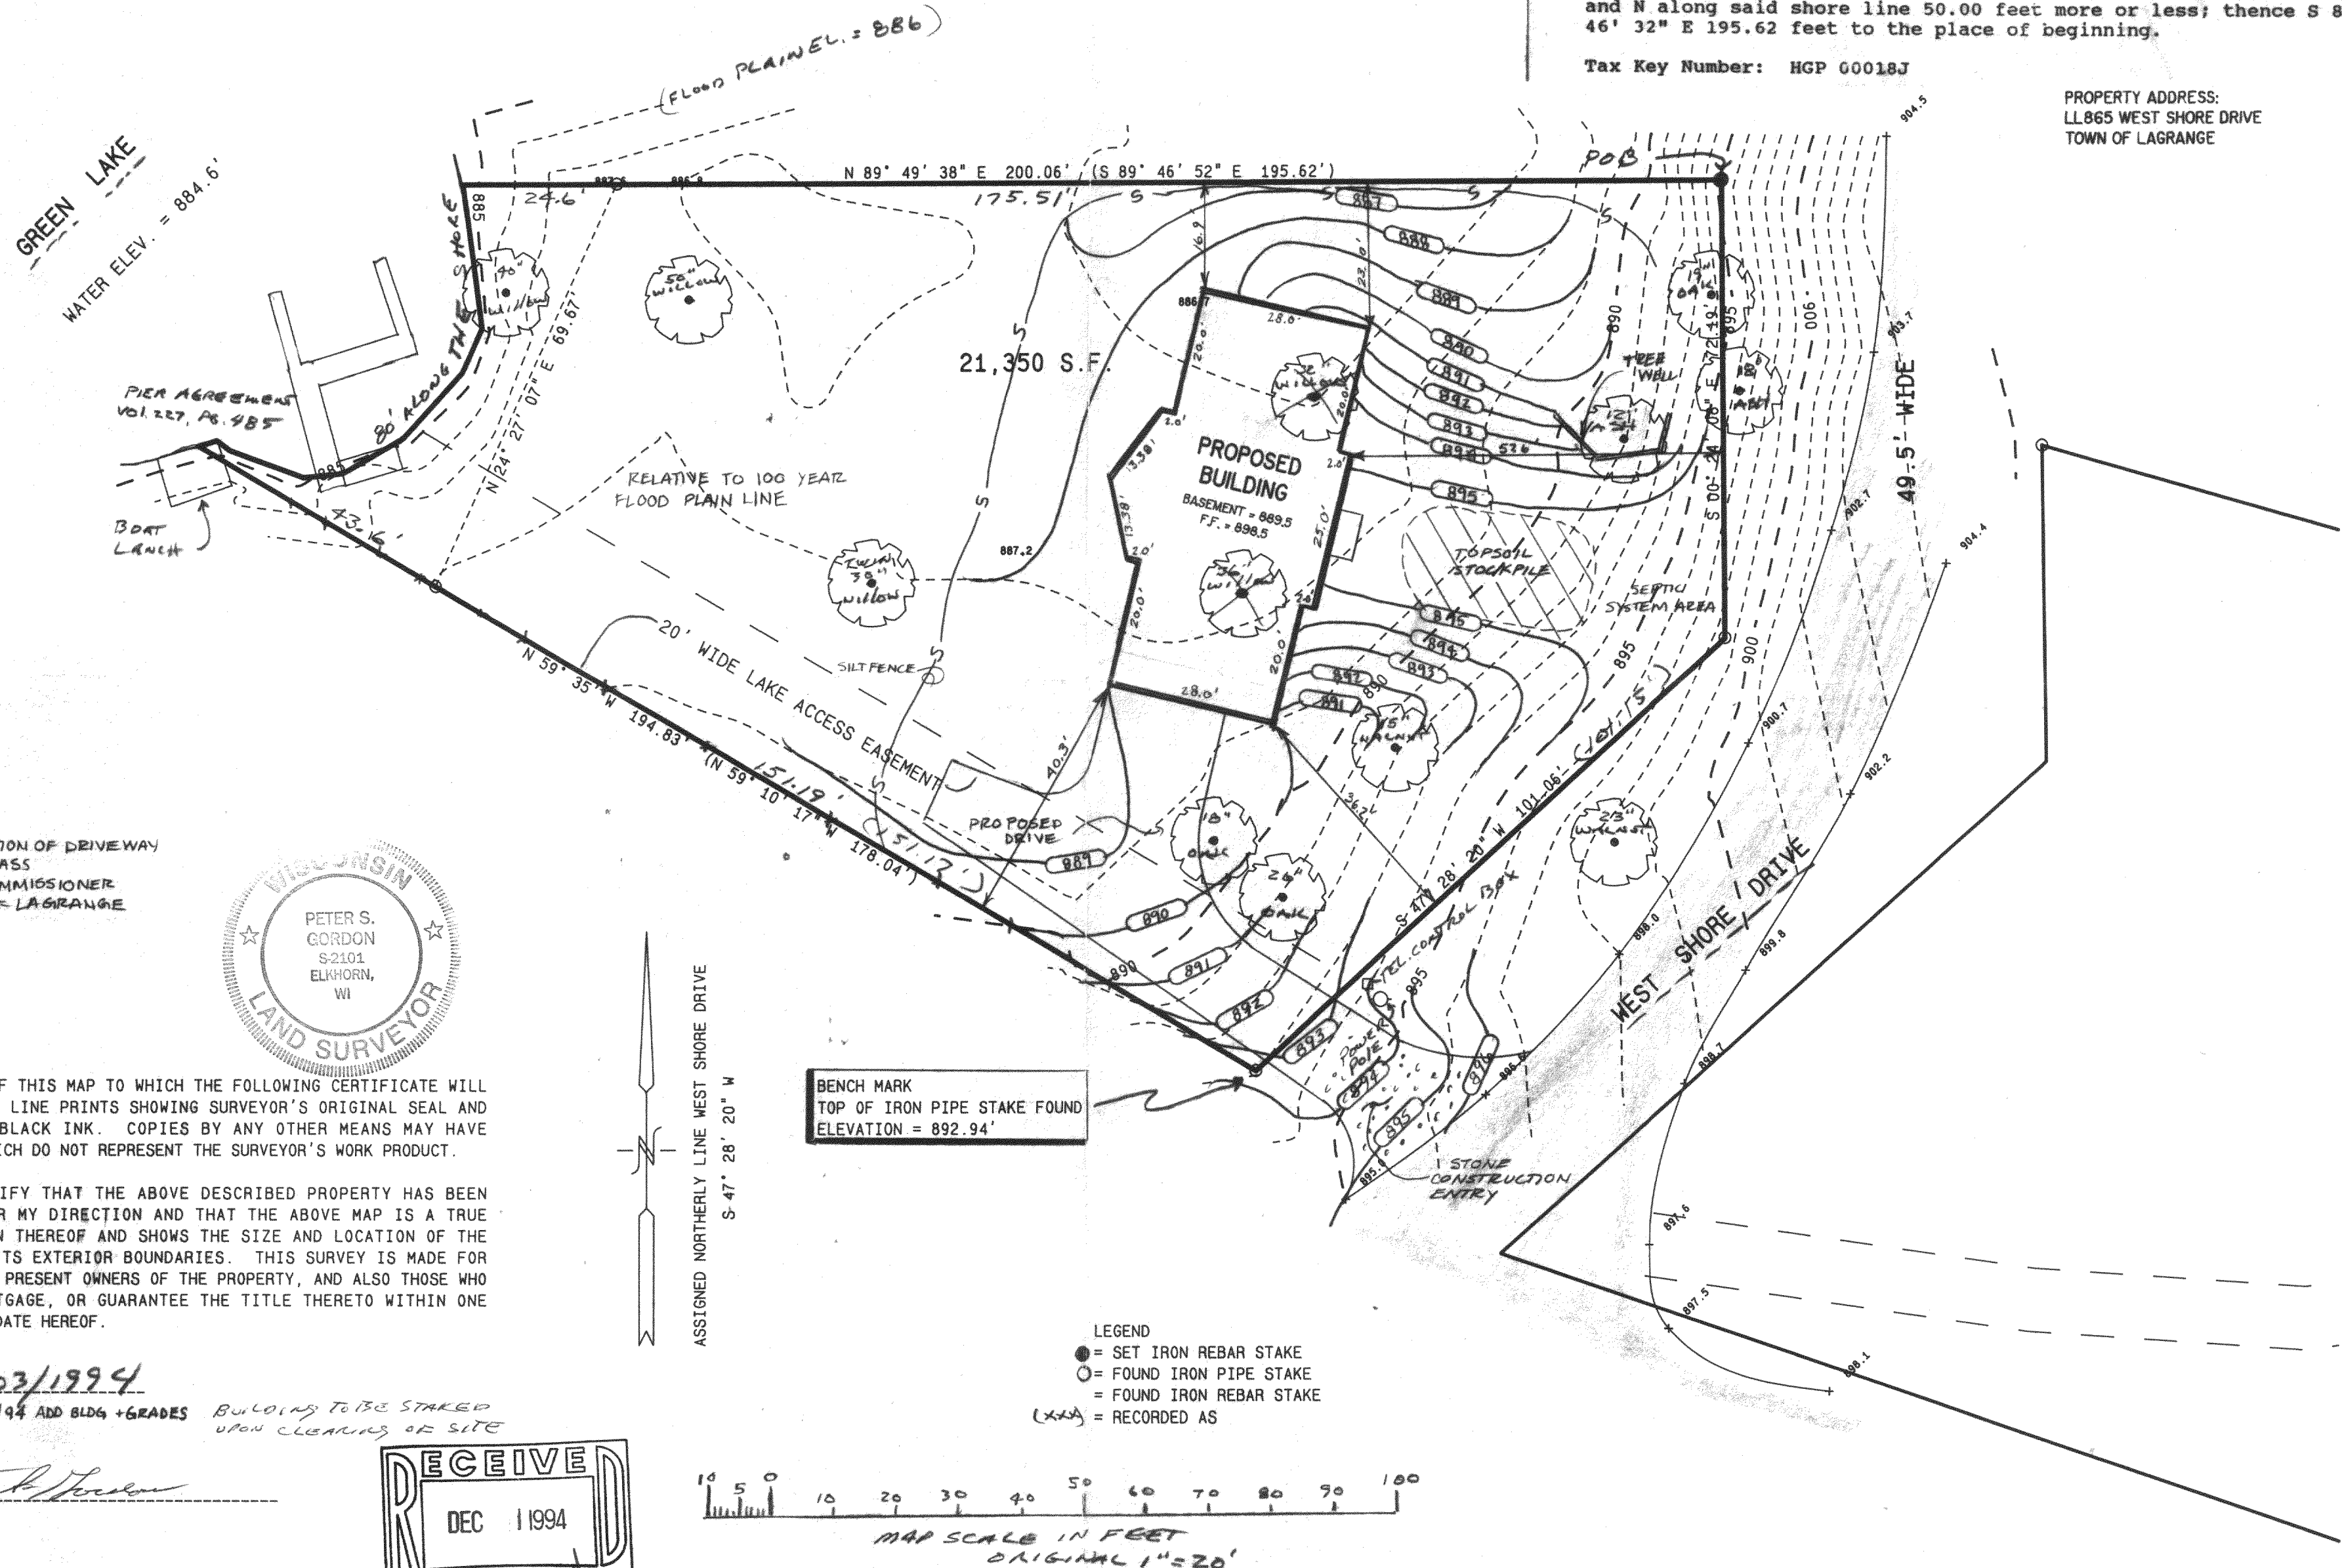

NOTE: RELOCATION OF DRIVEWAY
CHUCK WASS
HWY COMMISSIONER
TOWN OF LAGRANGE

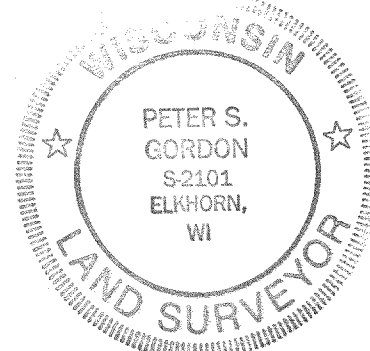



NOTE: COPIES OF THIS MAP TO WHICH THE FOLLOWING CERTIFICATE WILL
APPLY ARE BLUE LINE PRINTS SHOWING SURVEYOR'S ORIGINAL SEAL AND
SIGNATURE IN BLACK INK. COPIES BY ANY OTHER MEANS MAY HAVE
ALTERATIONS WHICH DO NOT REPRESENT THE SURVEYOR'S WORK PRODUCT.

I HEREBY CERTIFY THAT THE ABOVE DESCRIBED PROPERTY HAS BEEN
SURVEYED UNDER MY DIRECTION AND THAT THE ABOVE MAP IS A TRUE
REPRESENTATION THEREOF AND SHOWS THE SIZE AND LOCATION OF THE
PROPERTY AND ITS EXTERIOR BOUNDARIES. THIS SURVEY IS MADE FOR
THE USE OF THE PRESENT OWNERS OF THE PROPERTY, AND ALSO THOSE WHO
PURCHASE, MORTGAGE, OR GUARANTEE THE TITLE THERETO WITHIN ONE
YEAR FROM THE DATE HEREOF.

DATED: 08/03/1994

REVISIONS: 10/24/94 ADD BLDG + GRADES BUILDING TO BE STAKED
UPON CLEARING OF SITE

[Signature]

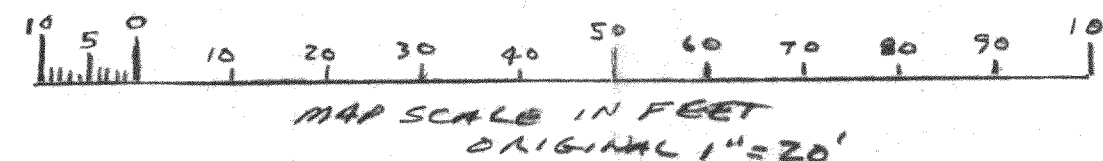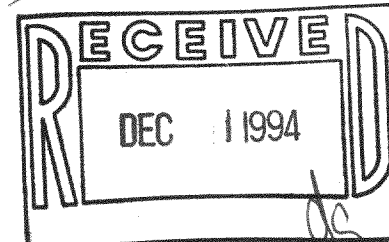

OWNER: MR. & MRS. JOE B. WAYLAND
1480 MORGAN DRIVE
ELK GROVE VILLAGE, IL 60007
708-893-5337

WORK ORDERED BY: L. G. ROYAL
POINTE CONSTRUCTION CO.
507 N. BROAD ST. SUITE 127
LAKE GENEVA, WI. 414-248-6509

FARRIS, HANSEN & ASSOCIATES, INC.
Engineering, Architecture, Surveying
7 Ridgeway Court, P.O. Box 437
ELKHORN, WISCONSIN 53121
Office: (414) 723-2098
Fax: (414) 723-5886

REVISIONS

PROJECT NO.
4125
DATE
08-03-94
SHEET NO.
1 OF 1

HGP-18J

416-1066