

FARRIS, HANSEN & ASSOCIATES, INC.

ENGINEERING, ARCHITECTURE, SURVEYING

7 RIDGWAY COURT - P.O. BOX 437, ELKHORN, WISCONSIN 53121

PHONE: (414) 723-2098 FAX: (414) 723-5886


PLAT OF SURVEY

LOT 1 OF CERTIFIED SURVEY NO. 26, RECORDED AUGUST 8, 1967, AS DOCUMENT NO. 594059 IN THE OFFICE OF THE REGISTER DEEDS IN AND FOR WALWORTH COUNTY, WISCONSIN

- LEGEND
- = FOUND IRON PIPE STAKE
 - = FOUND IRON PIPE STAKE
 - ⊕ = SANITARY SYSTEM VENT
 - (xxx) = RECORDED AS
 - = POWER POLE

WORK ORDERED BY: MICHAEL BEST & FRIEDRICH
100 E. WISCONSIN, SUITE 3100
MILWAUKEE, WISCONSIN 53202
FOR KENNETH & SARA BLAIR

ASSIGNED SOUTH LINE LOT 1
N 55° 00' W
PER RECORD CSM

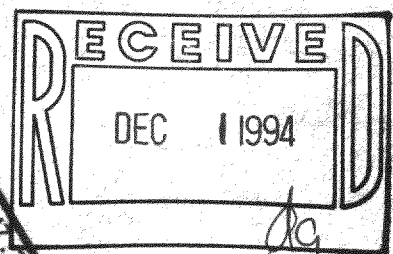

LOT 2 CSM 26



MAP SCALE IN FEET
ORIGINAL 1" = 20'

NOTE: COPIES OF THIS MAP TO WHICH THE FOLLOWING CERTIFICATE WILL APPLY ARE BLUE LINE PRINTS SHOWING SURVEYOR'S ORIGINAL SEAL AND SIGNATURE IN BLACK INK. COPIES BY ANY OTHER MEANS MAY HAVE ALTERATIONS WHICH DO NOT REPRESENT THE SURVEYOR'S WORK PRODUCT.

I HEREBY CERTIFY TO KENNETH M. AND SARA G. BLAIR; THAT THE ABOVE DESCRIBED PROPERTY HAS BEEN SURVEYED UNDER MY DIRECTION AND THAT THE ABOVE MAP IS A TRUE REPRESENTATION THEREOF AND SHOWS THE SIZE AND LOCATION OF THE PROPERTY, ITS EXTERIOR BOUNDARIES, THE LOCATION OF ALL VISIBLE STRUCTURES, AND DIMENSIONS OF ALL PRINCIPLE BUILDINGS THEREON, BOUNDARY FENCES, APPARENT EASEMENTS, ROADWAYS, AND VISIBLE ENCROACHMENTS, IF ANY. THIS SURVEY IS MADE FOR THE USE OF THE PRESENT OWNERS OF THE PROPERTY, AND ALSO THOSE WHO PURCHASE, MORTGAGE, OR GUARANTEE THE TITLE THERETO WITHIN ONE YEAR FROM THE DATE HEREOF.

DATED: 11/30/1994

PETER S. GORDON RLS 2101

HA-26-1

416-1067

PROJ 1745.94