
PLAT OF SURVEY -OF-

LOT 105, MARINER HILLS SUBDIVISION, located in the Northwest 1/4 of the Southwest 1/4, the Southwest 1/4 of the Southwest 1/4, the Southeast 1/4 of the Southwest 1/4 and the Southwest 1/4 of the Southeast 1/4of Section 34, Township 4 North, Range 16 East in the Town of La Grange, Walworth County, Wisconsin.

Survey For: Hackbarth Builders



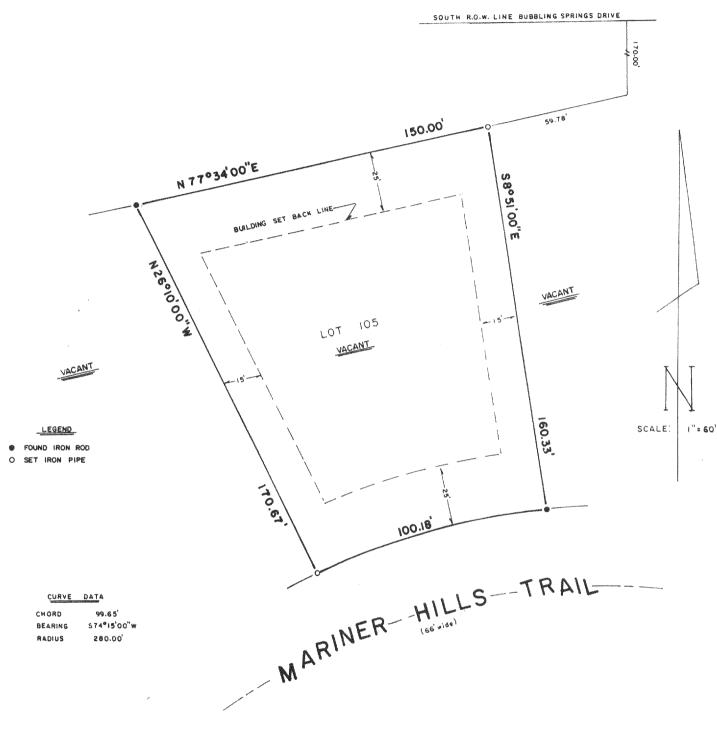

B.W. SURVEYING

Land Surveys Mapping And Planning 425 Milwaukee Avenue Burlington, WI 53105 (414) 767-0225





THIS IS NOT AN ORIGINAL PRINT UNLESS THIS SEAL IS RED

ROBERT J. WETZE

"I hereby certify that I have surveyed the above described property and that the above map is a true representation thereof and shows the size and location of the property, its exterior boundaries, the location of all visible structures and dimensions of all principal buildings thereon, boundary fences, apparent easements, roadways and encroachments, if any."

"This survey is made for the use of the present owners of the property, and those who purchase, mortgage, or guarantee the title thereto within one year from the date hereof."

19620 JOB NUMBER 411-1149

REGISTERED LAND SURVEYOR - 1778

2/28/95 DATE

4114-105