FARRIS, HANSEN & ASSOCIATES, INC. ENGINEERING, ARCHITECTURE, SURVEYING 7 RIDGWAY COURT - P.O.BOX 437, ELKHORN, WISCONSIN 53121 PHONE: (414) 723-2098 FAX: (414) 723-5886

PLAT OF SURVEY

LOT 52 CALI ACRES


LOCATED IN SEC. 25, T 4 N, R 16 E WALWORTH COUNTY, WISCONSIN

WORK ORDERED BY: WES ERSKINE ERSKINE CONSTRUCTION 715 W. WALWORTH ST. ELKHORN, WI. 53121

LOT 51

■ = FOUND IRON REBAR STAKE

LOT 46

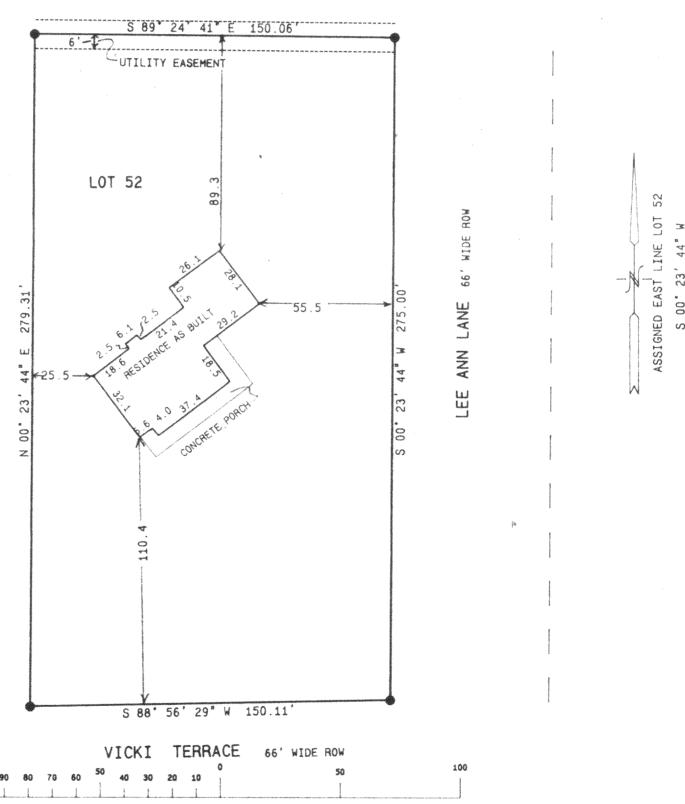

MAP SCALE IN FEET ORIGINAL 1" = 40' NOTE: COPIES OF THIS MAP TO WHICH THE FOLLOWING CERTIFICATE WILL APPLY ARE BLUE LINE PRINTS SHOWING SURVEYOR'S ORIGINAL SEAL AND SIGNATURE IN BLACK INK. COPIES BY ANY OTHER MEANS MAY HAVE ALTERATIONS WHICH DO NOT REPRESENT THE SURVEYOR'S WORK PRODUCT.

I HEREBY CERTIFY THAT THE ABOVE DESCRIBED PROPERTY HAS BEEN SURVEYED UNDER MY DIRECTION AND THAT THE ABOVE MAP IS A TRUE REPRESENTATION THEREOF AND SHOWS THE SIZE AND LOCATION OF THE PROPERTY AND ITS EXTERIOR BOUNDARIES. THIS SURVEY IS MADE FOR THE USE OF THE PRESENT OWNERS OF THE PROPERTY MAND ALSO THOSE WHO TITLE THERETO WITHIN ONE YEAR FROM THE DATE HEREOF.

DATED: 9/22/95

PETER S.
GORDON
S-2101
ELKHORN,
WI JARANTEE THE

SURVINION SURVINION

PETER S. GORDON R.L.S. 2101

PROJ 4347 SHEET 1 OF 1

OCT | 6 | 995

416-1157