PLAT OF SURVEY


LOT 26 OF DUNBAR ESTATES SUBDIVISION, LOCATED IN SECTION 36, TOWN 4 NORTH, RANGE 16 EAST, TOWN OF LAGRANGE. WALWORTH COUNTY, SET P.K. NAIL IN BLACKTOP DRIVENAY? WISCONSIN.

PLEASANT LAKE ROAD 66' WIDE

ORDERED BY: SCHAUDER BUILDERS, INC. 4115 US HWY 51 NORTH JANESVILLE, WI. 53545

OWNER: JOHN & DORIS REYNHOUT 16213 JOYCE CIRCLE SOUTH HOLLAND, ILL. 60473

IMMEDIATELY IF ANY DISCREPANCY EXISTS.

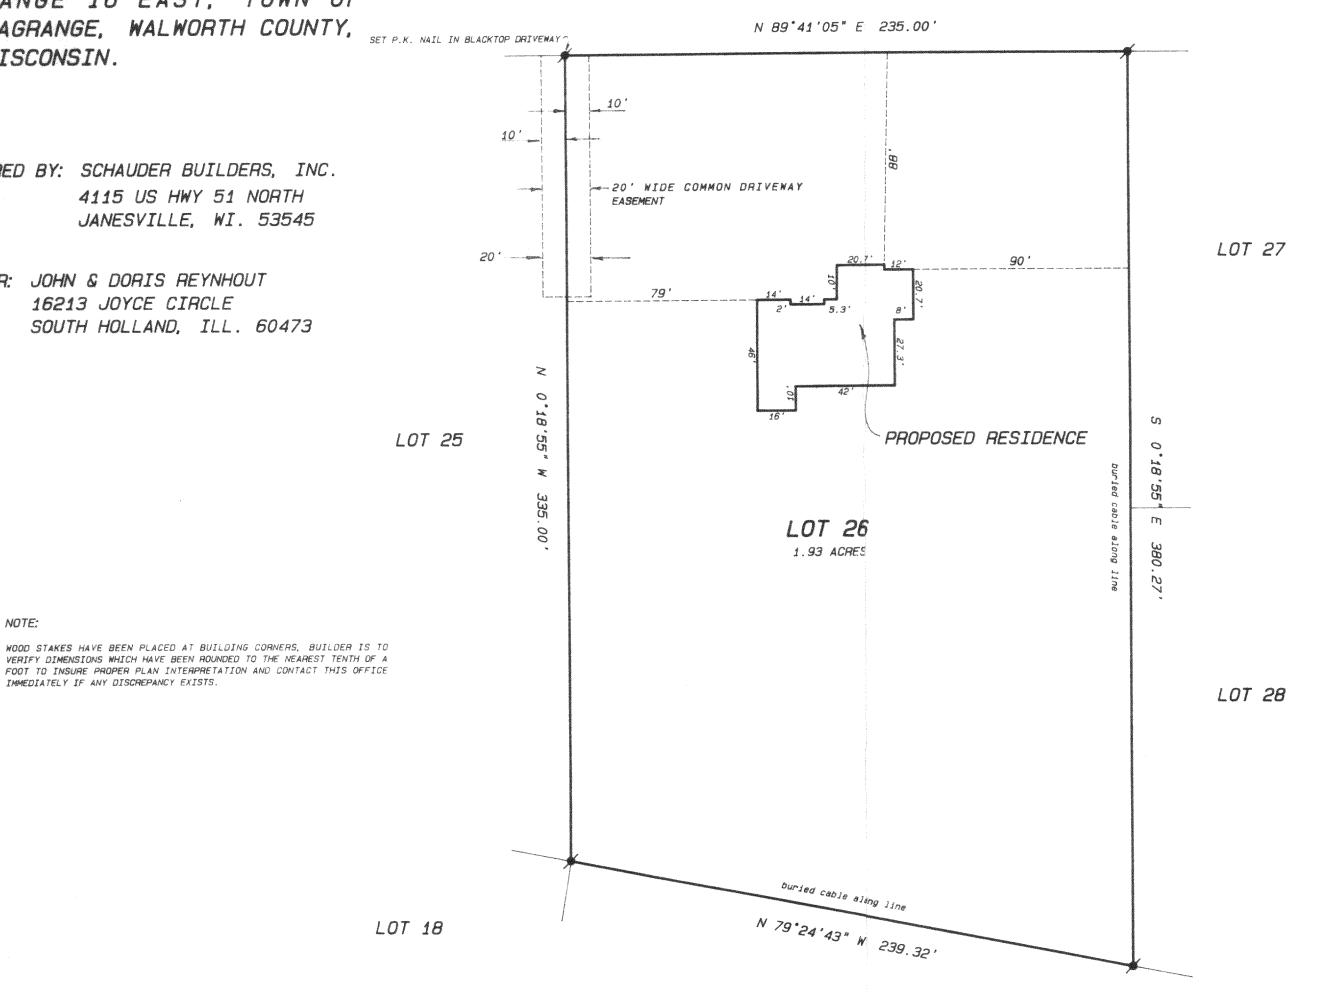

LOT 17

SCALE 1" = 40 FEET

Legend

- FOUND IRON PIPE FOUND IRON ROD
- FOUND BRASS CAPPED MONUMENT
- * FOUND CONCRETE MONUMENT + CHISEL CUT IN CONCRETE
- SET IRON ROD, 24" LONG, WEIGHING 1.5 LBS./LINEAL FT., 3/4" DIA.
- SET IRON ROD, 30³¹ LONG, WEIGHING 4.5 LBS./LINEAL FT., 1-11/16³¹ DIA.

RECORDED AS DIMENSION EXISTING FENCE



SCALE: 1"= 40 FEET



"I hereby certify that the above described property has been surveyed by me or under my direction and that the above map is a true representation thereof and shows the size and location of the property, its exterior boundaries, the location of all visible structures and dimensions of all principal buildings thereon, boundary fences, apparent easements, roadways and visible encroachments, if any."

"This survey is made for the use of the present owners of the property, and also those who purchase, mortgage, or guarantee the title thereto within one year from date hereof."

KENNETH B. ABERNATHY, JR. WISCONSIN REGISTERED LAND SURVEYOR,

Date: 10/6/95

Job No. 95,918

ABERNATHY and ASSOCIATES

Kenneth B. Abernathy Jr.

Wisconsin Registered Land Surveyor S-1594

Rt. 3, Box 273 Elkhorn, Wisconsin 53121 Phone: (414) 723-4260 (office) (414) 723-7209 (FAX)


PLAT OF SURVEY

LOT 26 OF DUNBAR ESTATES
SUBDIVISION, LOCATED IN
SECTION 36, TOWN 4 NORTH,
RANGE 16 EAST, TOWN OF
LAGRANGE, WALWORTH COUNTY,
WISCONSIN.

PLEASANT LAKE ROAD
66' WIDE

ORDERED BY: SCHAUDER BUILDERS, INC.
4115 US HWY 51 NORTH
JANESVILLE, WI. 53545

OWNER: JOHN & DORIS REYNHOUT 16213 JOYCE CIRCLE SOUTH HOLLAND, ILL. 60473

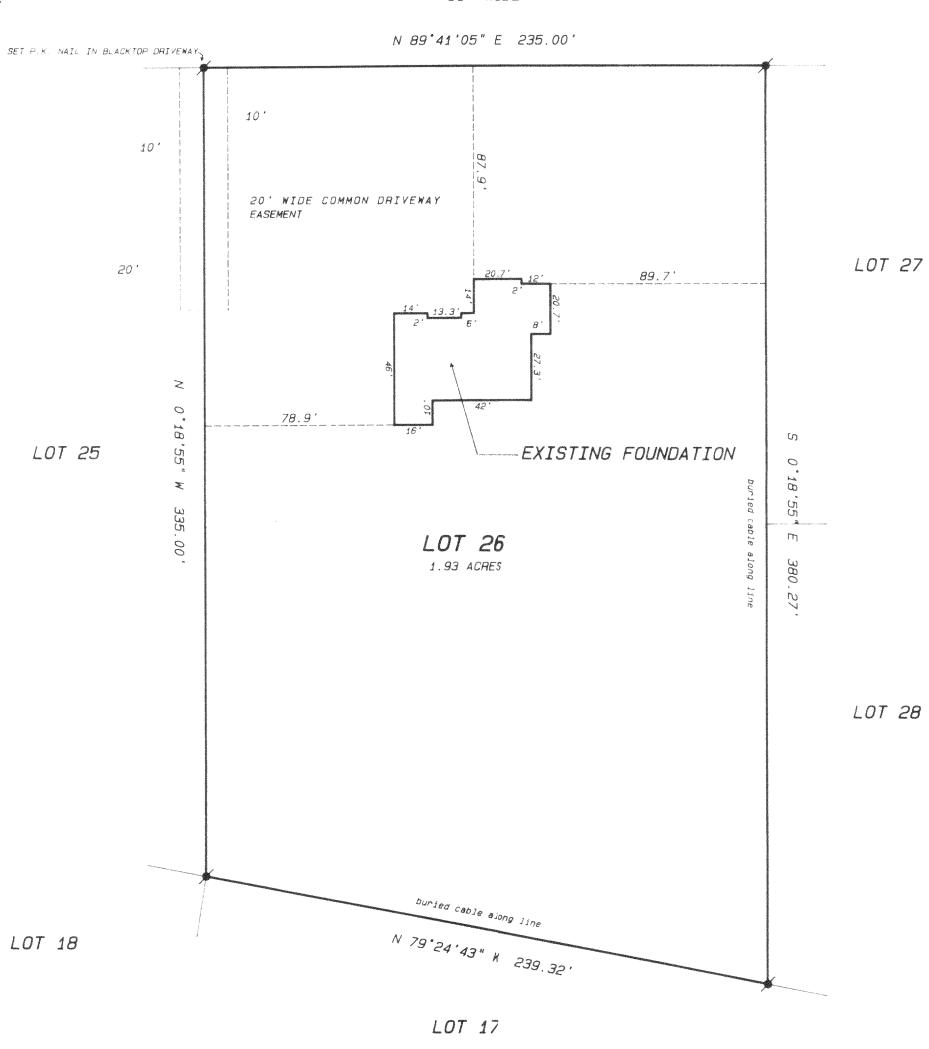

SCALE 1" = 40 FEET

Legend

- .' FOUND IRON PIPE
- FOUND BRASS CAPPED MONUMENT
- # FOUND CONCRETE MONUMENT
- + CHISEL CUT IN CONCRETE
- SET TRON ROD, 24' LONG, WEIGHING 1.5 LBS, LINEAL FT. 3 4" DIA
- SET IRON ROD, 30" LONG WEIGHING 4.5 LBS, LINEAU FT., 1-13:16" DIA.
- EXXT RECORDED AS DIMENSION

EXISTING FENCE



SCALE: 1"= 40 FEET



"Energy entry that the above described property has been survey by one or under my direction and that the above map is a transport of the property and also those who purchase mortgage or guarantee the fitte thereto within

KENNETH B. ABERNATHY, JR.
WISCONSIN REGISTERED LAND SURVEYOR

Date: NOVEMBER 20, 1995 Job No. 95.918AB

HDS-26

416-1179