



AMERICAN SURVEYING COMPANY, INC.

LAND SURVEYORS



11931 Hwy. "K"
FRANKSVILLE, WISCONSIN
TEL. NO. (414) 835-4774

PLAT OF SURVEY

PREPARED FOR: BADGER HOMES
DESCRIPTION: LOT 16, OF SOUTHMOOR SUBDIVISION, IN THE SOUTHWEST 1/4 OF SECTION 25, TOWN 4 NORTH, RANGE 16 EAST,
TOWN OF LAGRANGE, WALWORTH COUNTY, WISCONSIN.

OWNER: DRINNON

REVISION 06/27/95
GARAGE CHANGE

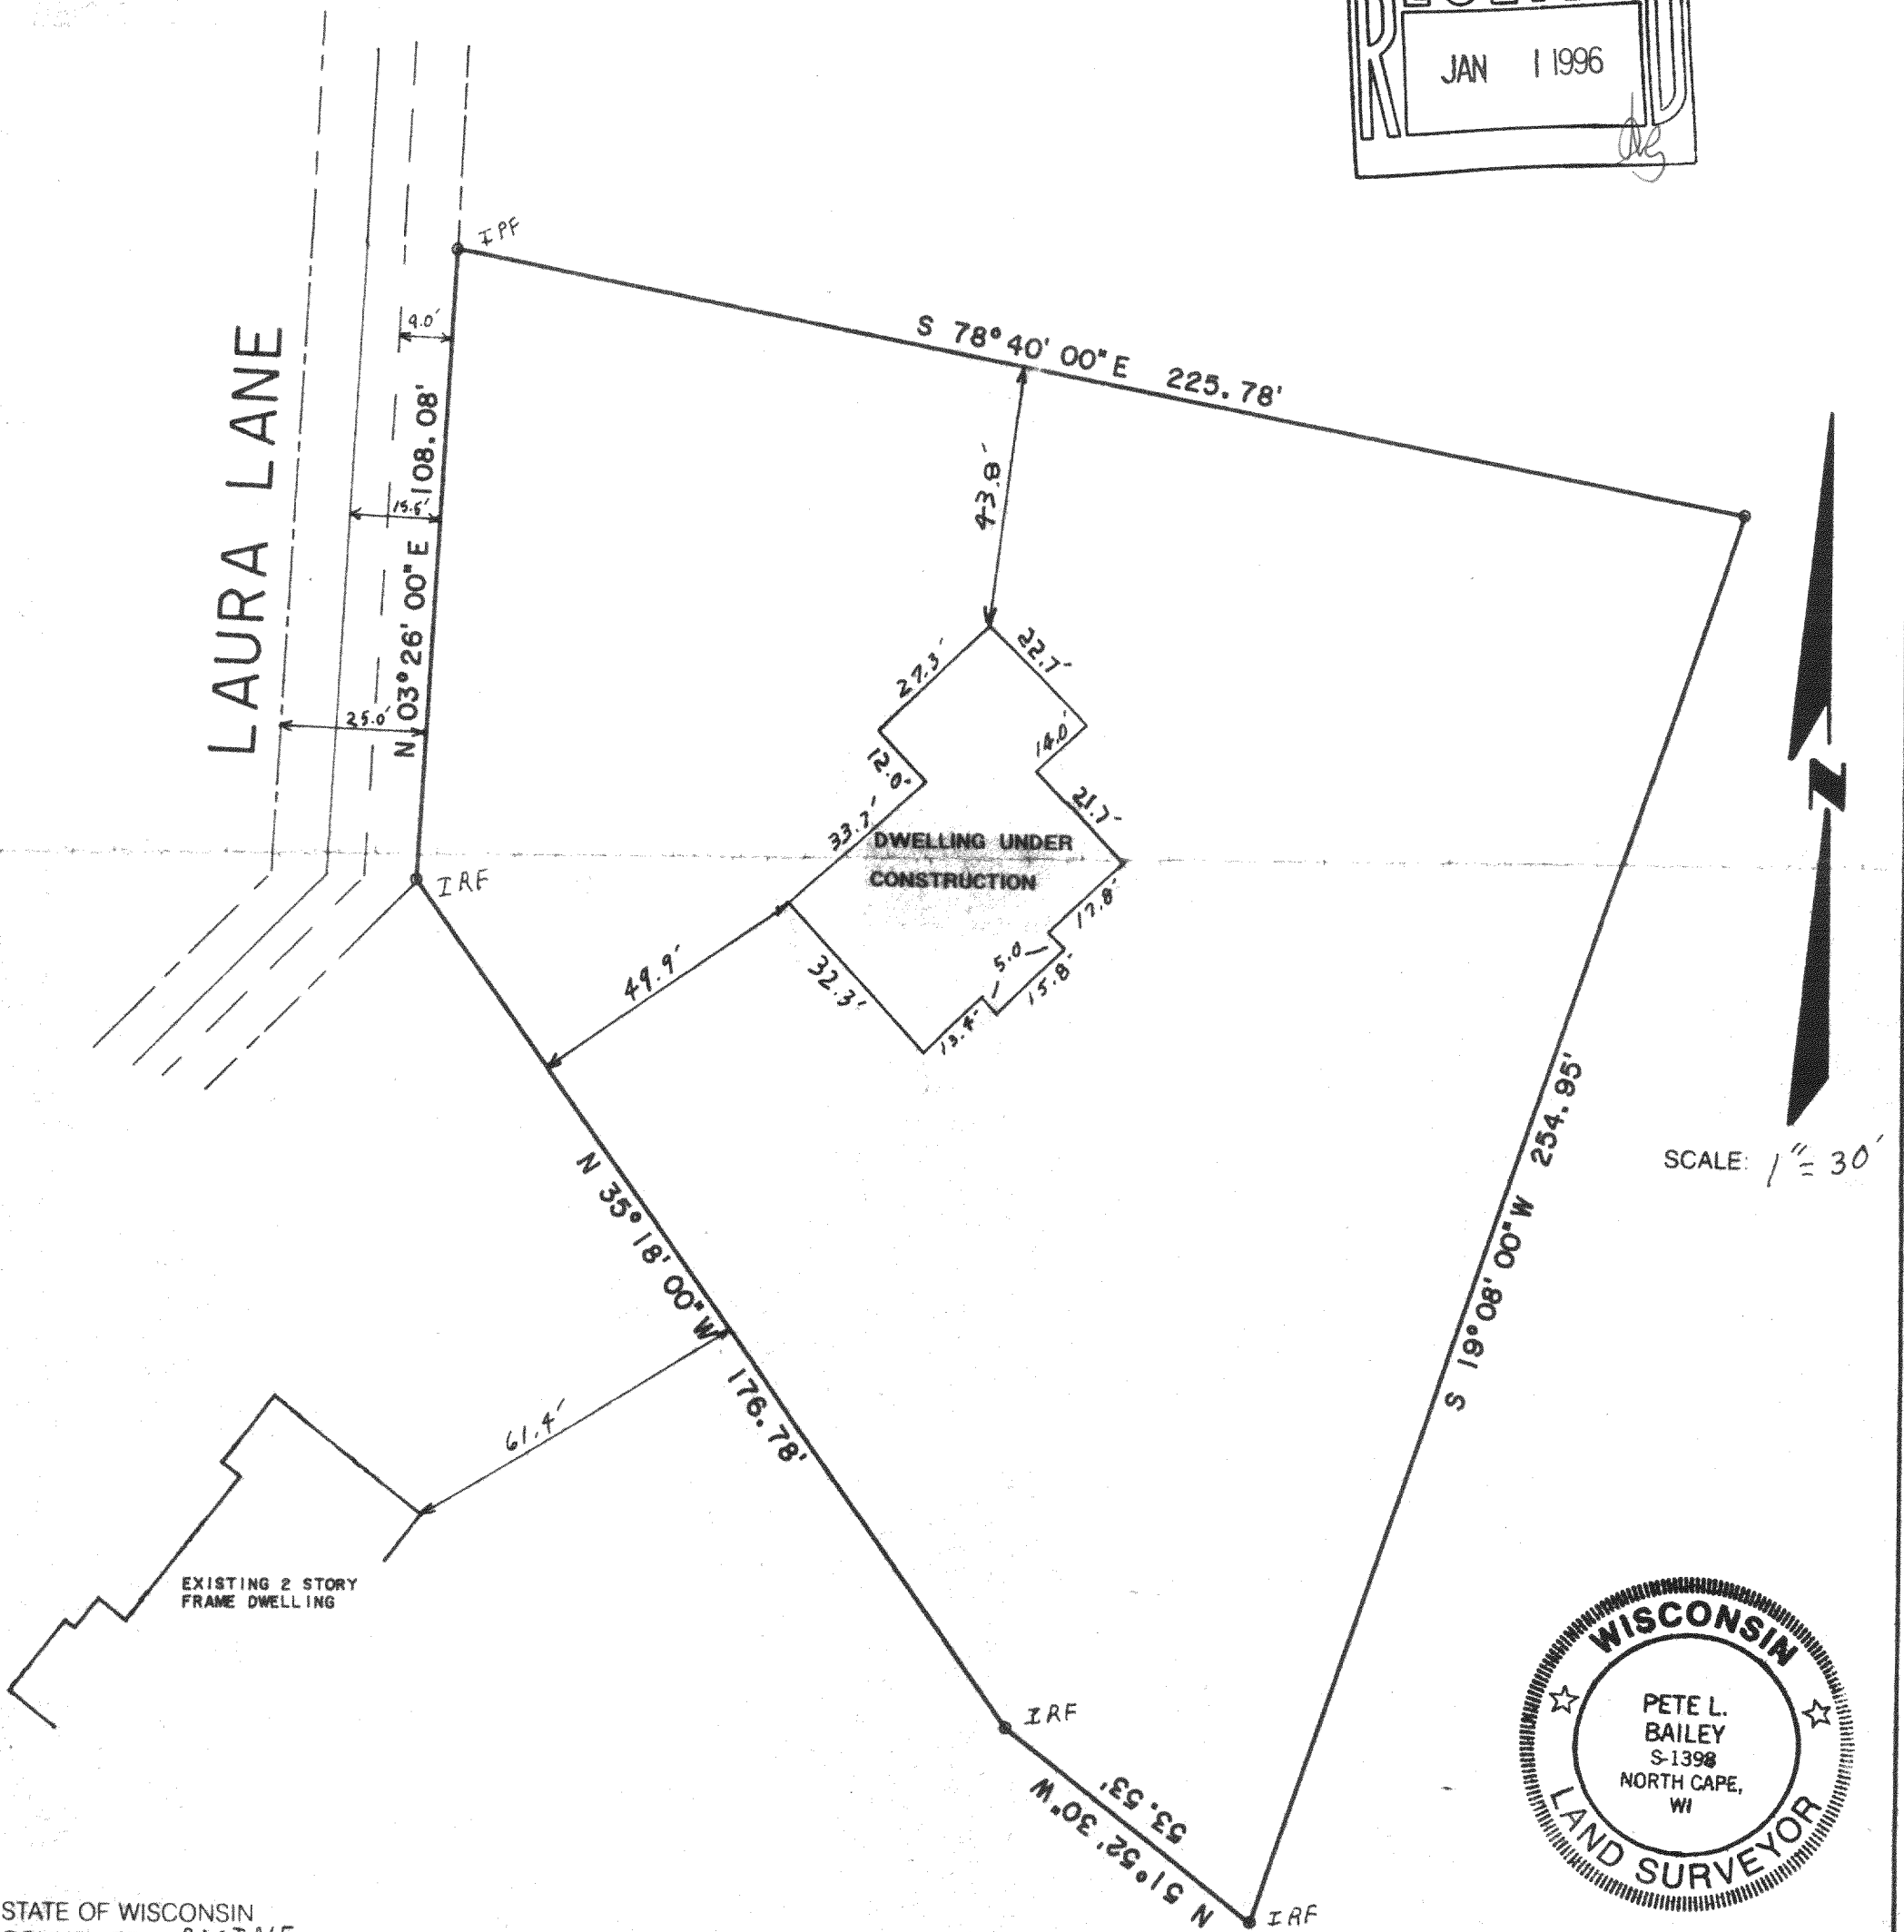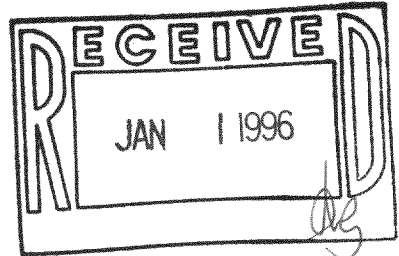

STATE OF WISCONSIN
COUNTY OF RACINE

I hereby certify that I have surveyed the above described property and the above map is a true representation thereof and shows the size and location of the property, its exterior boundaries, the location of all visible structures and dimensions of all principle buildings thereon, boundary fences, apparent easements, roadways and visible encroachments, if any.

This survey is made for the present owners of the property, and also those who purchase, mortgage, or guarantee the title thereto within one (1) year from the date thereof.

Dated at NORTH CAPE, this 13TH day of JUNE, 19 95. Recertified 10-03-95

Pete L. Bailey
Registered Land Surveyor

JOB NO. 95.053

HSM-16

416-1183