
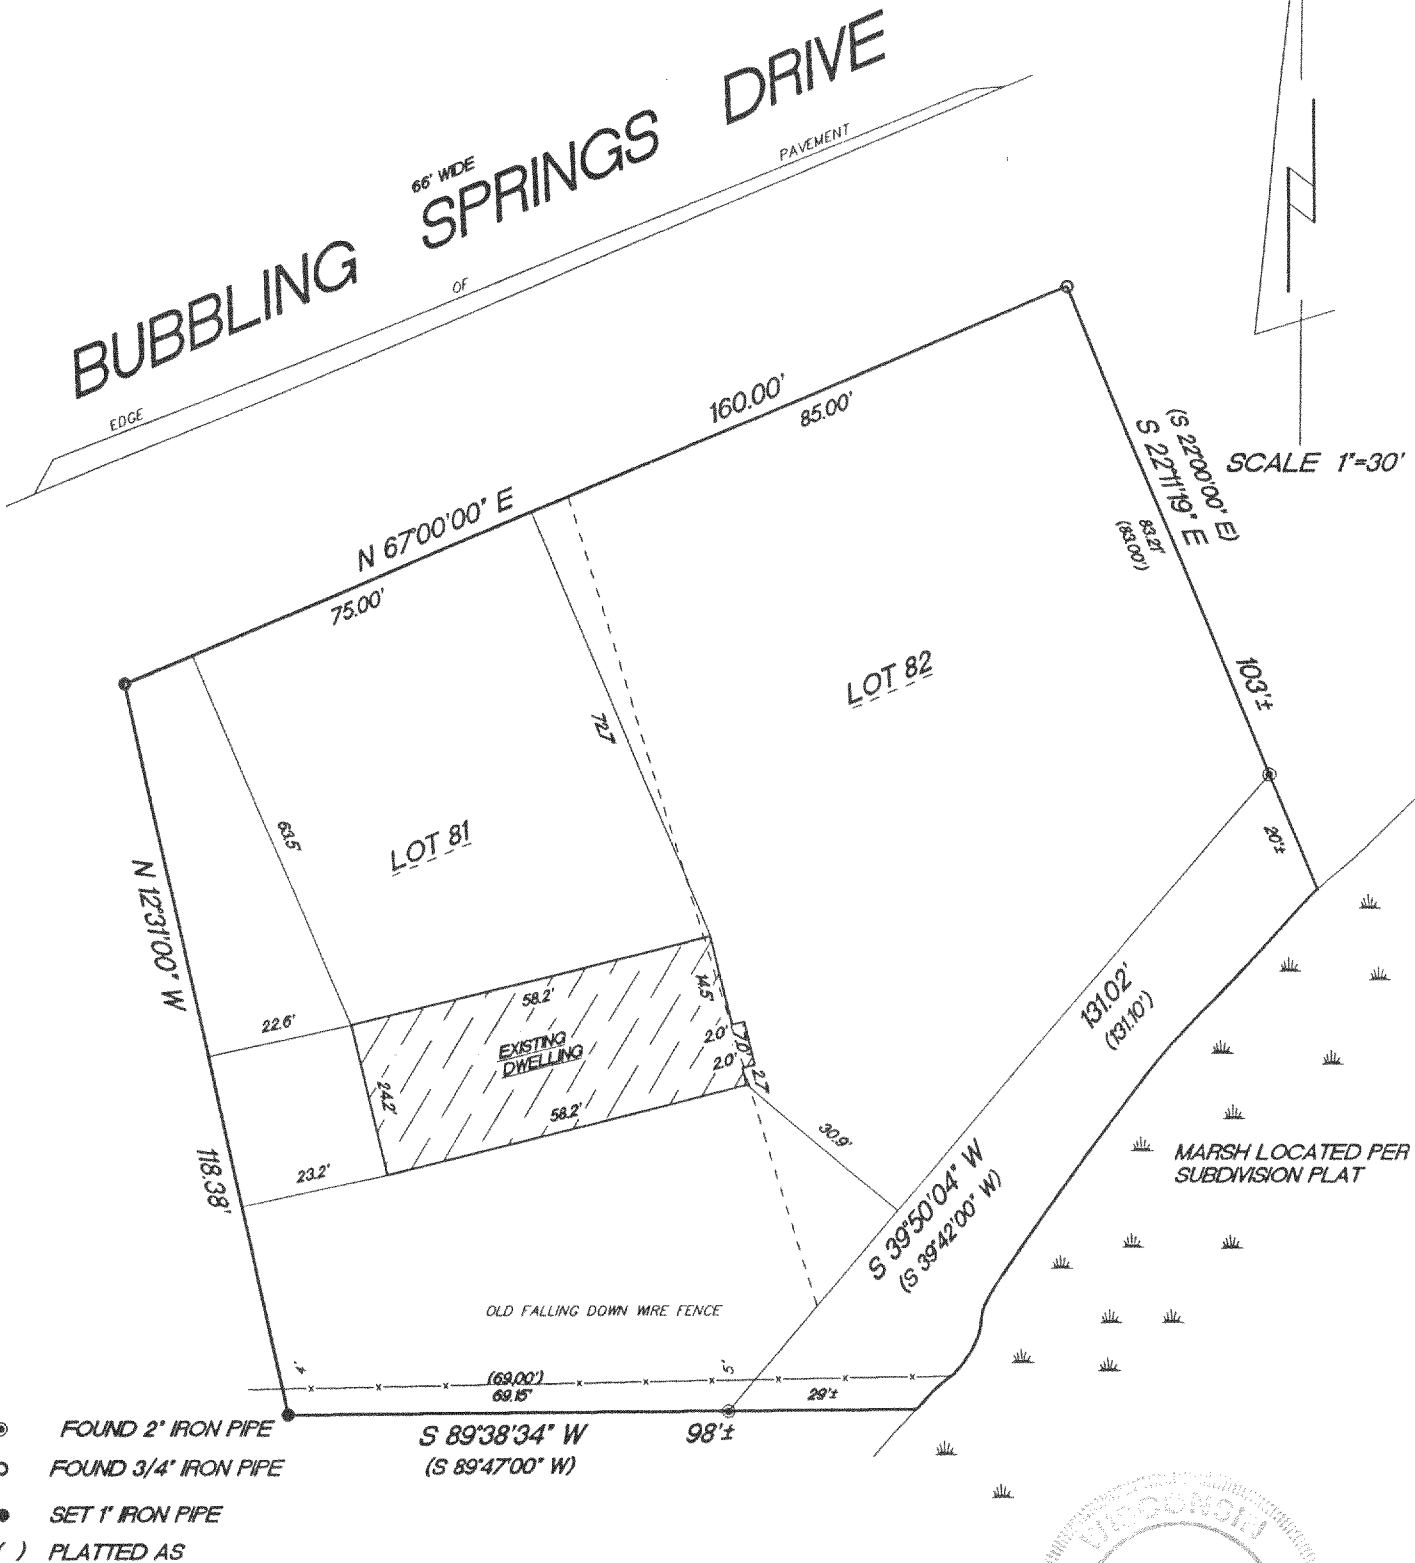


# PLAT OF SURVEY


LOTS 81 AND 82 IN THE 2ND ADDITION TO BUBBLING SPRINGS SUBDIVISION, located in the Northwest 1/4 of the Southeast 1/4 and the Northeast 1/4 of the Southeast 1/4 and the Southeast 1/4 of the Northeast 1/4 of Section 34, Town 4 North, Range 16 East, Walworth County, Wisconsin.

Surveyed for: Don Heller  
Survey address: 5873 Bubbling Springs Road

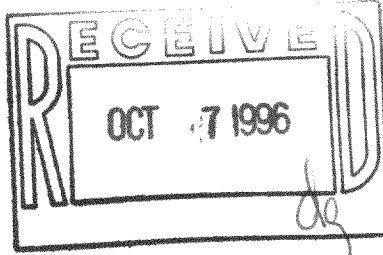

"I hereby certify that I have surveyed the above described property and that the above map is a true representation thereof and shows the size and location of the property, its exterior boundaries, the location of all visible structures and dimension of all principal buildings thereon, boundary fences, apparent easements, roadways and encroachments if any."

"This survey is made for the use of the present owners of the property, and also those who purchase, mortgage or guarantee the title thereto within one year from date hereof."

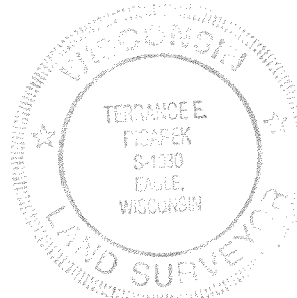

W362 S10227 Lewin Lane  
Eagle, Wisconsin 53119  
Terrance E. Pisarek R.L.S.

(414) 594-3484  
fax (414) 594-5904

THIS IS NOT AN ORIGINAL SURVEY UNLESS THE SEAL IS RED.

9/17/96 DATE  
DRF/JPK FIELD WORK BY  
TEP DRAWN BY  
96161 JOB NUMBER

HBS-2

416-1191