
ABELL SURVEYING & MAPPING DELAVAN, WISCONSIN 53115 414-728-6737

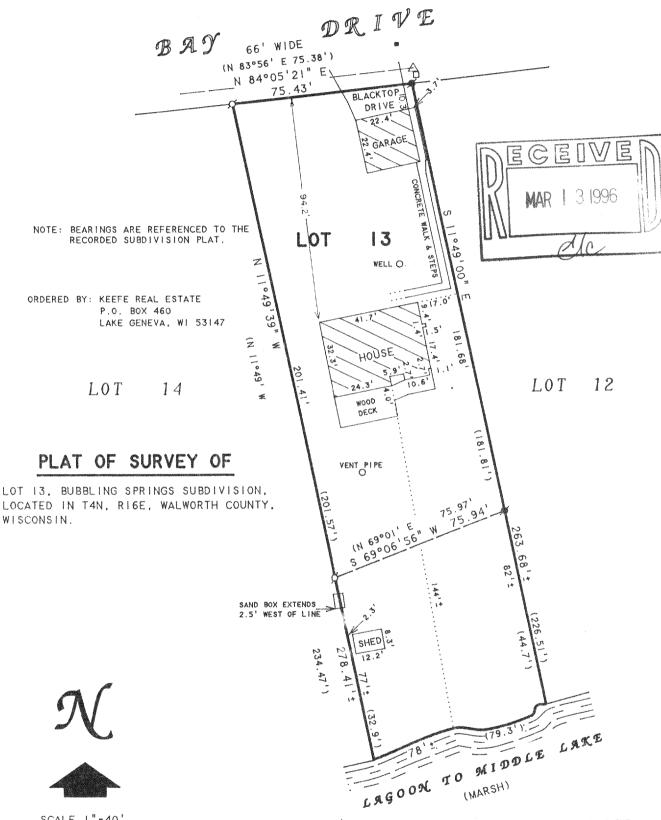

SCALE | " = 40' LEGEND

Ø -IRON PIPE FOUND ■ -IRON ROD FOUND

A -UTILITY POLE

OVERHEAD UTILITY LINES

UTILITY PED.

■ -BASKETBALL BACKBOARD POST

)-RECORDED AS

I HEREBY CERTIFY THAT I HAVE SURVEYED THE ABOVE DESCRIBED PROPERTY AND THAT THE ABOVE MAP IS A TRUE REPRESENTATION THEREOF AND SHOWS THE SIZE AND LOCATION OF THE PROPERTY. ITS EXTERIOR BOUNDARIES, THE LOCATION OF ALL VISIBLE STRUCTURES AND DIMENSIONS OF ALL PRINCIPAL BUILDINGS THEREON, BOUNDARY FENCES, APPARENT EASEMENTS, ROADWAYS AND VISIBLE ENCROACHMENTS, IF ANY, TO THE BEST OF MY KNOWLEDGE AND BELIEF.

THIS SURVEY IS MADE FOR THE USE OF THE PRESENT OWNERS OF THE PROPERTY, AND ALSO THOSE WHO PURCHASE, MORTGAGE, OR GUARANTEE THE TITLE THERETO WITHIN ONE (I) YEAR FROM BATE HEREON.

December 6, 1995

DATE
NOTE: THIS IS NOT A CERTIFIED COPY UNLESS SEALED.