
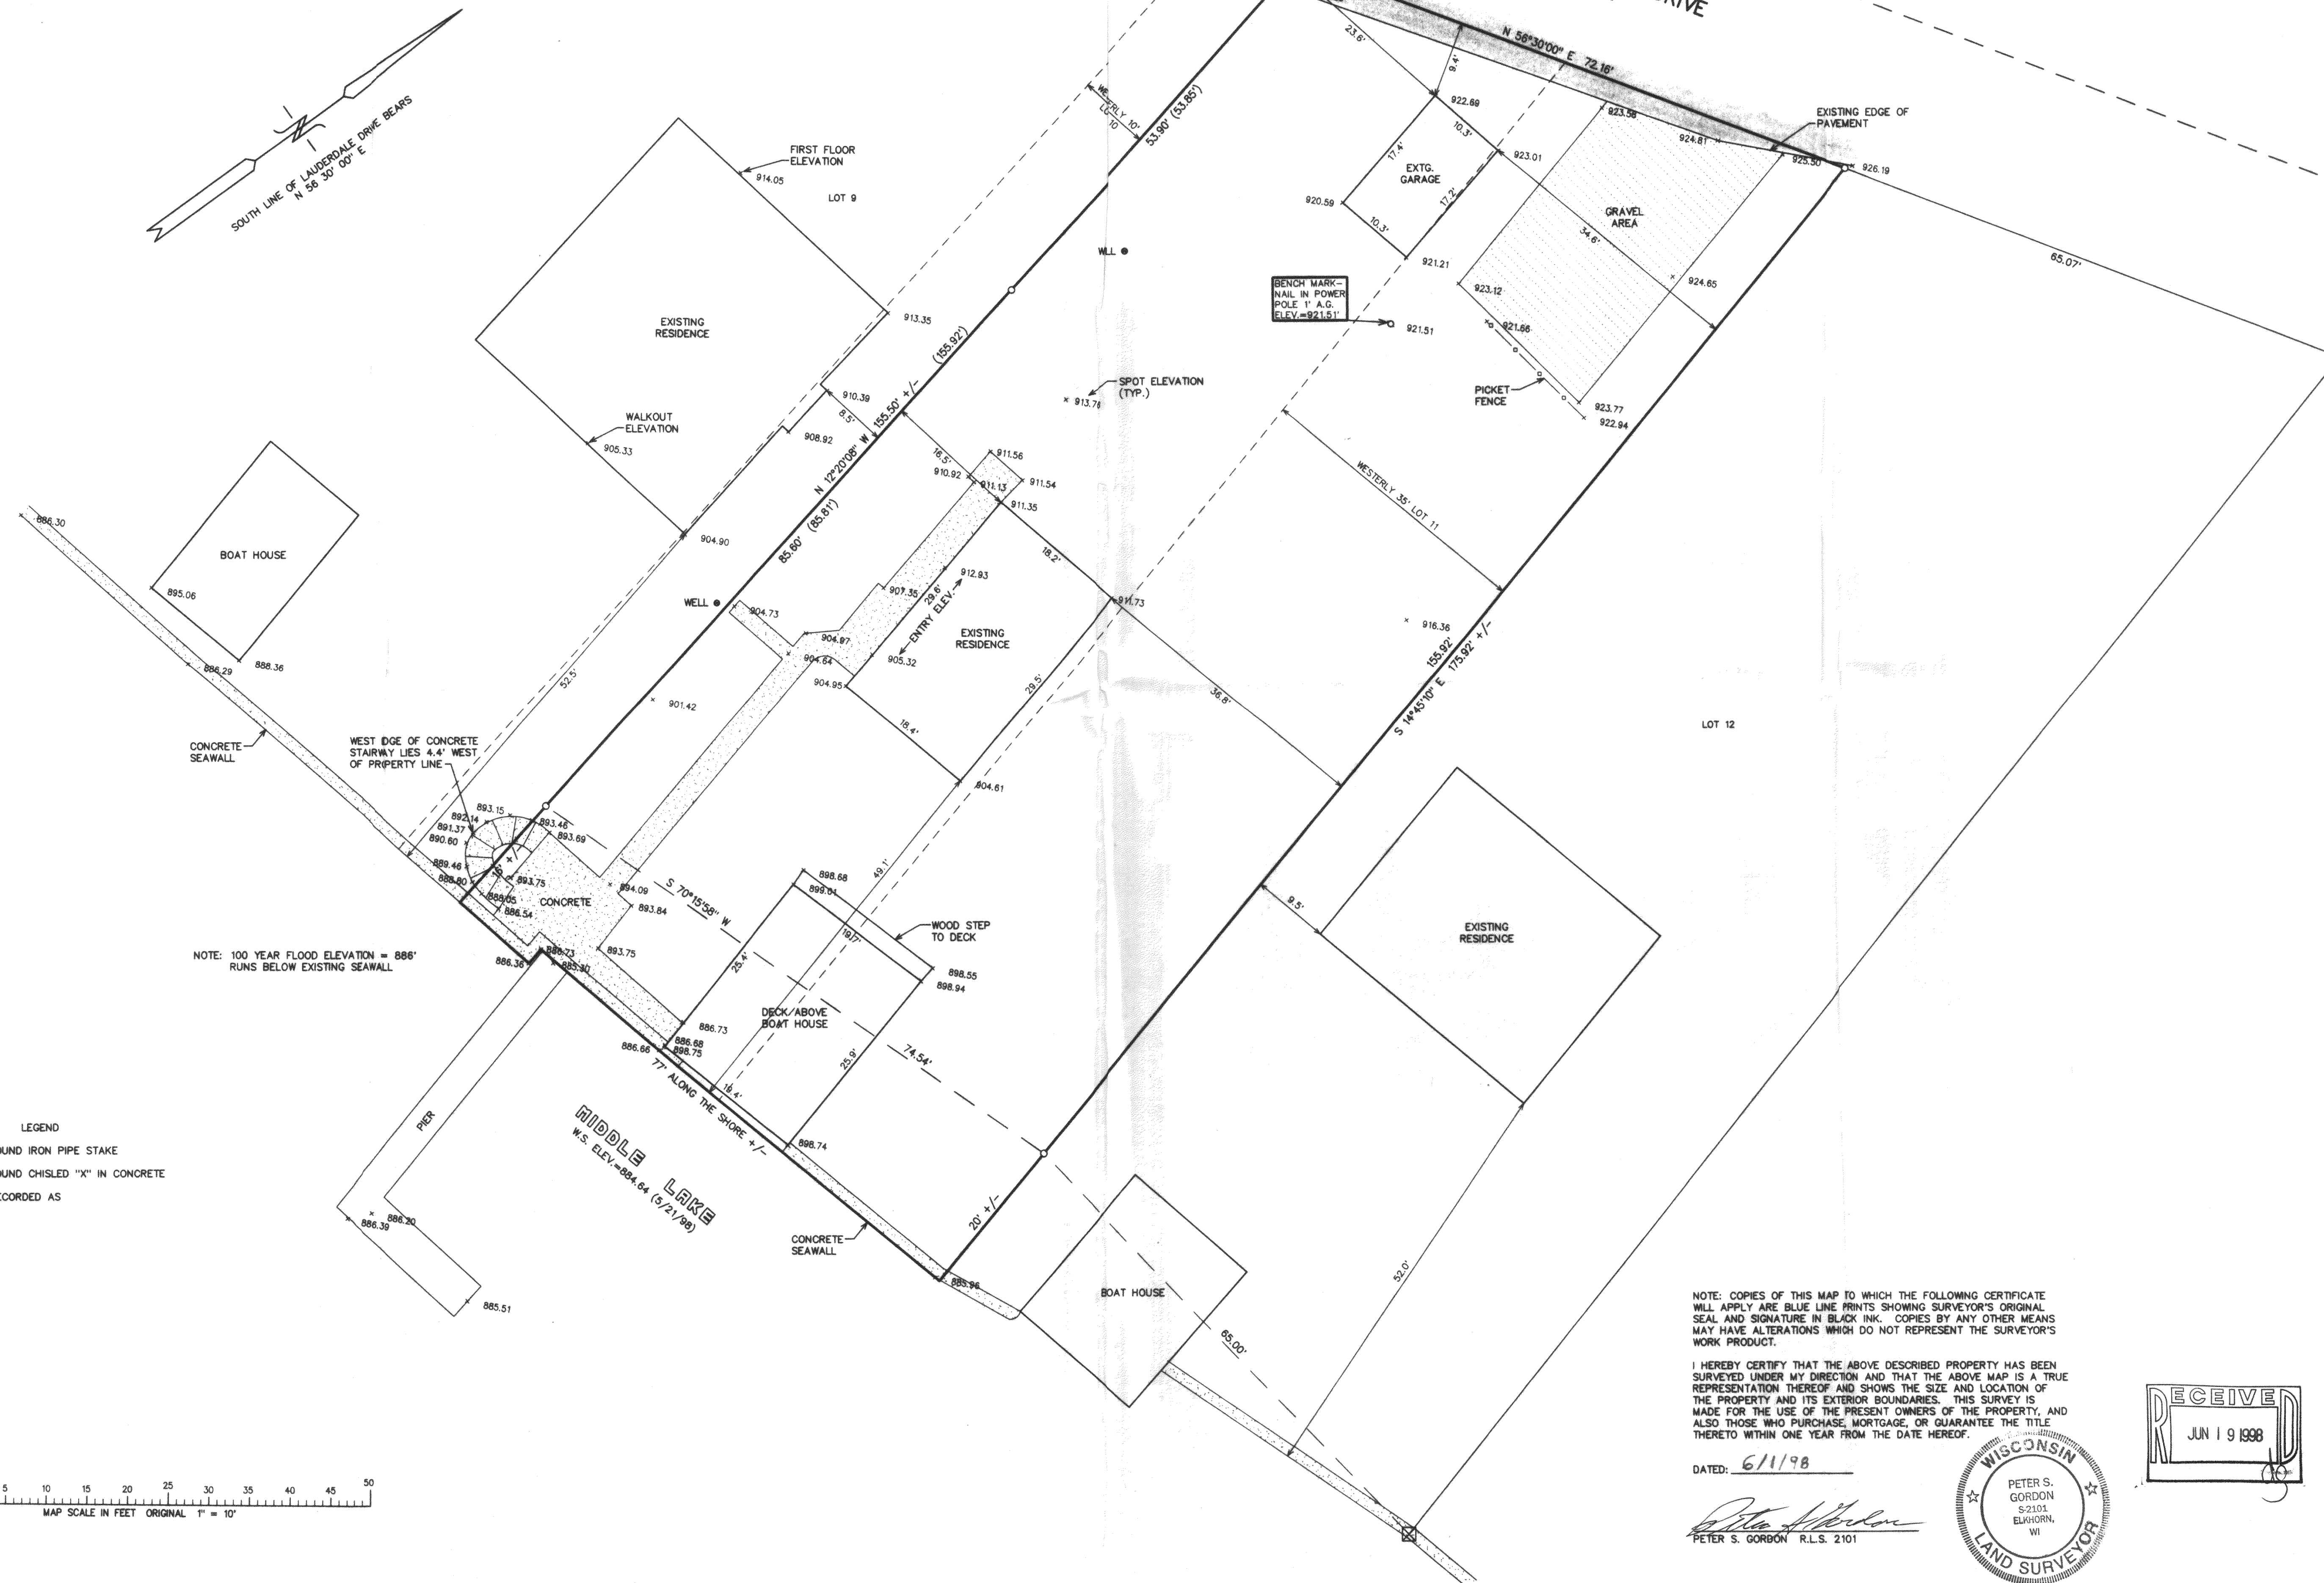


PLAT OF SURVEY
 LOT 10 EXCLUDING THE WESTERLY 10' THEREOF
 AND THE WESTERLY 35' OF LOT 11
 1st ADDITION TO LAUDERDALE PARK
 LOCATED IN SECTION 25, TOWN 4 NORTH, RANGE 16 EAST,
 WALWORTH COUNTY, WISCONSIN


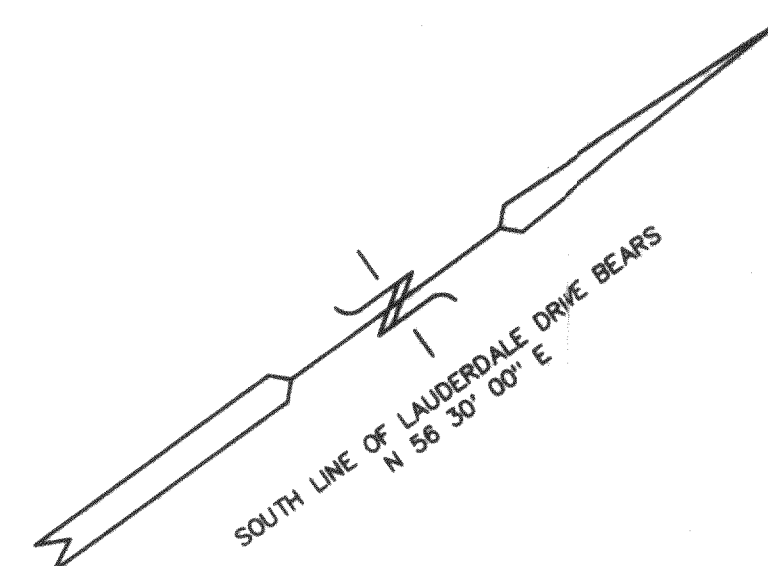


NOTE: COPIES OF THIS MAP TO WHICH THE FOLLOWING CERTIFICATE WILL APPLY ARE BLUE LINE PRINTS SHOWING SURVEYOR'S ORIGINAL SEAL AND SIGNATURE IN BLACK INK. COPIES BY ANY OTHER MEANS MAY HAVE ALTERATIONS WHICH DO NOT REPRESENT THE SURVEYOR'S WORK PRODUCT.

I HEREBY CERTIFY THAT THE ABOVE DESCRIBED PROPERTY HAS BEEN SURVEYED UNDER MY DIRECTION AND THAT THE ABOVE MAP IS A TRUE REPRESENTATION THEREOF AND SHOWS THE SIZE AND LOCATION OF THE PROPERTY AND ITS EXTERIOR BOUNDARIES. THIS SURVEY IS MADE FOR THE USE OF THE PRESENT OWNERS OF THE PROPERTY, AND ALSO THOSE WHO PURCHASE, MORTGAGE, OR GUARANTEE THE TITLE THERETO WITHIN ONE YEAR FROM THE DATE HEREOF.

DATED: 6/1/98

PETER S. GORDON
 S2101
 ELKHORN, WI
 PETER S. GORDON R.L.S. 2101

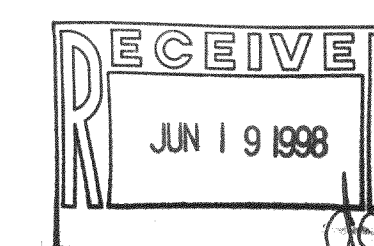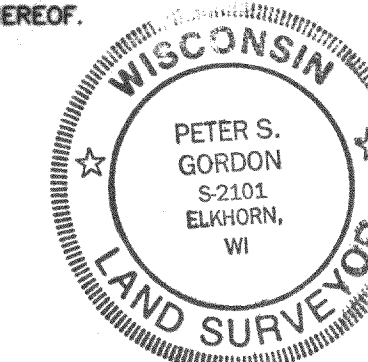

PLAT OF SURVEY

WORK ORDERED BY -
 PAUL E. JOSEPH
 3350 S. STONEGATE #4
 NEW BERLIN, WI. 53151

FARRIS, HANSEN & ASSOCIATES, INC.
 Engineering, Architecture, Surveying
 7 Ridgeway Court P.O. Box 437
 ELKHORN, WISCONSIN 53121
 Office: (414) 723-2098
 Fax: (414) 723-5886

REVISIONS

PROJECT NO.
 5020

DATE
 06/01/98

SHEET NO.
 1 OF 1

416-1368
 HLP-3