

**PLAT OF SURVEY**

A PARCEL OF LAND LOCATED IN THE NORTHWEST FRACTIONAL 1/4 OF SECTION 35, TOWN 4 NORTH, RANGE 16 EAST, WALWORTH COUNTY, WISCONSIN.

LEGAL DESCRIPTION AS FOUND IN VOL. 649, P. 202, DOC #361642



A PARCEL OF LAND LOCATED IN THE NORTHWEST FRACTIONAL 1/4 OF SECTION 35, TOWN 4 NORTH, RANGE 16 EAST, WALWORTH COUNTY, WISCONSIN, DESCRIBED AS FOLLOWS TO WIT: COMMENCING AT THE NORTH 1/16TH SECTION CORNER ON THE NORTH LINE OF SAID NORTHWEST 1/4 OF SAID SECTION; THENCE S 0°26'00" E ALONG THE 1/16TH SECTION LINE 330.87 FEET TO A POINT; THENCE S 57°57' E 106.50 FEET; THENCE S 79°33' E 31.50 FEET TO THE PLACE OF BEGINNING; THENCE S 13°56' E 257.64 FEET TO THE SHORE OF MIDDLE LAKE AT LOW WATER LINE; THENCE WESTERLY AND SOUTHWESTERLY ALONG THE SHORE AT LOW WATER LINE 61.50 FEET MORE OR LESS TO A POINT THAT IS LOCATED 12.4 FEET S 9°29' E FROM AN IRON PIPE; THENCE N 9°29' W 278.89 FEET TO AN IRON PIPE; THENCE S 57°57' E 14.50 FEET; THENCE S 79°33' E 31.50 FEET TO THE PLACE OF BEGINNING.

TOGETHER WITH A RIGHT OF WAY FOR PEDESTRIANS, AUTOMOBILES AND OTHER VEHICULAR TRAVEL OVER THE FOLLOWING DESCRIBED PARCEL OF LAND LOCATED IN THE NORTHWEST FRACTIONAL 1/4 OF SECTION 35, TOWN 4 NORTH, RANGE 16 EAST, WALWORTH COUNTY, WISCONSIN: COMMENCING AT THE NORTH 1/16TH SECTION CORNER ON THE NORTH LINE OF THE NORTHWEST 1/4 OF SAID SECTION; THENCE S 0°26' E ALONG THE 1/16TH SECTION LINE 330.87 FEET; THENCE S 57°57' E 33.04 FEET TO THE PLACE OF BEGINNING; THENCE CONTINUE S 57°57' E 73.46 FEET; THENCE S 79°33' E 113.33 FEET; THENCE N 71°20' E 97.37 FEET; THENCE N 64°06' E 99.96 FEET; THENCE N 52°22' E 130.08 FEET; THENCE N 46°03' E 107.61 FEET; THENCE N 32°27' E 126.92 FEET; THENCE N 03°51' W 79.48 FEET TO THE SOUTHERLY LINE OF THE PUBLIC ROAD; WHICH POINT IS LOCATED ON THE NORTH LINE OF SAID NORTHWEST FRACTIONAL 1/4; THENCE WEST 40.13 FEET; THENCE S 03°51' W 66.13 FEET; THENCE S 32°27' W 111.95 FEET; THENCE S 46°03' W 100.63 FEET; THENCE S 52°22' W 123.76 FEET; THENCE S 64°06' W 93.32 FEET; THENCE S 71°20' W 84.45 FEET; THENCE N 79°33' W 95.31 FEET; THENCE N 57°57' W 65.83 FEET; THENCE S 32°03' W 40 FEET TO THE PLACE OF BEGINNING.

OWNERS: STEPHEN L. BRODWOLF  
 KAREN L. BRAUN  
 3629 N. MARSHFIELD  
 CHICAGO, ILL. 60613

**SHOREYARD SETBACKS BY AVERAGING**

WESTERLY RESIDENCE	63.4'
EASTERLY RESIDENCE	75' (92.1' ACTUAL)
	138.4' ± 2
RESIDENCE MINIMUM SETBACK	69.2'
DECK MINIMUM SETBACK	63.2'

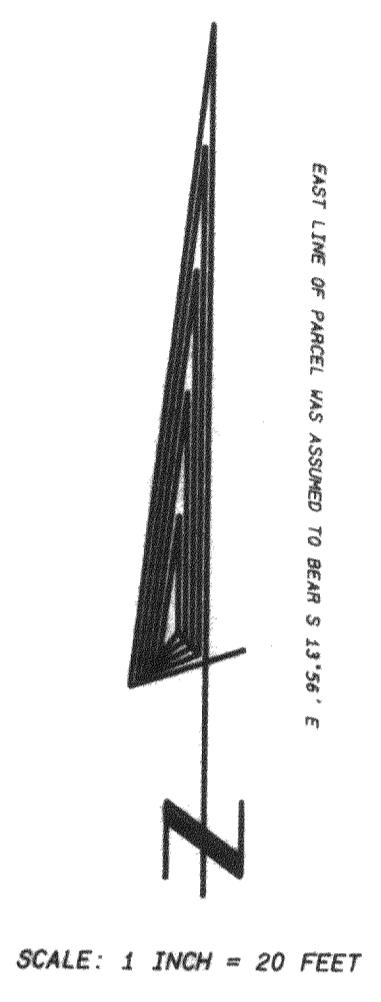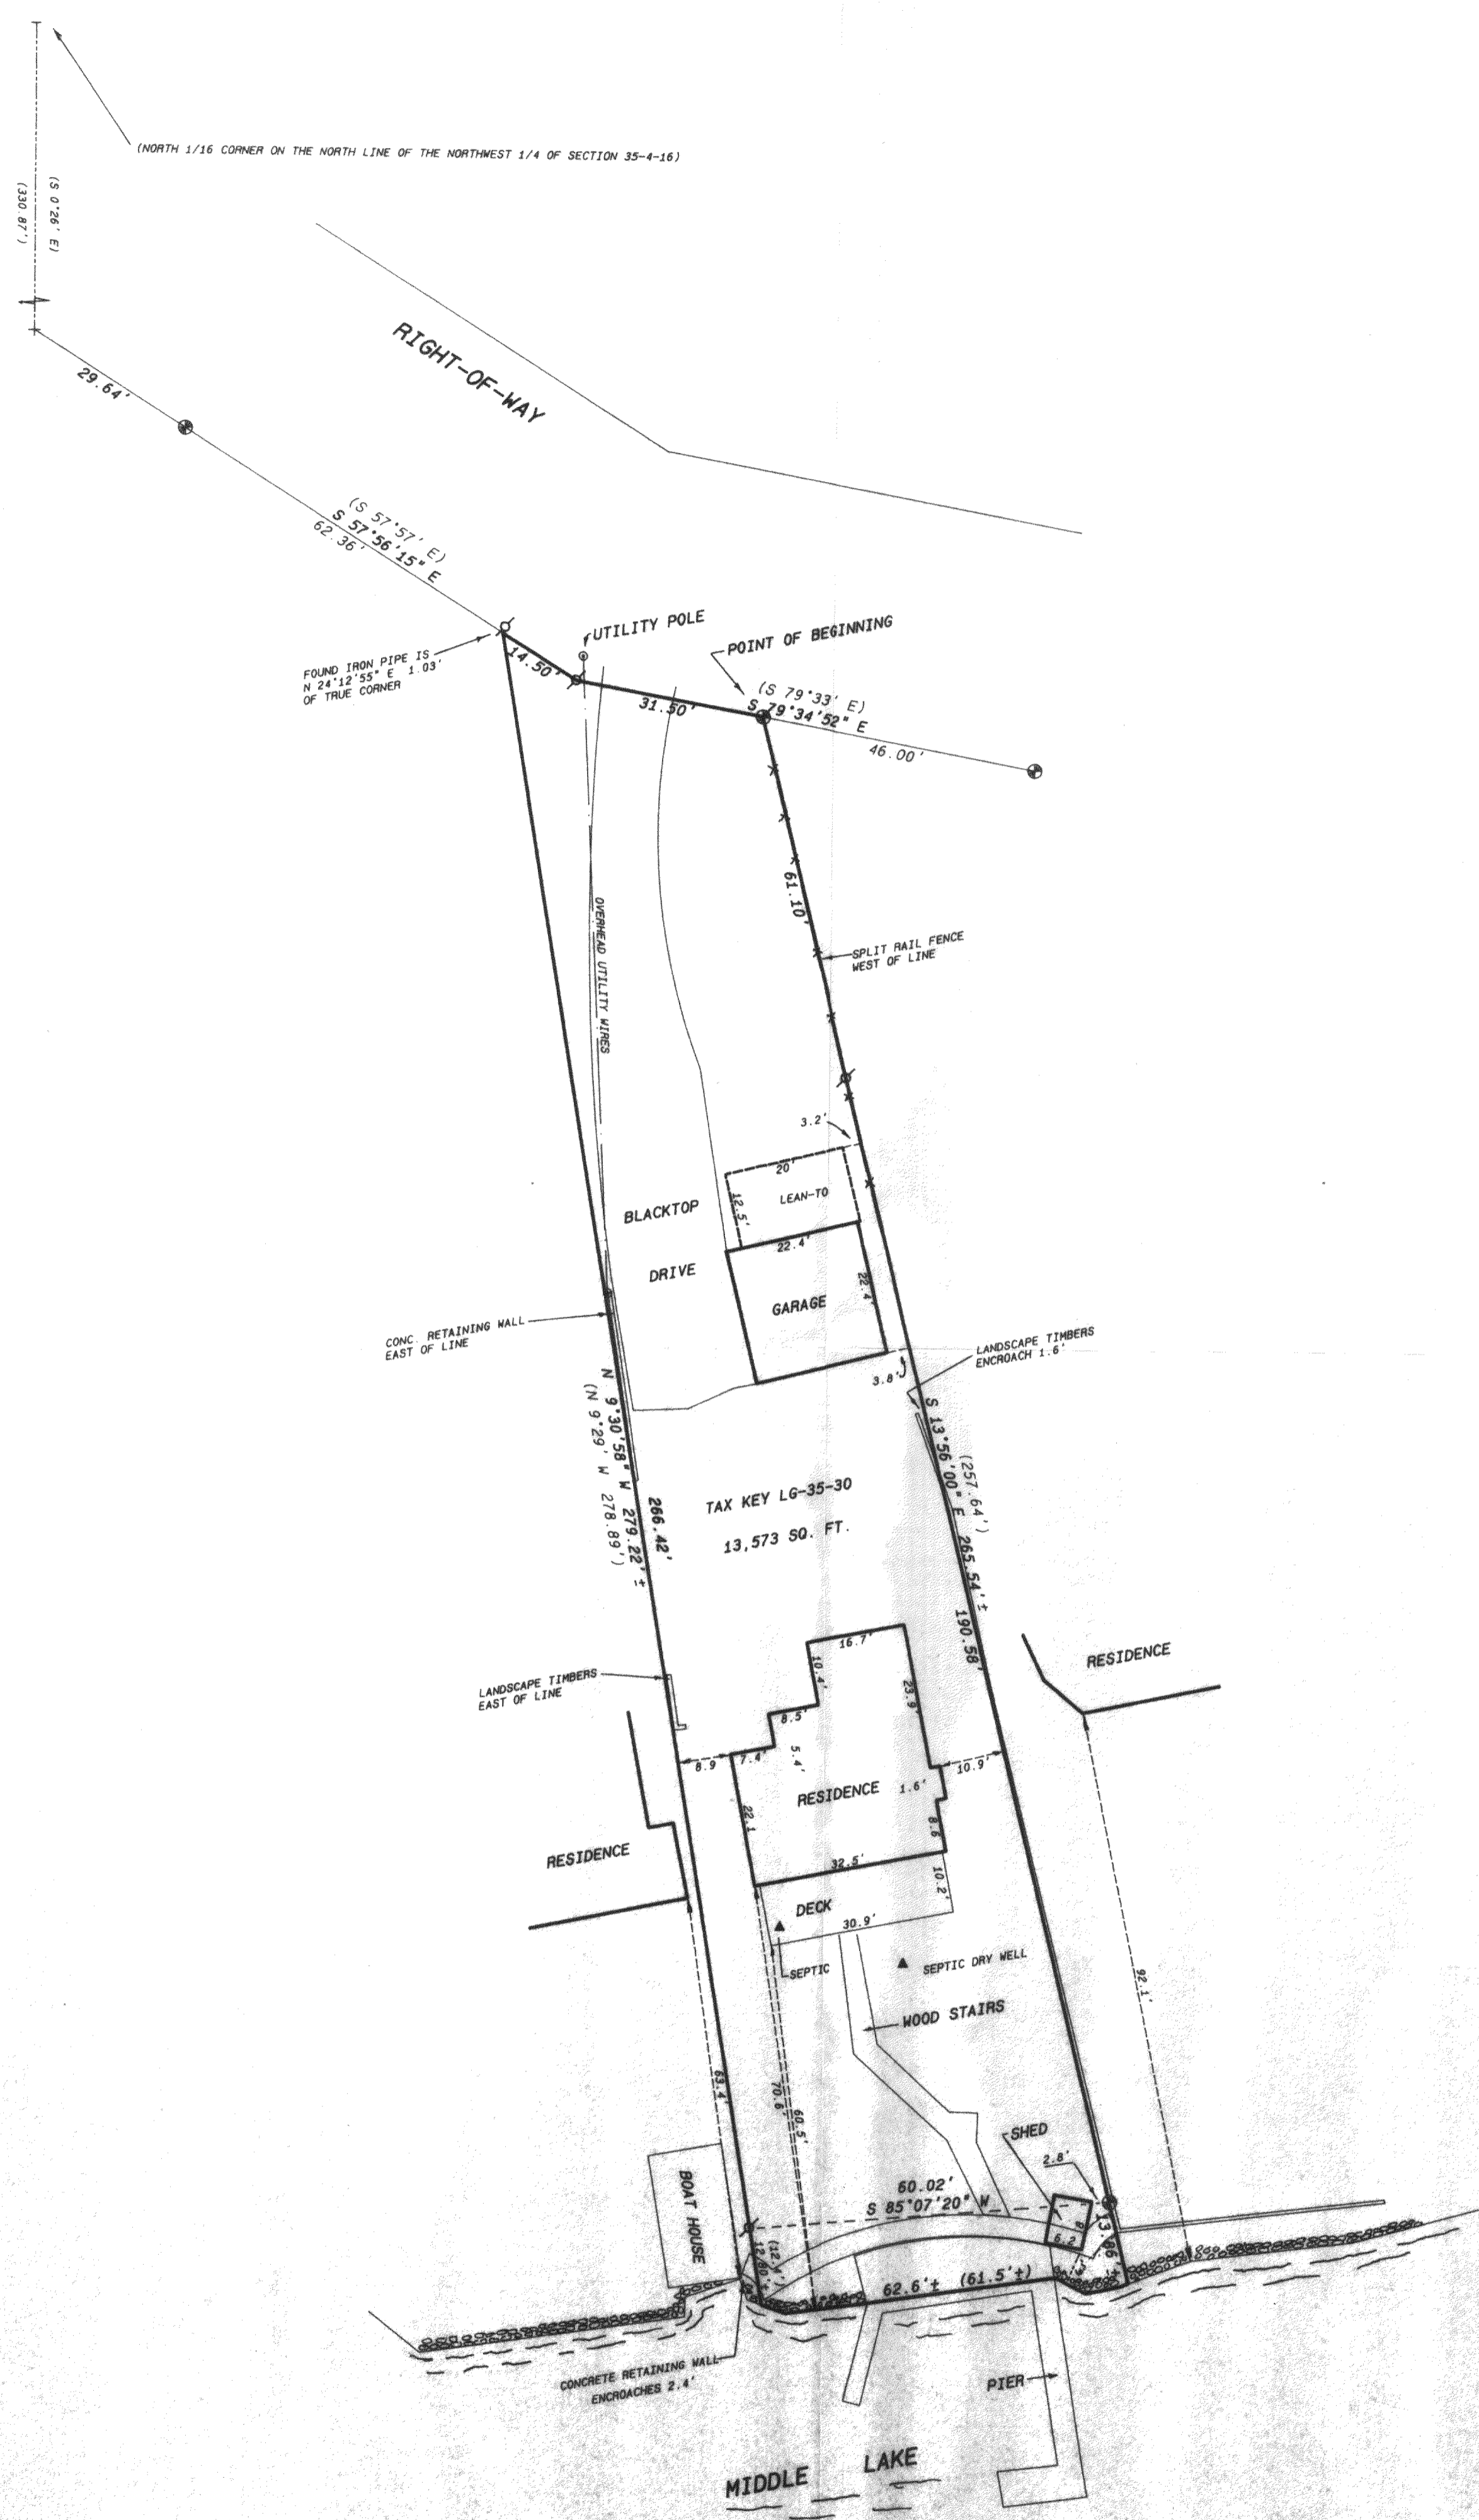

**Legend**

- FOUND IRON PIPE
- FOUND IRON ROD
- FOUND BRASS CAPPED MONUMENT
- FOUND CONCRETE MONUMENT
- ▲ CHISEL CUT IN CONCRETE
- SET IRON ROD, 24" LONG, WEIGHING 1.5 LBS./LINEAL FT., 3/8" DIA.
- SET IRON ROD, 36" LONG, WEIGHING 4.5 LBS./LINEAL FT., 1-11/16" DIA.
- (x) RECORDED AS DIMENSION
- - - EXISTING FENCE

WISCONSIN LAND SURVEYOR RECEIVED  
 KENNETH B. ABERNATHY, JR.  
 S-1594 ELKHORN WI  
 MAR 17 1999

SCALE: 1" = 20 FEET

I hereby certify that the above described property has been surveyed by me or under my direction and that the above map is a true representation thereof and shows the size and location of the property, its exterior boundaries, the location of all visible structures and dimensions of all principal buildings thereon, boundary fences, apparent easements, roadways and visible encroachments, if any.

This survey is made for the use of the present owner of the property, and also those who purchase, mortgage, or guarantee the title thereto within one year from date hereof.

*Kenneth B. Abernathy Jr.*  
 KENNETH B. ABERNATHY, JR.  
 WISCONSIN REGISTERED LAND SURVEYOR,  
 S-1594  
 Date: March 3, 1999 Job No. 78.1102

416-1436  
 HLC-35-30