
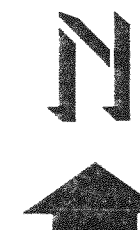


# ABELL SURVEYING & MAPPING

DELAVER, WISCONSIN 53115

414-728-6737

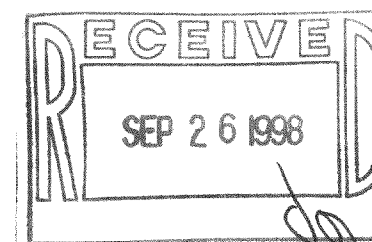

SCALE 1"=20'

## LEGEND

- - IRON PIPE FOUND
- - CONCRETE MONUMENT FOUND
- △ - UTILITY POLE
- ⊙ - UTILITY POLE ANCHOR
- - OVERHEAD UTILITY LINES
- CS - CONCRETE STOOP
- ( ) - RECORDED AS

NOTE: BEARINGS ARE REFERENCED TO THE  
RECORDED SUBDIVISION PLAT.REVISED: APRIL 9, 1996  
ORDERED BY: GLACIER REALTY  
ELKHORN, WI 53121


I HEREBY CERTIFY THAT I HAVE SURVEYED THE ABOVE DESCRIBED PROPERTY AND THAT THE ABOVE MAP IS A TRUE REPRESENTATION THEREOF AND SHOWS THE SIZE AND LOCATION OF THE PROPERTY, ITS EXTERIOR BOUNDARIES, THE LOCATION OF ALL VISIBLE STRUCTURES AND DIMENSIONS OF ALL PRINCIPAL BUILDINGS THEREON, BOUNDARY FENCES, APPARENT EASEMENTS, ROADWAYS AND VISIBLE ENCROACHMENTS, IF ANY, TO THE BEST OF MY KNOWLEDGE AND BELIEF.

THIS SURVEY IS MADE FOR THE USE OF THE PRESENT OWNERS OF THE PROPERTY, AND ALSO THOSE WHO PURCHASE, MORTGAGE, OR GUARANTEE THE TITLE THERETO WITHIN ONE (1) YEAR FROM DATE HEREON.

*David F. Abell*

DAVID F. ABELL  
WISCONSIN REGISTERED LAND SURVEYOR, S-1596

MAY 7, 1992

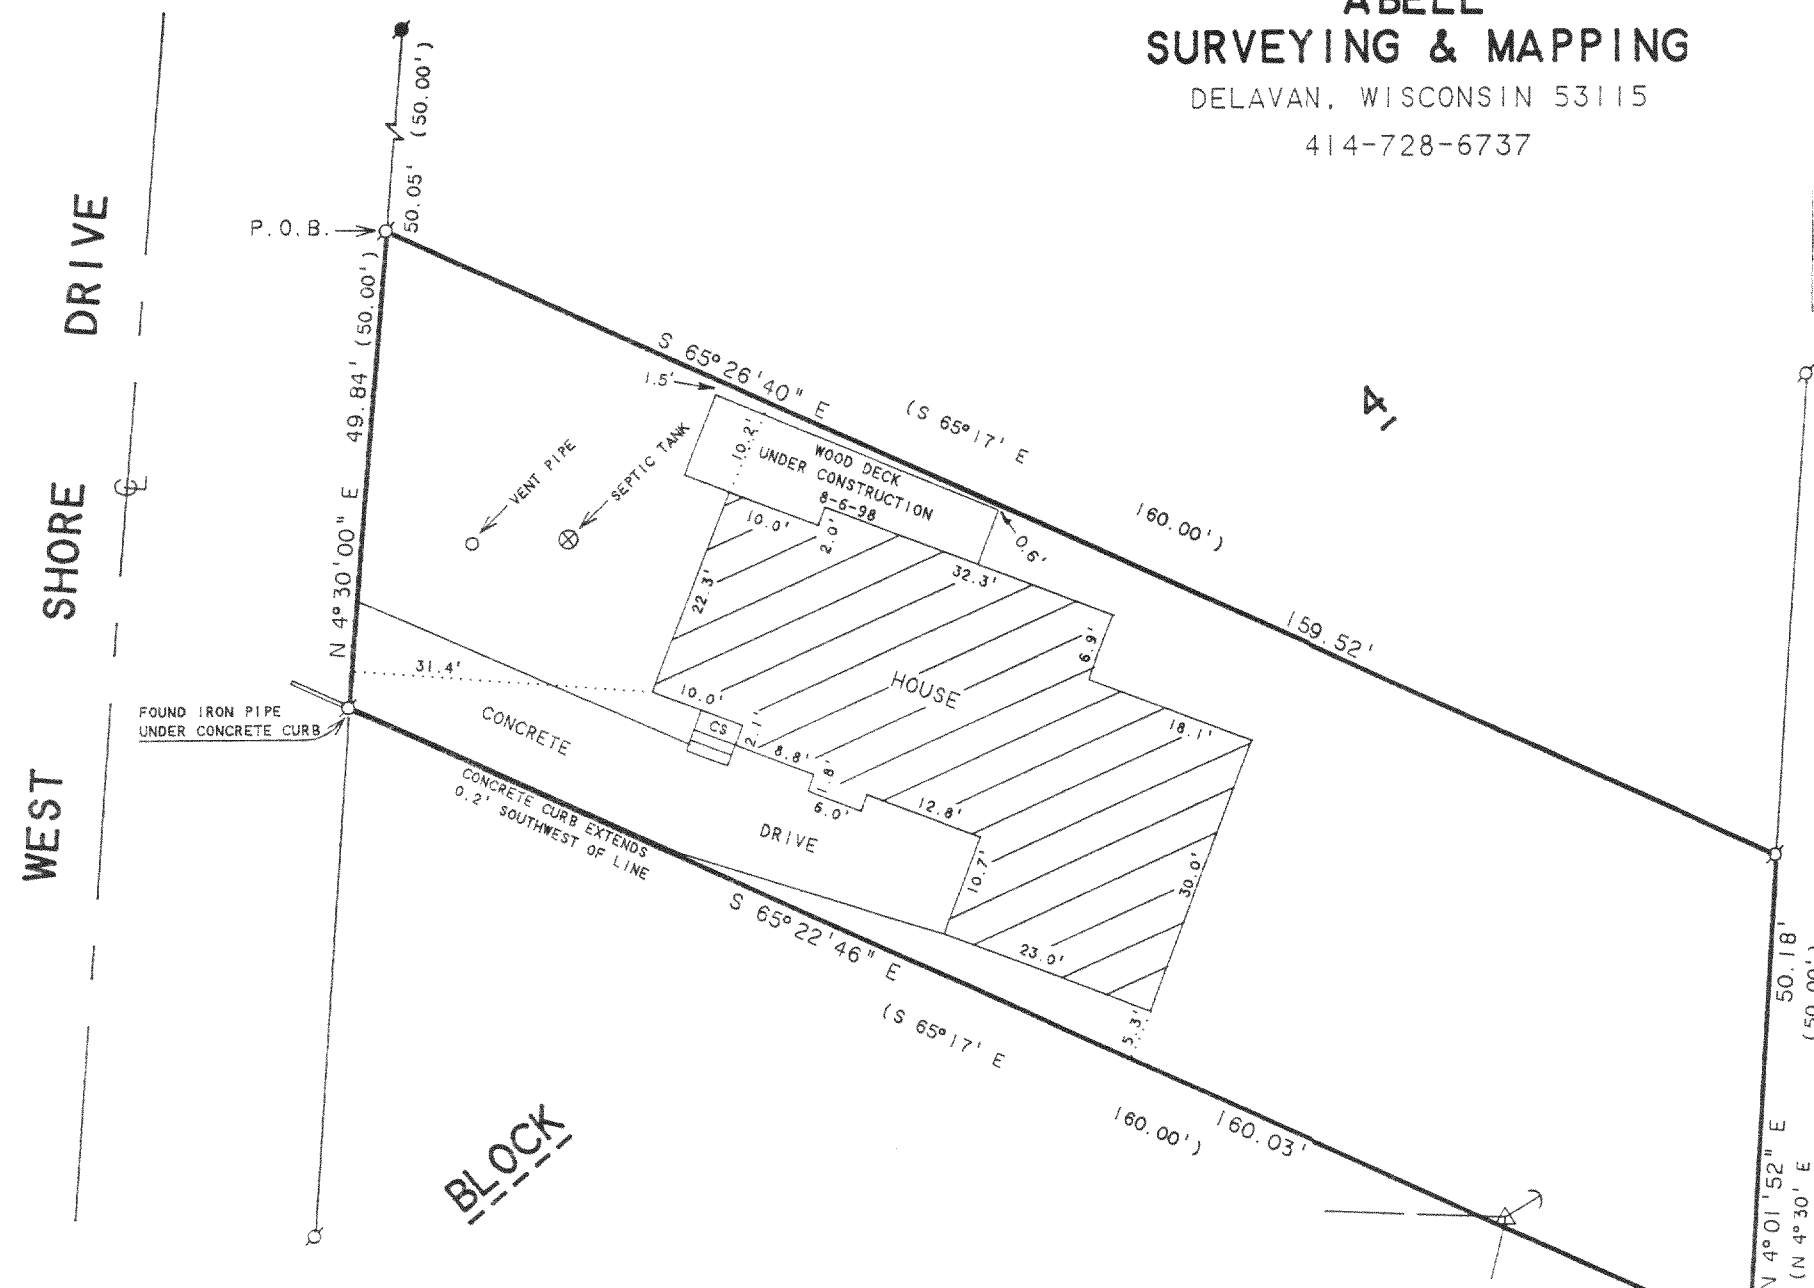DATE: \_\_\_\_\_ JOB NUMBER - 92076  
NOTE: THIS IS NOT A CERTIFIED COPY UNLESS SEALED.

## PLAT OF SURVEY OF

A PARCEL OF LAND LOCATED IN BLOCK 4 OF GREEN  
LAKE PARK SUBDIVISION LOCATED IN T4N, R16E,  
WALWORTH COUNTY, WISCONSIN.

ORDERED BY: COLONY REALTY  
16 E. WALWORTH ST.  
ELKHORN, WI. 53121REVISED DATE: AUGUST 7, 1998  
REVISED TO SHOW WOOD DECK UNDER CONSTRUCTIONORDERED BY: BILL DUDEK  
584 BRYAN STREET  
ELMHURST, IL 60126

HGP-33

416-1460

thence N 4° 30' E 50 feet to the place of beginning. (Referred to as Lot 4 Block 4). Said land being in the County of Walworth, State of Wisconsin.

Together with rights in common with the owners of certain parcels described by metes and bounds and commonly referred to as Lots 1 to 9 Block 4 Green Lake Park Subdivision, to use Lot 12 Block 2 of Green Lake Park Subdivision as a means of access to the Lake.

Also together with rights in common with the owners of said parcels to use the following parcel, to-wit:

(Parcel referred to as Forest Preserve or Lot 13 Block 4) A parcel of land located in in Block 4 of Green Lake Park Subdivision, which subdivision is located in the SW fr'l 1/4 of Section 26, T4N, R16E, described as follows, to-wit: Commencing at the S 1/4 corner of said Section 26; thence N 6° 32' E along the N-S 1/4 section line of said Section 26, 443.88 feet to the place of beginning; thence continuing N 6° 32' E along said N-S 1/4 section line 620.9 feet to a point on said line which is S 6° 32' W 170.00 feet from the NE corner of said Block 4 of Green Lake Park Subdivision; thence N 83° 28' W 290 feet; thence S 6° 32' W 40 feet; thence N 83° 28' W 217.50 feet; thence S 26° 19' W 33.72 feet; thence S 4° 30' W 145 feet; thence S 16° 14' E 50 feet; thence S 58° 23' E 30 feet; thence S 89° 46' E 40 feet; thence S 3° 54' E 80 feet to the NE'ly line of the Public Road; thence along said Public Road as follows: S 72° 38' E 55.08 feet; S 64° 00' E 58.10 feet; S 22° 33' E 108.00 feet; thence S 2° 11' W 151.40 feet to the last point on said road; thence S 84° 32' E 241.20 feet to the place of beginning. Excepting therefrom that parcel sold to the Town of LaGrange by Deed recorded in Vol. 564 of Deeds on page 85, Walworth County Records.

*David F. Abell*

DAVID F. ABELL  
WISCONSIN REGISTERED LAND SURVEYOR. S-1596

REVISED: AUGUST 7, 1998

MAY 7, 1992

REVISED: APRIL 9, 1996

DATE JOB NUMBER - 92076  
NOTE: THIS IS NOT A CERTIFIED COPY UNLESS SEALED.