

Plat of Survey

of




Lot 16, of Maywoods Subdivision, located in the Southeast $\frac{1}{4}$ of Section 26,
T 4 N, R 16 E, Town of LaGrange, Walworth County, Wisconsin,

also

A parcel of land located in Lot "E" of Solid Comfort, a subdivision on
Lauderdale Lakes located in fractional Section 26, T 4 N, R 16 E, Walworth
County, Wisconsin, described as follows: Beginning at the southwest
corner of said Lot "E"; thence N16°23'30"E along the westerly line of said
lot, 42.02 feet; thence N35°41'54"E along the westerly line of said Lot "E",
35.57 feet; thence S89°35'54"E 76.18 feet; thence S21°20'24"E 43.41 feet
to the northwesterly line of a blacktop road; thence S48°45'12"W along said
road 43.78 feet to the south line of said Lot "E" and the northeast corner
of Lot 16, The Maywoods; thence N89°36'18"W 91.72 feet to the place of
beginning.

Surveyed for: **John Summerfield**
101 South Washington Street
Park Ridge, Illinois. 60068-4258

Bearings referenced to
previous surveys.

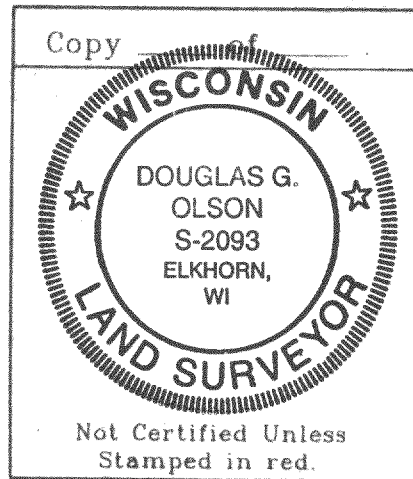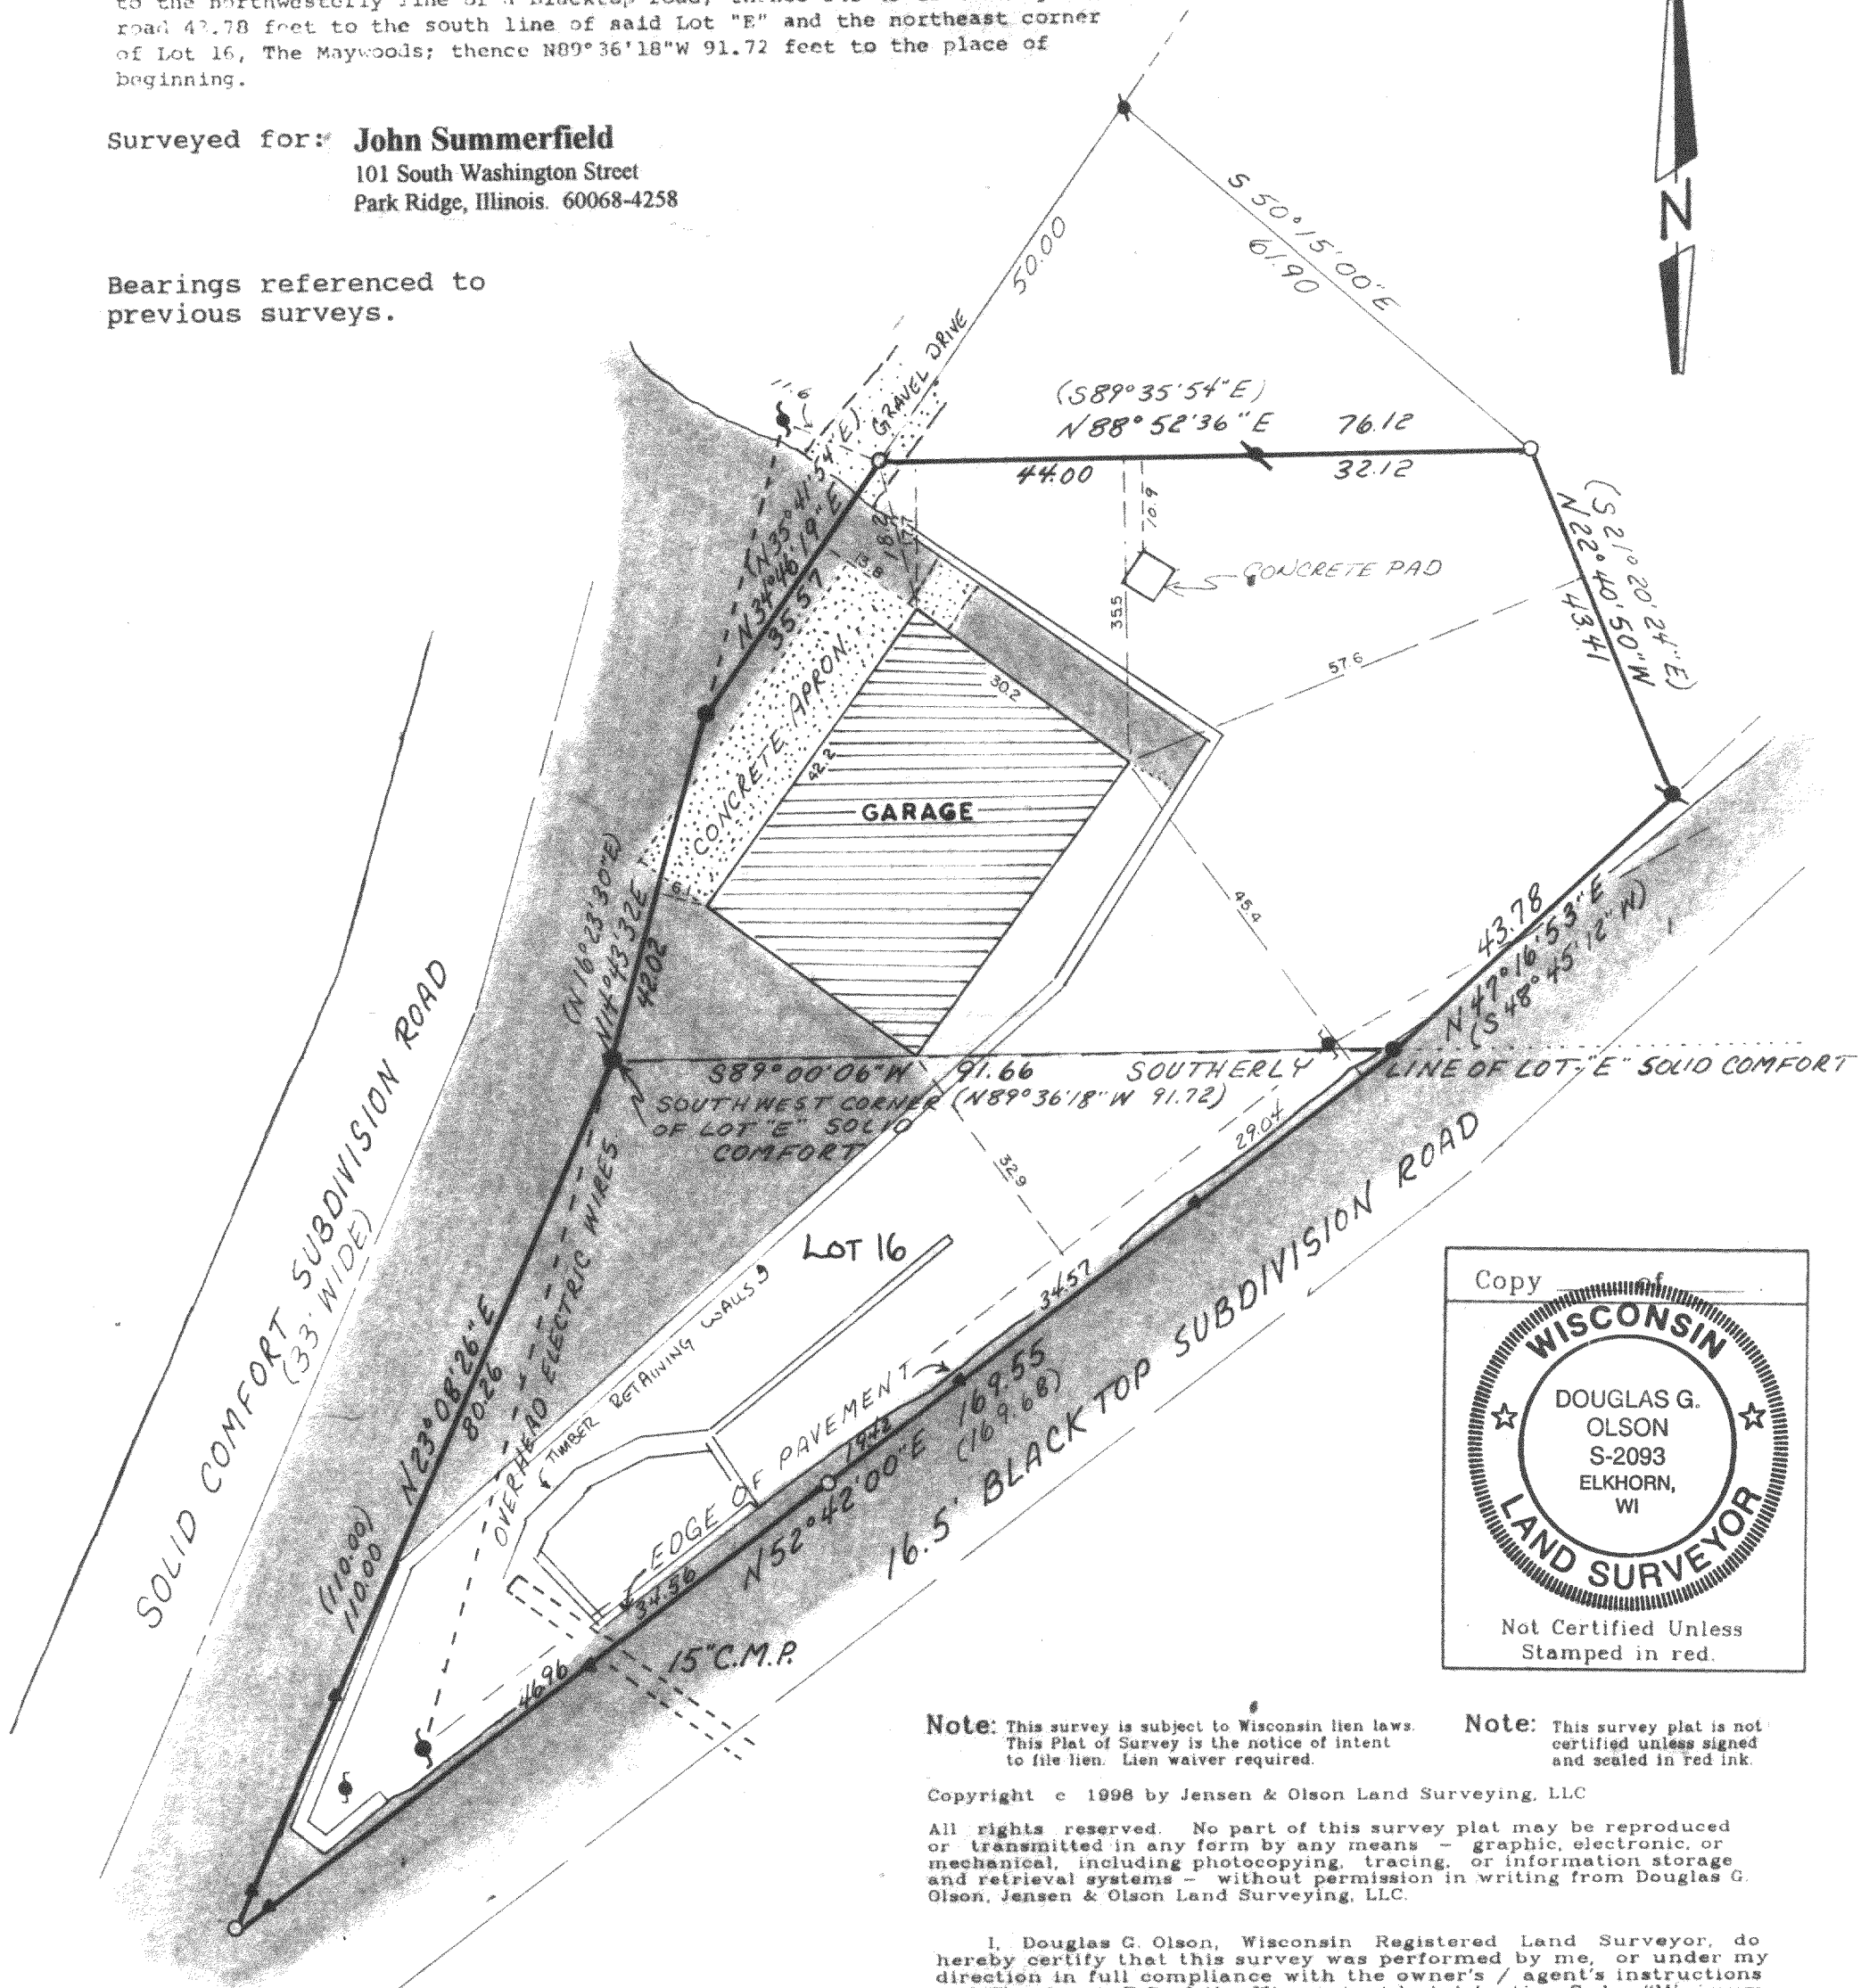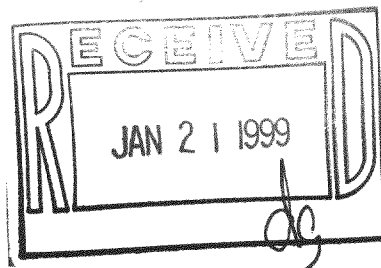

Note: This survey is subject to Wisconsin lien laws.
This Plat of Survey is the notice of intent
to file lien. Lien waiver required.

Note: This survey plat is not
certified unless signed
and sealed in red ink.

Copyright © 1998 by Jensen & Olson Land Surveying, LLC


All rights reserved. No part of this survey plat may be reproduced
or transmitted in any form by any means - graphic, electronic, or
mechanical, including photocopying, tracing, or information storage
and retrieval systems - without permission in writing from Douglas G.
Olson, Jensen & Olson Land Surveying, LLC.

I, Douglas G. Olson, Wisconsin Registered Land Surveyor, do
hereby certify that this survey was performed by me, or under my
direction in full compliance with the owner's / agent's instructions
and Chapter A-E 7 of the Wisconsin Administrative Code "Minimum
Standards for Property Surveys"; and that this map is as accurate
representation thereof to the best of my knowledge and belief.

Date: 12-23-98

Douglas G. Olson

R.L.S. 2093

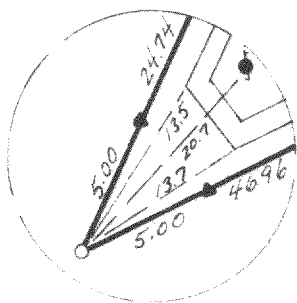

▽ = Found RR Spike
● = Found P.K. Nail

Legend

- = Found iron pipe
- ⌘ = Found iron rod
- () = Recorded as dimension
- = Blacktop surface
- ▨ = Concrete surface
- ⚡ = Utility pole

Jensen & Olson Land Surveying, LLC

45 South Wisconsin Street P.O. Box 322

Elkhorn, Wisconsin. 53121

Telephone: (414) 723-3434

Facsimile: (414) 723-8044

Mapping date: 12-23-98

Revisions: _____

Sheet 1 of 2 Sheets

Job reference number:

1998.110

Scale: 1" = 20'

