


ABERNATHY and ASSOCIATES

Kenneth B. Abernathy Jr.

Wisconsin Registered Land Surveyor S-1594

Rt. 3, Box 273
Elkhorn, Wisconsin 53121
Phone: (414) 723-4260 (office)
(414) 723-4813 (residence)

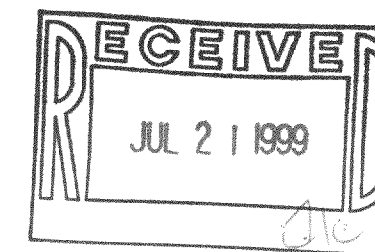

SCALE: 1" = 30 FEET

Legend

- FOUND IRON PIPE
- FOUND IRON ROD
- FOUND BRASS CAPPED MONUMENT
- FOUND CONCRETE MONUMENT
- CHISEL CUT IN CONCRETE
- SET IRON ROD, 24" LONG, WEIGHING 1.5 LBS./LINEAL FT., 3/4" DIA.
- SET IRON ROD, 30" LONG, WEIGHING 4.5 LBS./LINEAL FT., 1-11/16" DIA.
- (xx) RECORDED AS DIMENSION
- x-x- EXISTING FENCE

"I hereby certify that I have surveyed the above described property and that the above map is a true representation thereof and shows the size and location of the property, its exterior boundaries, the location of all visible structures and dimensions of all principal buildings thereon, boundary fences, apparent easements, roadways and visible encroachments, if any."

"This survey is made for the use of the present owners of the property, and also those who purchase, mortgage, or guarantee the title thereto within one year from date hereof."

Kenneth B. Abernathy, Jr.

KENNETH B. ABERNATHY, JR.
WISCONSIN REGISTERED LAND SURVEYOR,
S-1594

Date: 6-11-99 Job No. 99.519

PLAT OF SURVEY

LOT 6 OF BLOCK 1 OF BAY VIEW
MANOR SUBDIVISION, LOCATED IN
SECTION 26, TOWN 4 NORTH,
RANGE 16 EAST, TOWN OF
LAGRANGE, WALWORTH COUNTY,
WISCONSIN.

ORDERED BY: JOHN PINI
REMAX REALTY
101 BROAD ST. SUITE 102
LAKE GENEVA, WI. 53147

OWNERS: WILLIAM AND IRENE DRABANT
9001 N. ORIOLE AVE.
MORTON GROVE, IL. 60053

LOT 5

BLOCK

LOT 6
13,881 SQ. FT.

LOT 1
C.S.M. # 575

MILL LAKE
STERLINGWORTH BAY

EXISTING PIER

100.2'±
SHORELINE LENGTH

SCALE 1" = 30 FEET

PLATTED NORTH

50' WIDE PUBLIC ROAD

SHORE

BAY

BEARING BASIS FOR THIS PLAT

(N 21°39'E 50.00')
49.98'
(N 21°39'00"E

util. ped

util. ped
power pole

SOIL TEST AREA

123.89' S 59°04'00" E (185.91')
(123.91') 185.29'

61.40'±
(62.0')

(N 10°40'00" E 91.02')
(N 10°39'E 91.00')

(151.82')
151.70' N 45°19'00" W 189.90'±
(S 45°21'E 196.02')

(44.2'±)
38.20'

HB-6 416-1501