

SELLER: Myint T. Singh

BUYER: Wolf Korndoerfer


LEGAL DESCRIPTION (AS FURNISHED)..... Lot 3 Certified Survey Map No. 847, according to the plat thereof recorded in Volume 6 of Certified Survey Map on Page 32, as Document No. 38818, ALSO Commencing at the Southeast corner of Lot 4, North 1°34' West 66 feet, South 88°26' West 154 feet, North 83 feet to the point of beginning, North 69°36'34" West 17.50 feet South 19°30' East 49.14 feet, North 40.22 feet to the point of beginning. EXCEPTING land described in Quit Claim dated December 10, 1993 and recorded in the office of the Register of Deeds for Walworth County, Wisconsin on February 22, 1994 in Volume 628 of Records, at page 7721, as Document No. 279291. Said land being in the Town of LaGrange, County of Walworth, State of Wisconsin.

J.K.R. SURVEYING, INC.
8121 22ND AVENUE, KENOSHA, WI. 53143

tax key no.: HA847 00003

I hereby certify that the above described property was surveyed under my direction and that this plat is a true representation thereof and shows the size and location of the property, its exterior boundaries, the location and dimensions of all visible structures thereon, fences, apparent easements and roadways and visible encroachments, if any.

This survey is made for the exclusive use of the present owners of the property, and those who purchase, mortgage or guarantee the title thereto, within one (1) year from the date hereof.

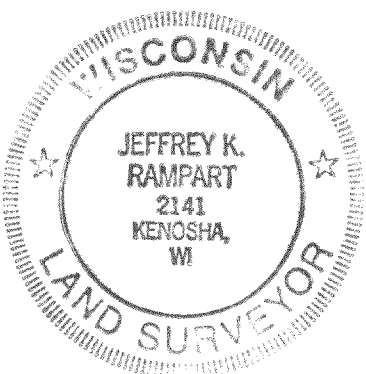

Jeffrey K. Rampart
SURVEYOR
May 8, 2000

Plat of Survey of
LOT 3 OF
CERTIFIED SURVEY MAP NO. 847
in NW1/4 Section 35-4-16

TOWN OF LAGRANGE
WALWORTH COUNTY, WIS.

-for-
Korndoerfer Development

416-1569

HA-847-3