

WALWORTH COUNTY
 SURVEYING & MAPPING
 P. O. BOX 1115
 LAKE GENEVA, WISCONSIN 53147
 414-248-0505

PLAT OF SURVEY OF

LOTS "B" AND "C" OF CERTIFIED SURVEY MAP
 NO. 884, LOCATED IN THE SOUTHWEST 1/4 OF
 SECTION 2, T 4 N, R 16 E, WALWORTH COUNTY,
 WISCONSIN.

ORDERED BY: CENTURY 21 ZENK REALTY
 804 NORTH WISCONSIN STREET
 ELKHORN, WISCONSIN
 53121

GRAPHIC SCALE



(IN FEET)
 1 inch = 50 ft.

- ⊘-IRON PIPE FOUND
- ∅-IRON ROD FOUND
- CONCRETE MONUMENT FOUND
- IRON PIPE PLACED
- ()-RECORDED AS


I HEREBY CERTIFY THAT I HAVE SURVEYED THE ABOVE DESCRIBED
 PROPERTY AND THAT THE ABOVE MAP IS A TRUE REPRESENTATION
 THEREOF AND SHOWS THE SIZE AND LOCATION OF THE PROPERTY,
 ITS EXTERIOR BOUNDARIES, THE LOCATION OF ALL VISIBLE STRUCTURES
 AND DIMENSIONS OF ALL PRINCIPAL BUILDINGS THEREON, BOUNDARY
 FENCES, APPARENT EASEMENTS, ROADWAYS AND VISIBLE ENCROACH-
 MENTS, IF ANY, TO THE BEST OF MY KNOWLEDGE AND BELIEF.

THIS SURVEY IS MADE FOR THE USE OF THE PRESENT OWNERS OF
 THE PROPERTY AND ALSO THOSE WHO PURCHASE, MORTGAGE OR
 QUARANTEE THE TITLE THERETO WITHIN ONE (1) YEAR FROM DATE
 HEREOF.

Robert M. Baerenwald
 ROBERT M. BAERENWALD
 WISCONSIN REGISTERED LAND SURVEYOR, S-1508

DATE June 10, 1998 JOB NO. 5849

NOTE: THIS IS NOT A CERTIFIED COPY UNLESS SEALED.

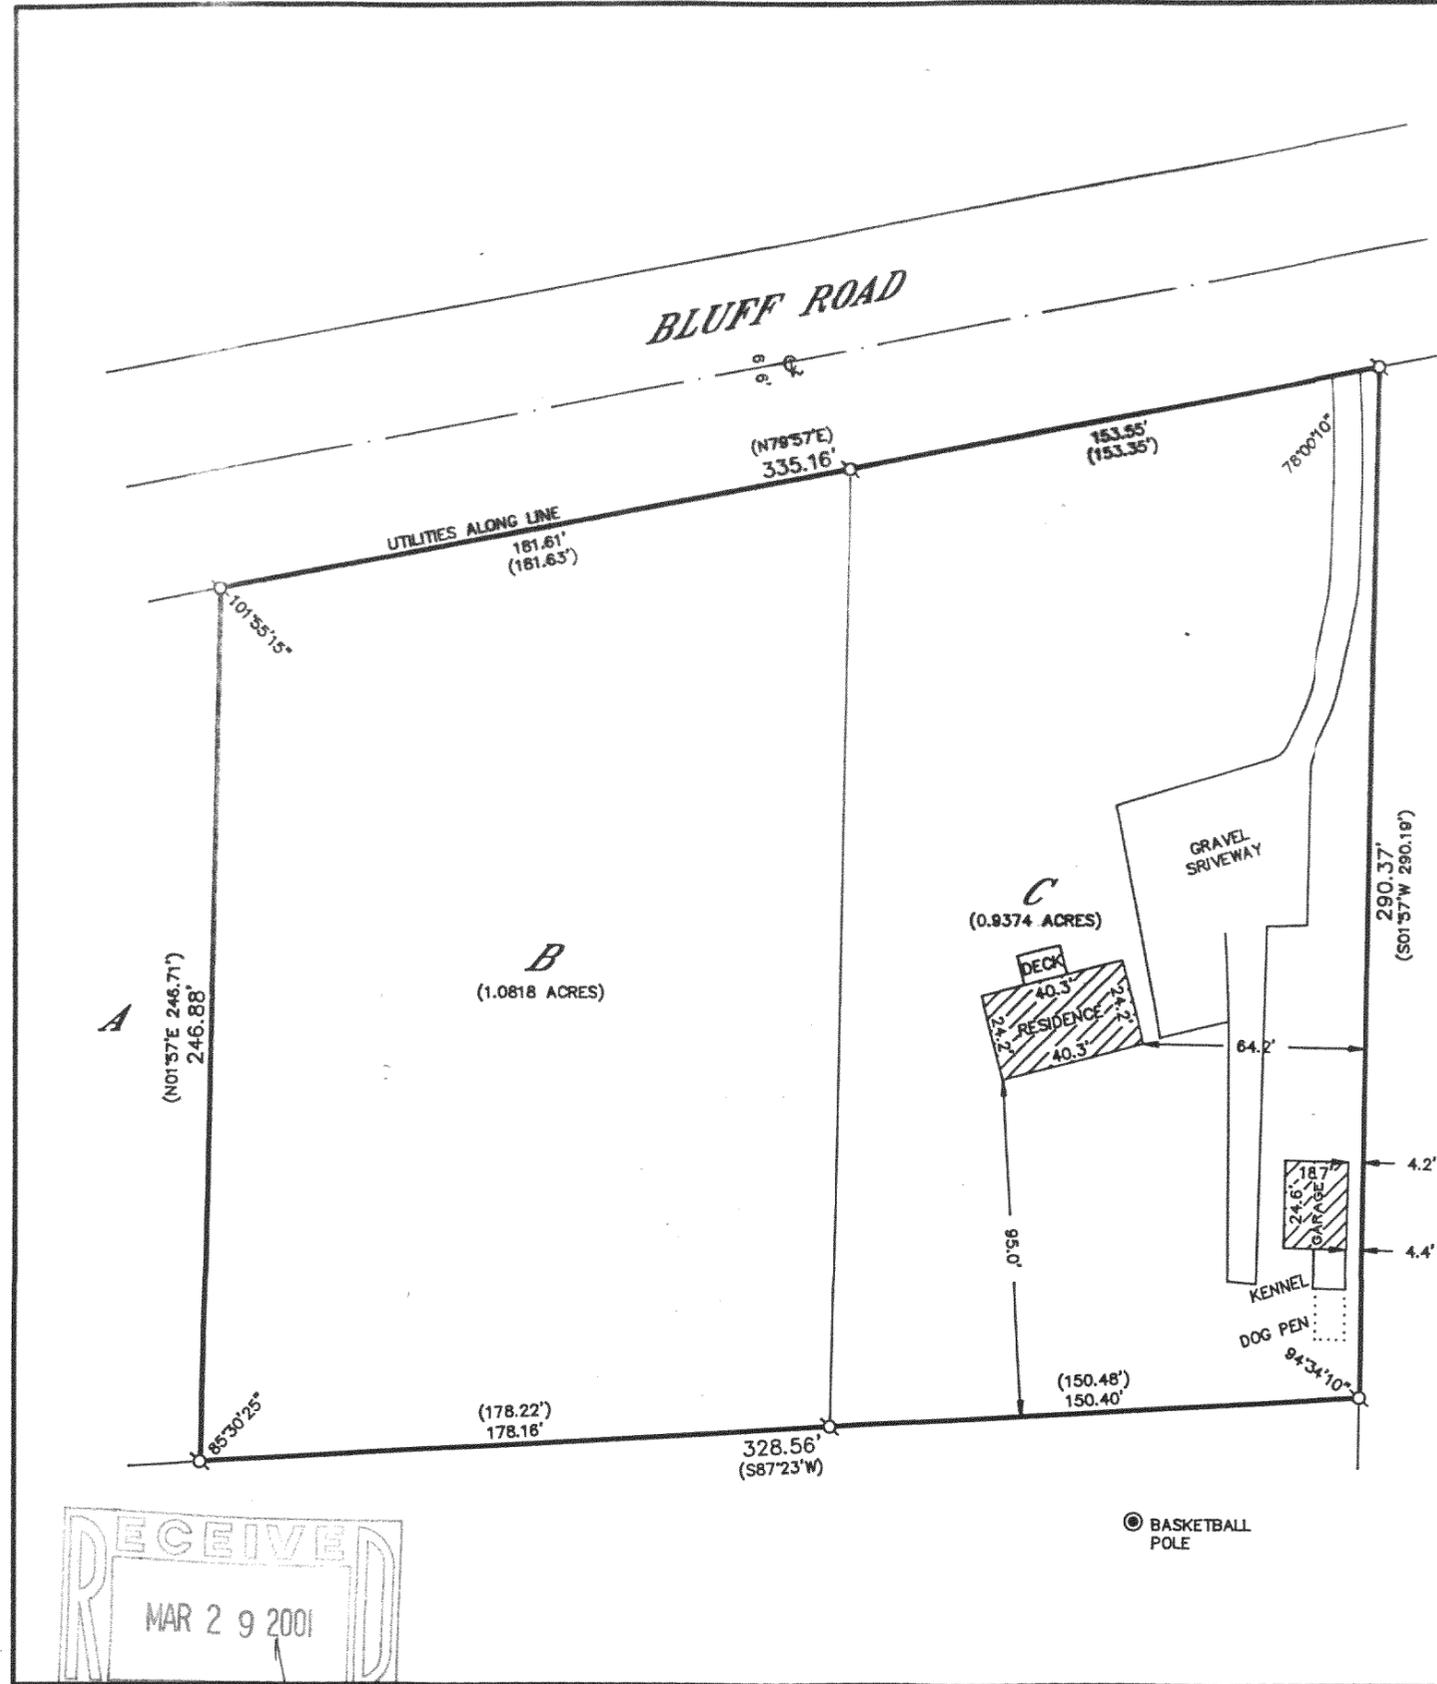

HA-884-2 HA-884-3

416-1680