


PREPARED FOR:
CENTURY 21 ZENK REALTY, LLC
804 N. WISCONSIN STREET
ELKHORN, WI, 53121

PLAT OF SURVEY

J.K. SURVEYING INC.
N3705 WILLOWBEND LANE
LAKE GENEVA, WI, 53147
262-248-3697

- OF -

LOT 19 AS CORRECTED BY INSTRUMENT RECORDED AS DOCUMENT #45131-000,
IN GLADHURST SUBDIVISION, A SUBDIVISION LOCATED IN THE SE 1/4 OF SECTION
23, SW 1/4 OF SECTION 24, NW 1/4 OF SECTION 25, AND NE 1/4 OF SECTION 26,
TOWN 4 NORTH, RANGE 16 EAST, TOWN OF LAGRANGE, WALWORTH COUNTY,
WISCONSIN.


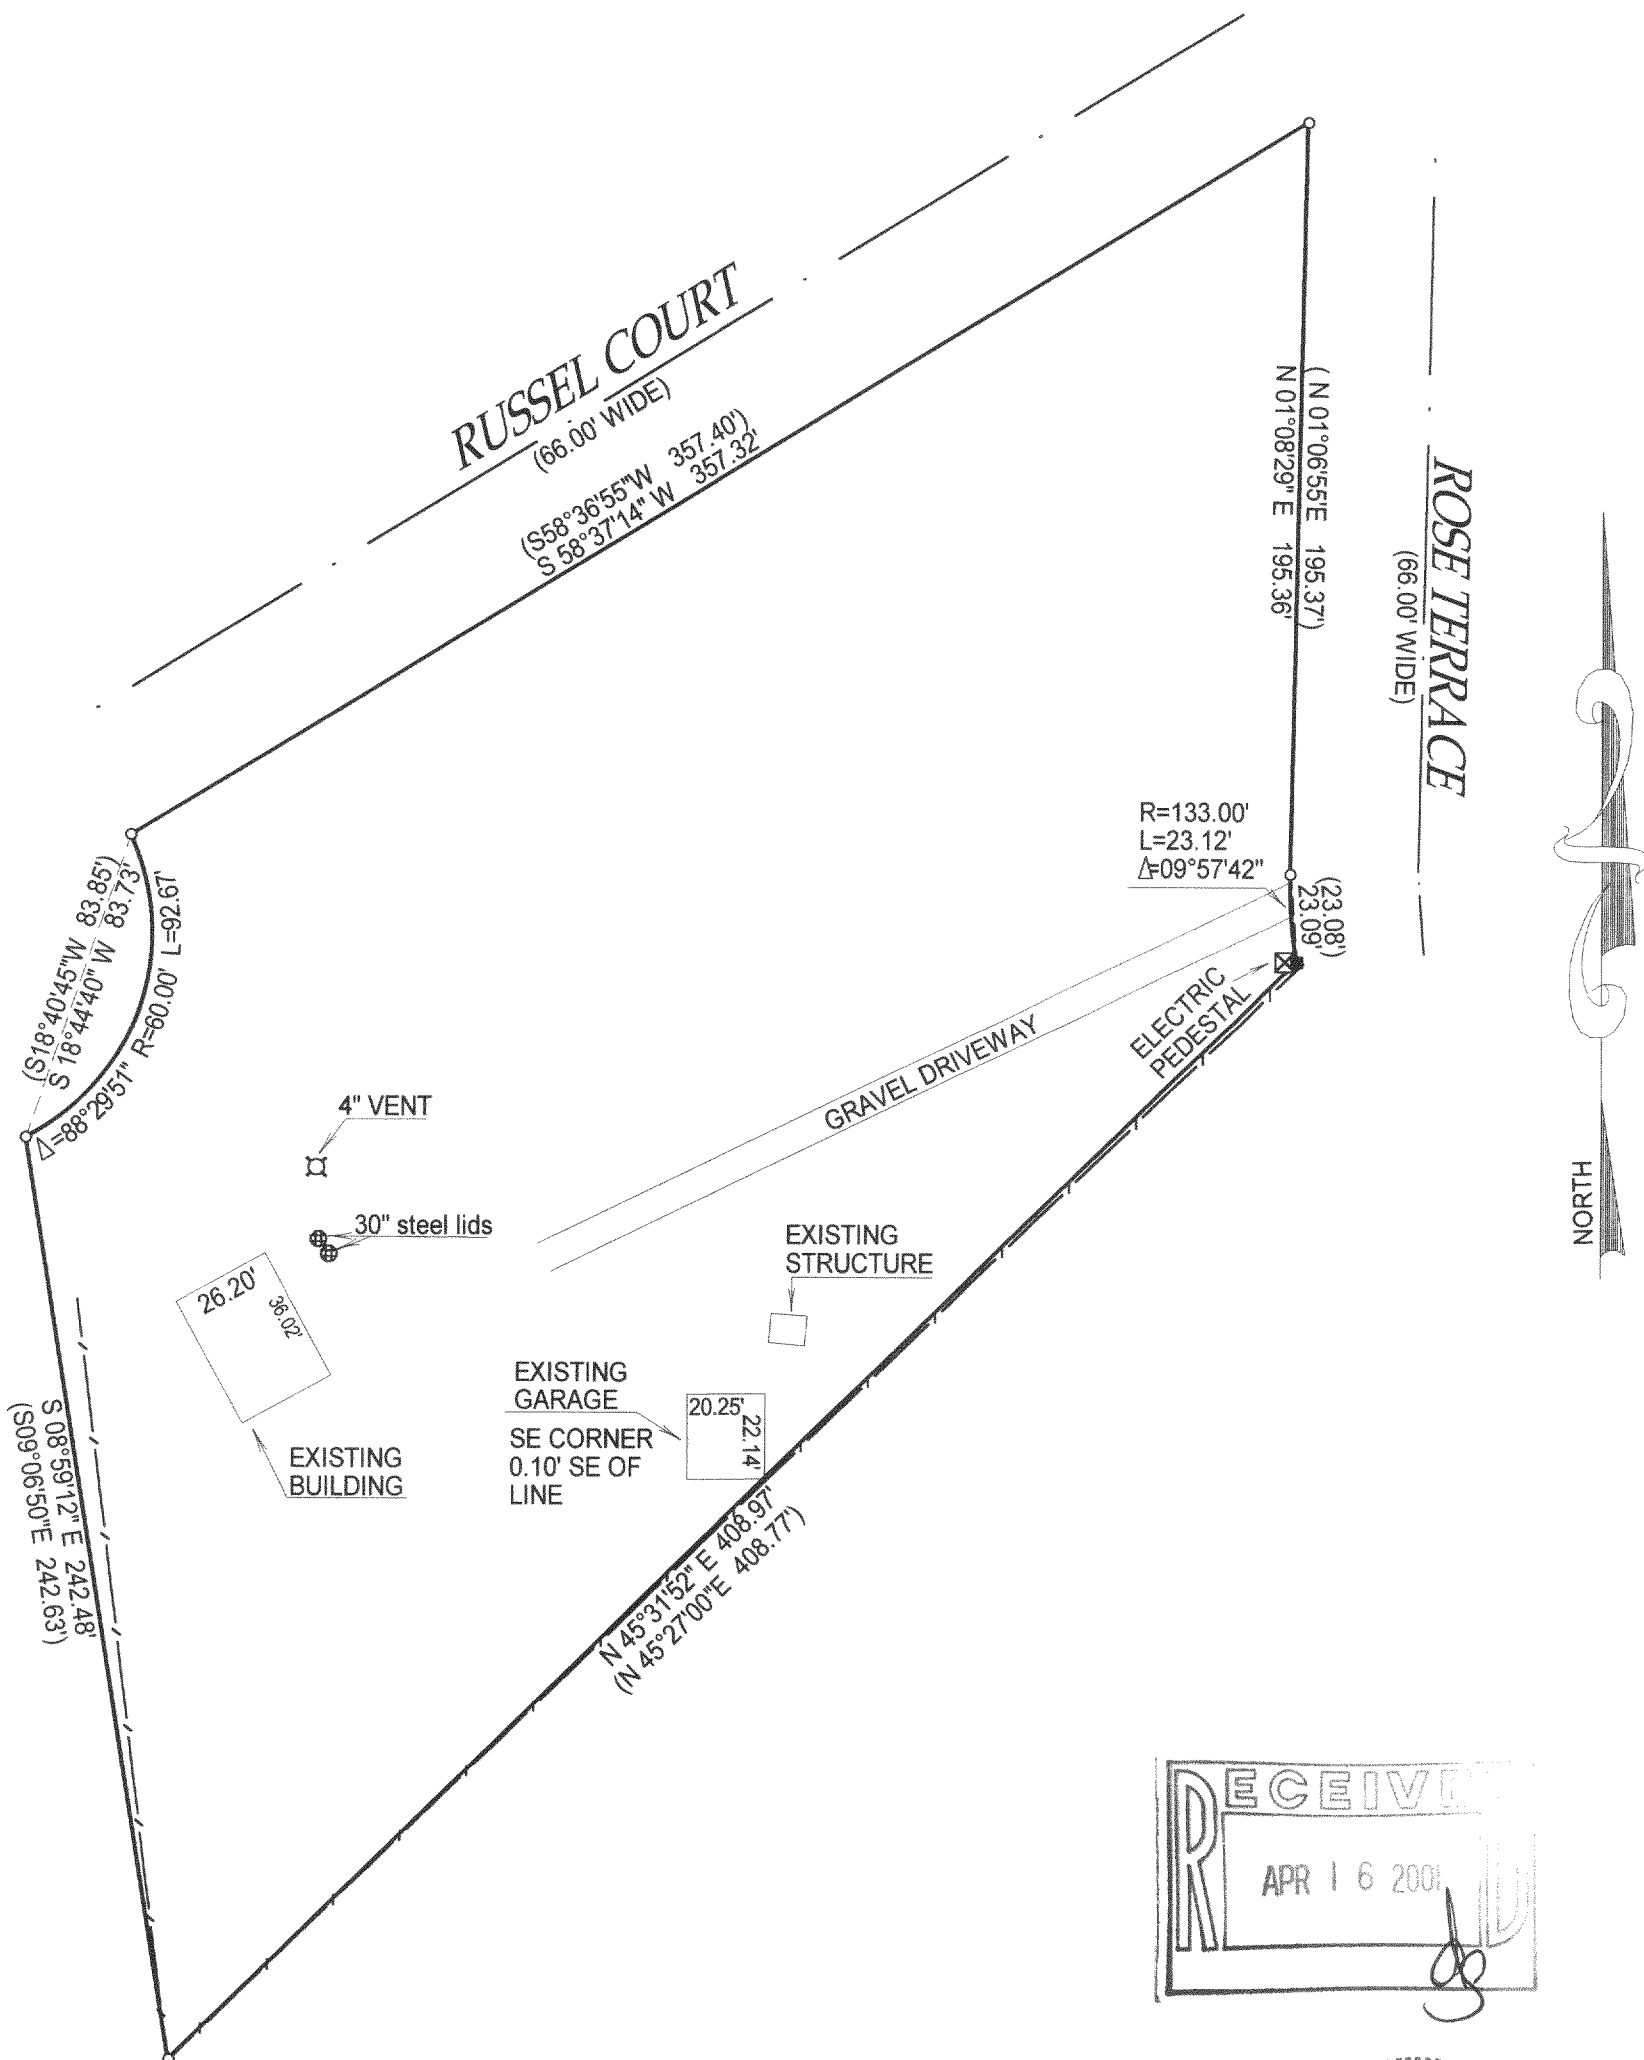


() = recorded as
□ = found iron bar
○ = found iron pipe
● = set iron pipe
■ = set iron bar
SCALE 1" = 50'
JOB # 01-041
TAX ID # 4-16-HG-19

COMPARE LEGAL DESCRIPTION ABOVE AND DRAWING WITH DEED. FOR BUILDING RESTRICTIONS AND EASEMENTS NOT SHOWN, REFER TO DEED, ABSTRACT SOURCES AND LOCAL MUNICIPAL CODES. NOTIFY THE SURVEYOR IMMEDIATELY OF ANY DISCREPANCY.

"I hereby certify that I have surveyed the above described property and that the above map is a true representation thereof and shows the size and location of all visible structures, apparent easements and encroachments if any."
This survey is made for the present owners of the property, and those who purchase, mortgage, or guarantee the title thereto, within one year from the date hereof.

DATED THIS 22 TH, DAY OF FEBRUARY 20 01 .

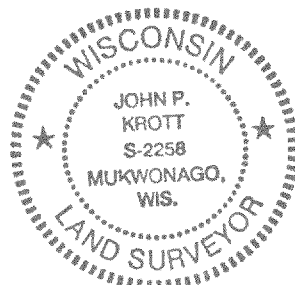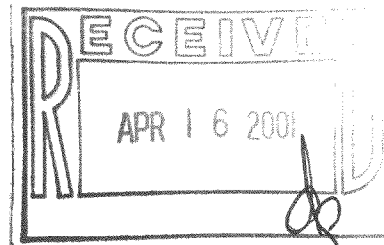

John P. Krott
JOHN KROTT S - 2258
Wisconsin Registered Land Surveyor
(original if signed in red)

HG-19

416-1685