
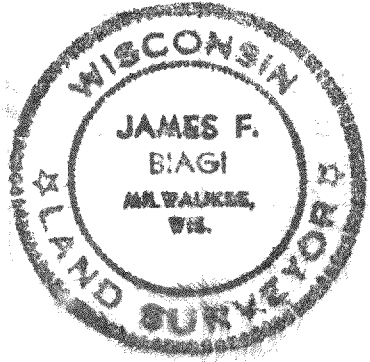


416-170B

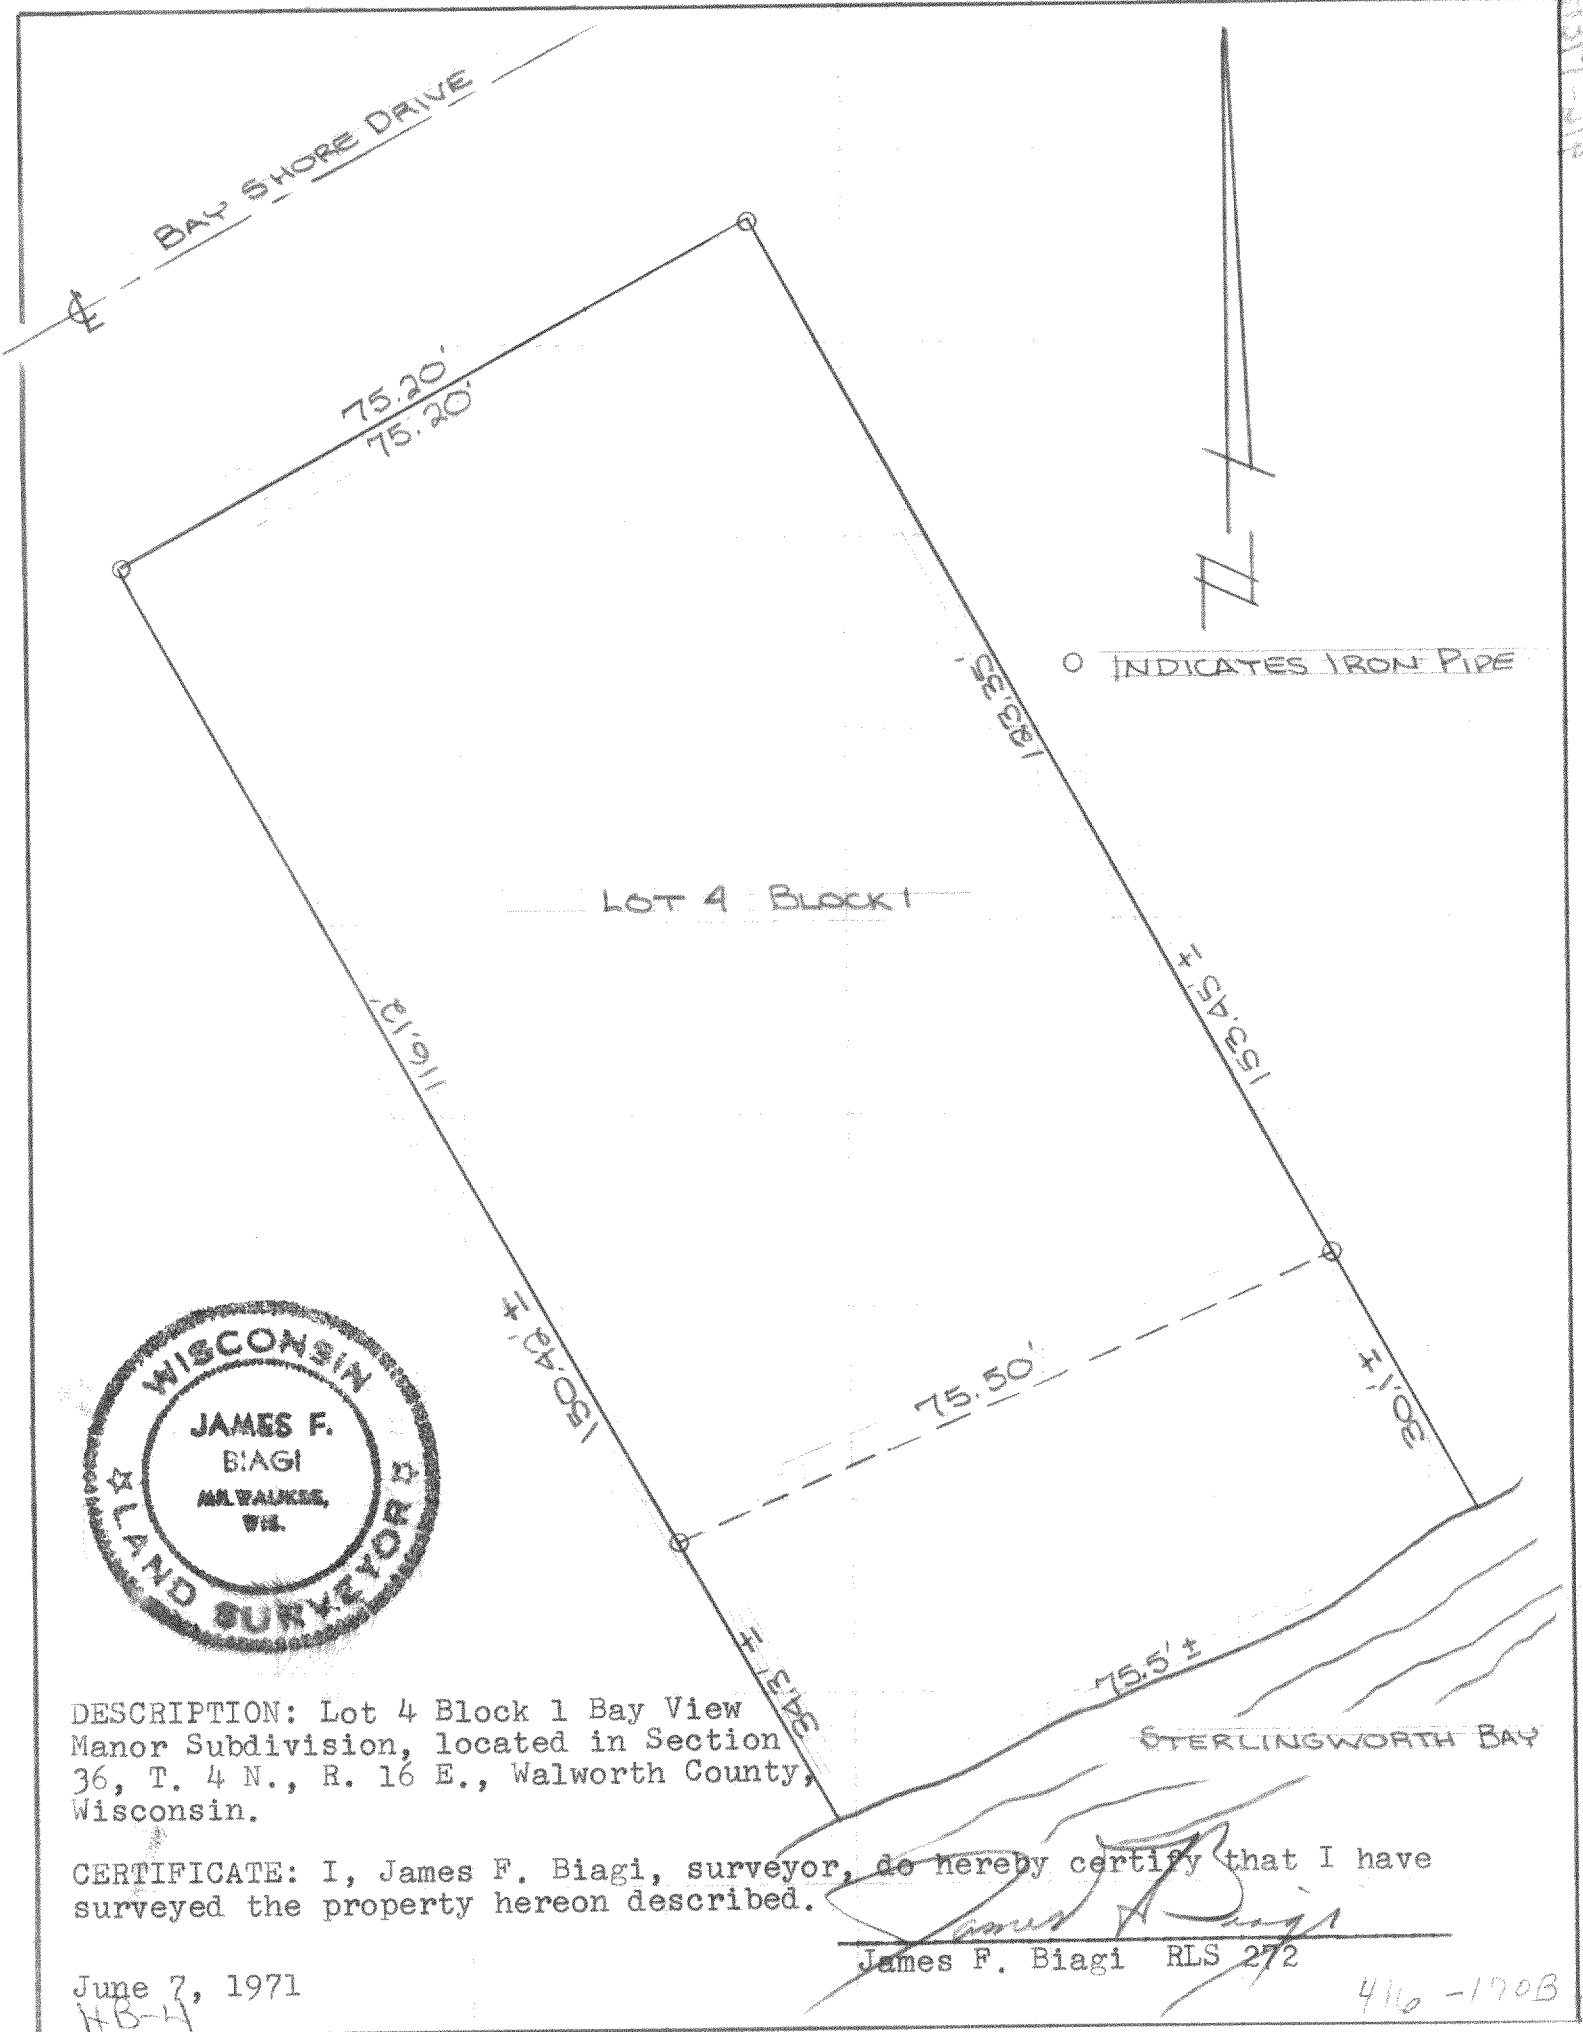

DESCRIPTION: Lot 4 Block 1 Bay View Manor Subdivision, located in Section 36, T. 4 N., R. 16 E., Walworth County, Wisconsin.

CERTIFICATE: I, James F. Biagi, surveyor, do hereby certify that I have surveyed the property hereon described.

James F. Biagi
 James F. Biagi RLS 272

June 7, 1971

416-170B

HB-4