



PLAT OF SURVEY

PART OF LOT 11 OF LA SELVA SUBDIVISION

LOCATED IN SECTION 26, TOWN 4 NORTH, RANGE 16 EAST,
WALWORTH COUNTY, WISCONSIN

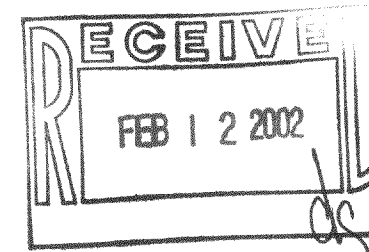

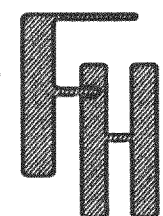

PLAT OF SURVEY

— WORK ORDERED BY —
CINDY KNUITSON — KNUITSON BUILDERS
W.792 POTTERS CIRCLE
EAST TROY, WI. 53120

FARRIS, HANSEN & ASSOCIATES, INC.
ENGINEERING — ARCHITECTURE — SURVEYING
7 RIDGWAY COURT P.O. BOX 437
ELKHORN, WISCONSIN 53121
OFFICE: (262) 723-2098 FAX: (262) 723-5886

REVISIONS

--	--

PROJECT NO.
5902


DATE:
10/11/2001

SHEET NO.
1 OF 1


All of Lot 11 in the Plat of LaSelva, except a strip of land off the SW'ly side of said Lot 11, measuring 10 feet in width at the lake shore and 15 feet at the SW'ly end of said lot. Excepting from the above-described parcel a second strip off of the W. side of the remaining land to be conveyed, said strip of land described as follows: Commencing at a point on the NW corner of Lot 11 of LaSelva as originally platted; thence E'ly along the lake shore 10 feet to the point of beginning; thence E'ly along the lake shore 2 feet in a general NE'ly direction to a point; thence SE'ly 84 feet more or less to a point in the S. lot line of Lot 11, which point is 27 feet from the SW'ly corner stake of Lot 11 of LaSelva, as originally platted; thence along said lot line in a SW'ly direction 12 feet to a point on the S. line of said Lot 11, thence in a generally N'ly direction 84 feet more or less to the place of beginning. Town of La Grange.

This deed is given in fulfillment of a certain land contract between the above parties dated September 17, 1982 and recorded on September 20, 1982 in the office of the Register of Deeds for Walworth County in Vol. 290, Page 856, as Document No. 82300.

LEGAL DESCRIPTION OF RECORD

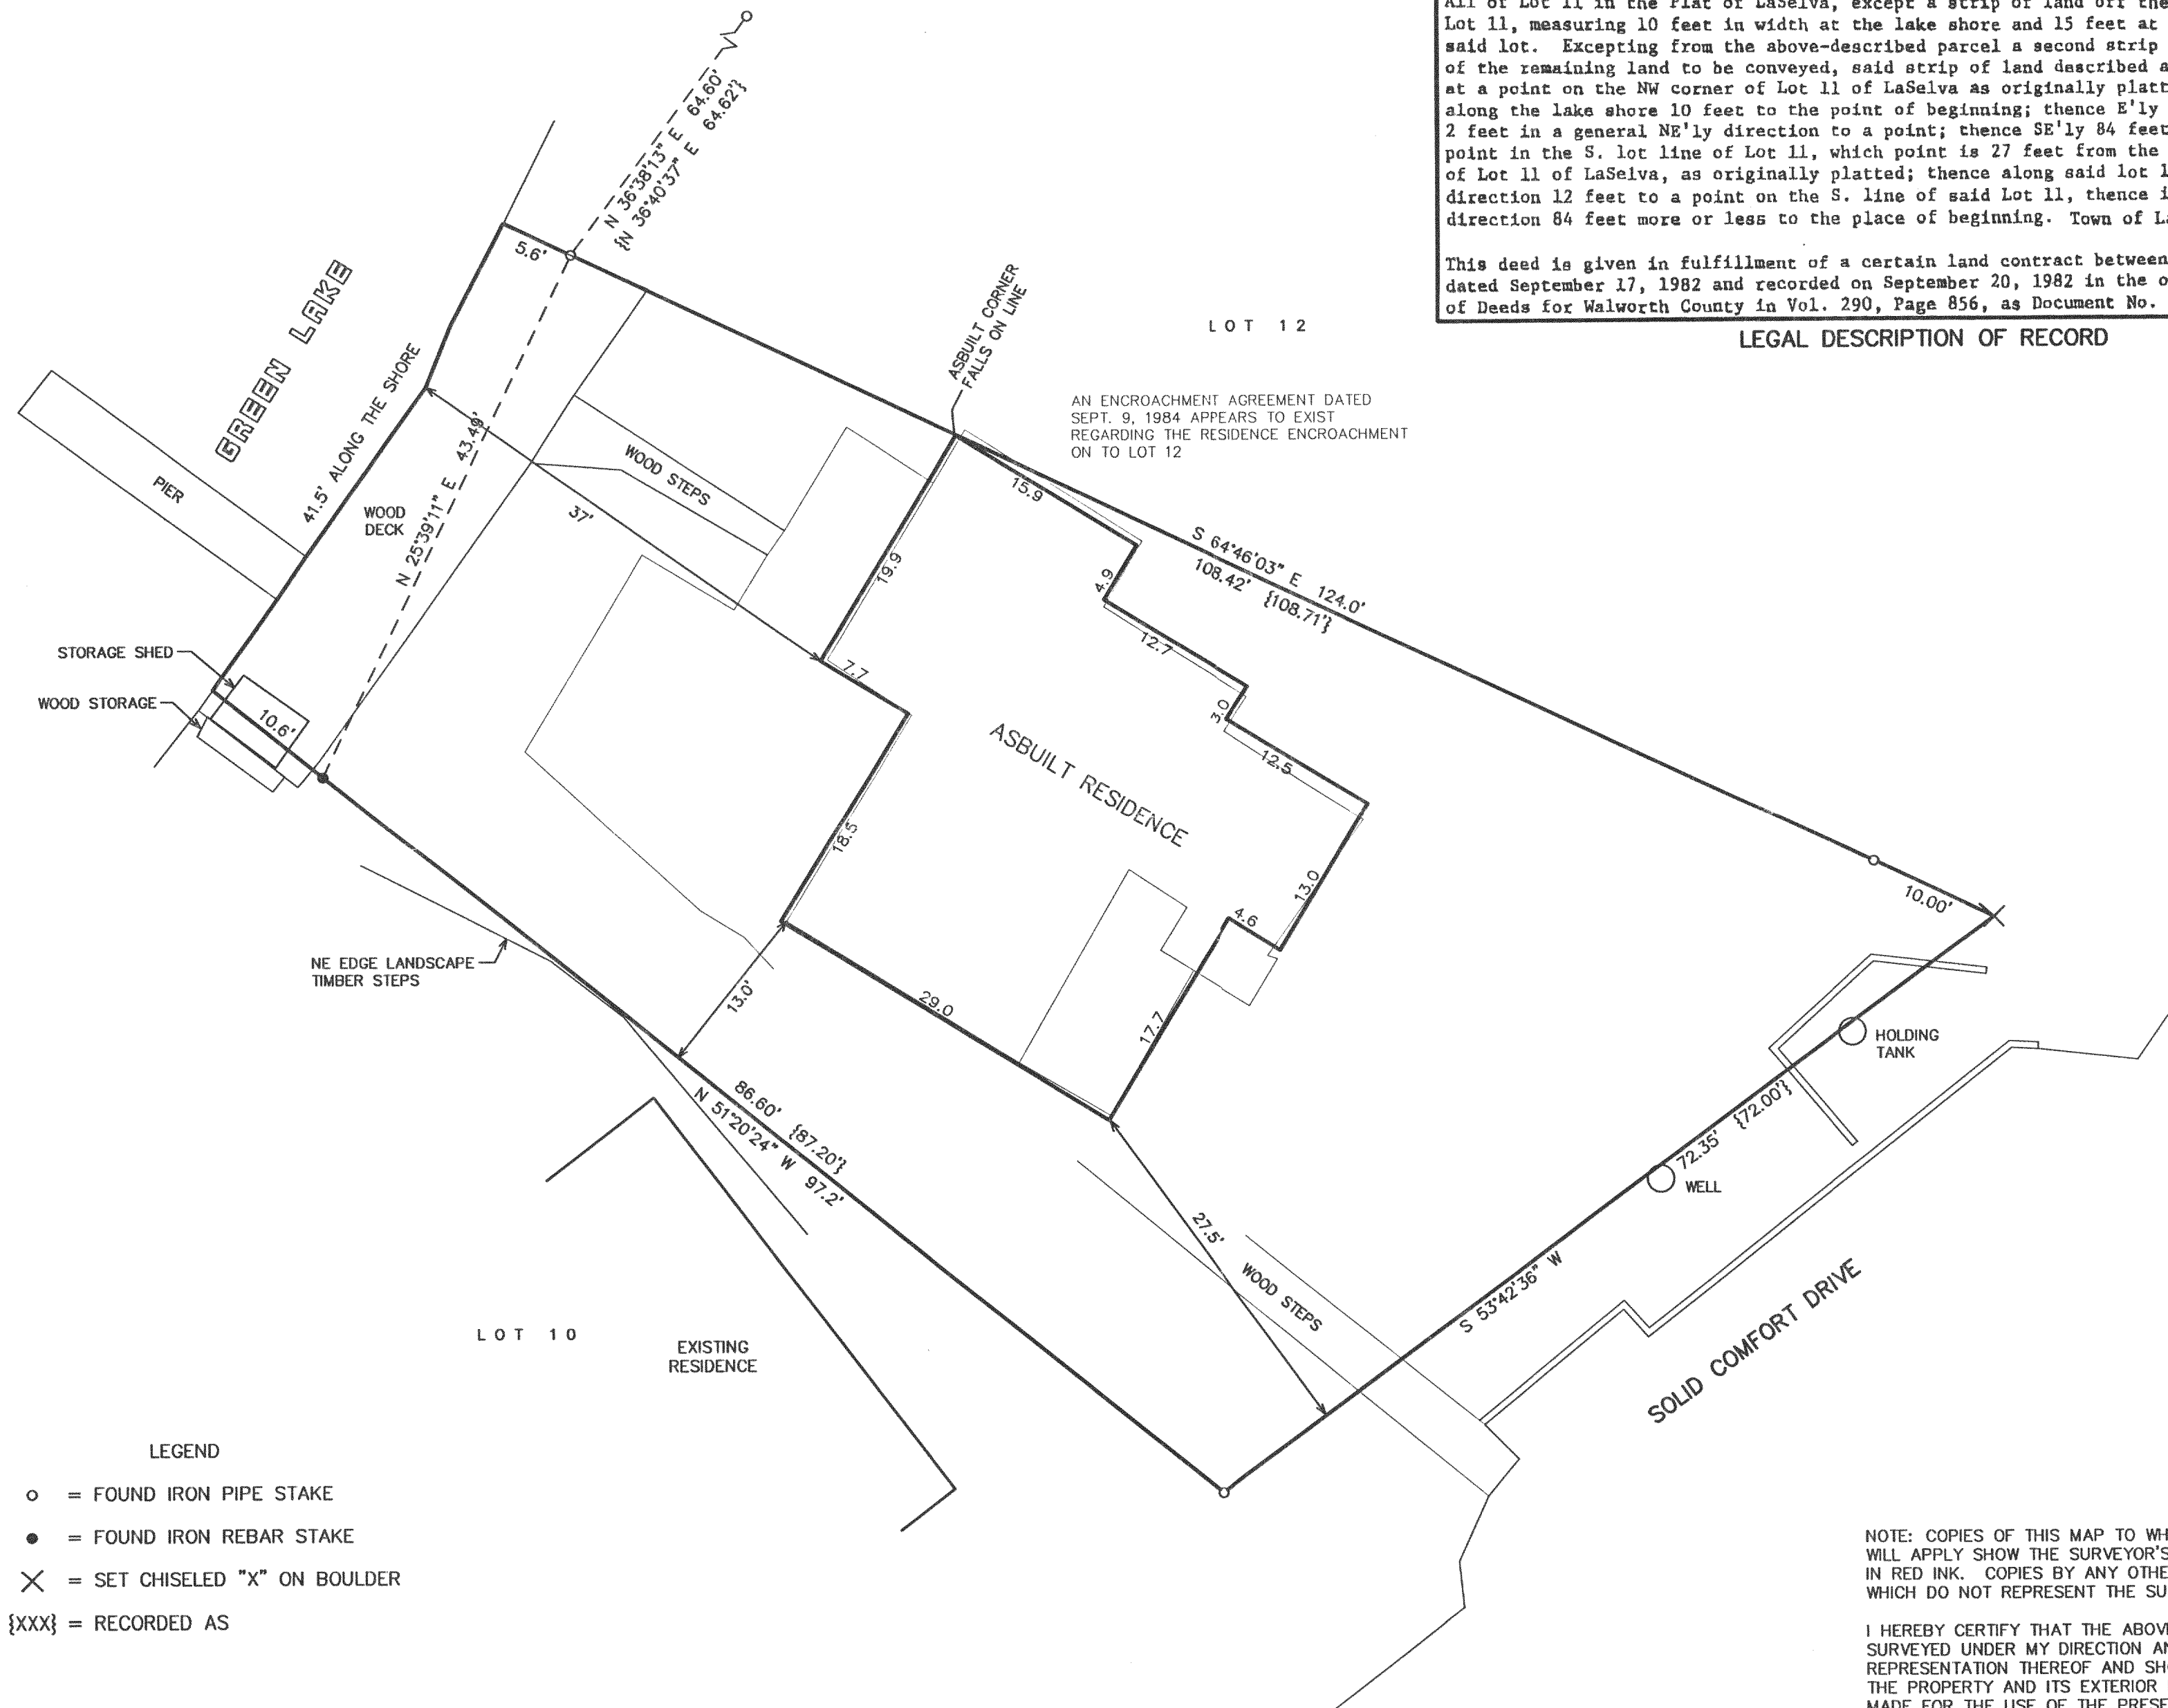

- LEGEND**
- = FOUND IRON PIPE STAKE
 - = FOUND IRON REBAR STAKE
 - ✕ = SET CHISELED "X" ON BOULDER
 - {XXX} = RECORDED AS

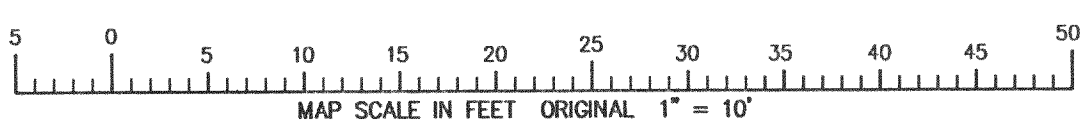

NOTE: COPIES OF THIS MAP TO WHICH THE FOLLOWING CERTIFICATE WILL APPLY SHOW THE SURVEYOR'S ORIGINAL SEAL AND SIGNATURE IN RED INK. COPIES BY ANY OTHER MEANS MAY HAVE ALTERATIONS WHICH DO NOT REPRESENT THE SURVEYOR'S WORK PRODUCT.

I HEREBY CERTIFY THAT THE ABOVE DESCRIBED PROPERTY HAS BEEN SURVEYED UNDER MY DIRECTION AND THAT THE ABOVE MAP IS A TRUE REPRESENTATION THEREOF AND SHOWS THE SIZE AND LOCATION OF THE PROPERTY AND ITS EXTERIOR BOUNDARIES. THIS SURVEY IS MADE FOR THE USE OF THE PRESENT OWNERS OF THE PROPERTY, AND ALSO THOSE WHO PURCHASE, MORTGAGE, OR GUARANTEE THE TITLE THERETO WITHIN ONE YEAR FROM THE DATE HEREOF.

DATED: 10-11-2001 *revised*
2-5-2002
TV 5' actual size
+ location of pond residence

Peter S. Gordon
PETER S. GORDON R.L.S. 2101

HL-9 416-1751