

ROBERS & BOYD, INC.
CONSULTING ENGINEERS & LAND SURVEYORS



PHONE (414) 763-2682

116 E. CHESTNUT ST.

BURLINGTON, WIS. 53105

**PLAT OF SURVEY
 AND
 PROPOSED HOUSE LOCATION**

OF
 LOT 1 OF CERTIFIED SURVEY # 25 OF
 VOLUME # 1 LOCATED IN PART OF THE SE 1/4
 OF SECTION 2, TANKIAC, TOWNSHIP 4 N
 RANGE 14 E NORTH COUNTY, WISCONSIN

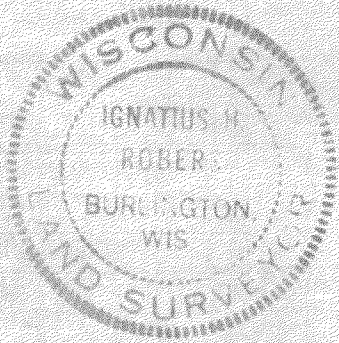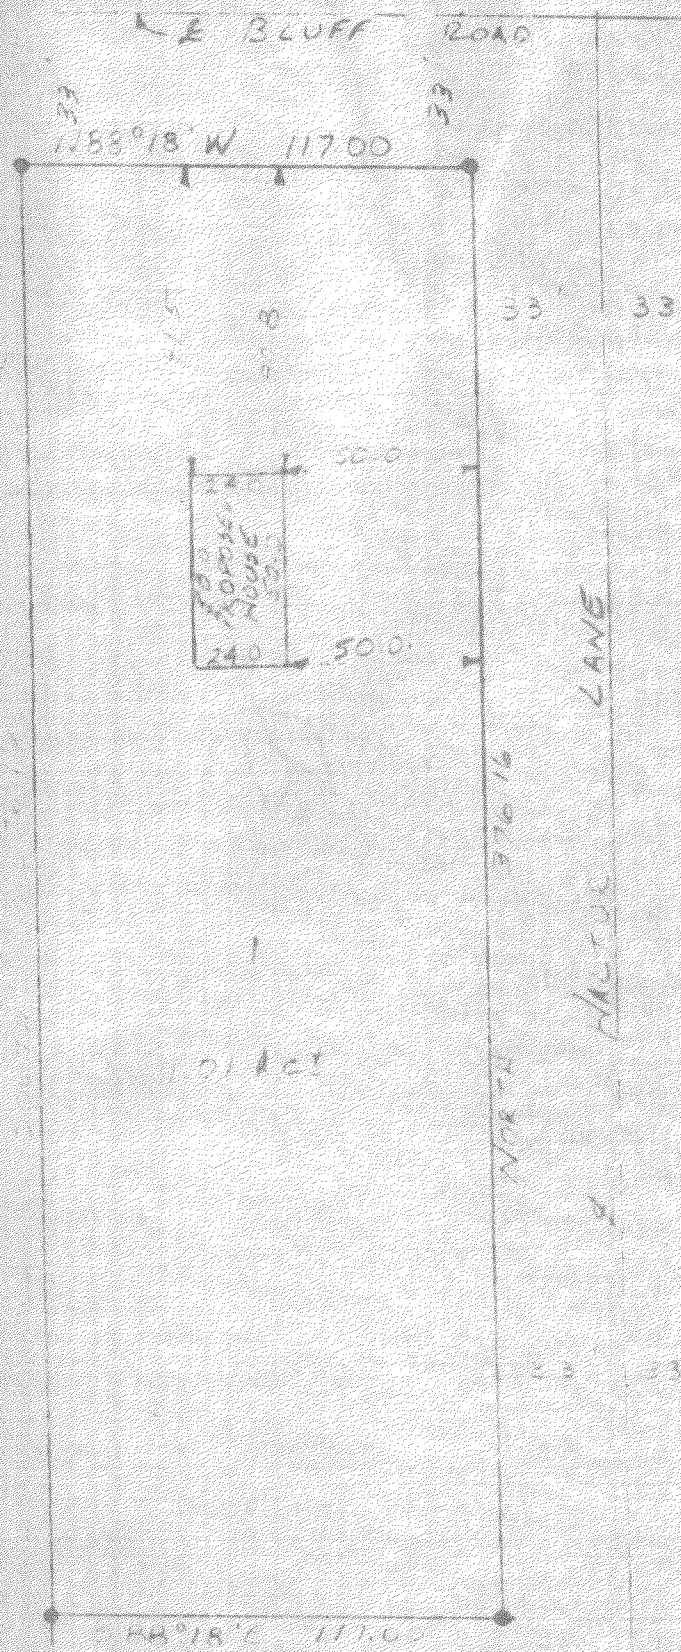

- LEGEND -

- FOUND IRON NAIL

I HEREBY CERTIFY THAT WE HAVE SURVEYED THE LANDS DESCRIBED ABOVE ACCORDING TO OFFICIAL RECORDS AND THAT THE PLAT DRAWN HEREON IS A CORRECT REPRESENTATION OF SAID SURVEY.

Ignatius H. Rober
 WIS. REG. LAND SURVEYOR 5747

DATE 7/18/14

JOB NO. 74209