PREPARED FOR: RENATA RYBICKI W2678 KNIPE RD. ELKHORN WI. 53121

SCALE 1" = 40'


JOB # 01-405A

## PLAT OF SURVEY

J.K. SURVEYING INC. N3705 WILLOWBEND LANE LAKE GENEVA, WI, 53147 262-248-3697

- OF -

LOT 17 MARINER HILLS SUBDIVISION , LOCATED IN THE NW 1/4 OF THE SW 1/4 , AND THE SW 1/4 OF THE SW 1/4 , AND THE SE 1/4 OF THE SW 1/4 , AND THE SE 1/4 , OF SECTION 34, T4N, R16E, TOWN OF LAGRANGE, WALWORTH COUNTY, WISCONSIN.

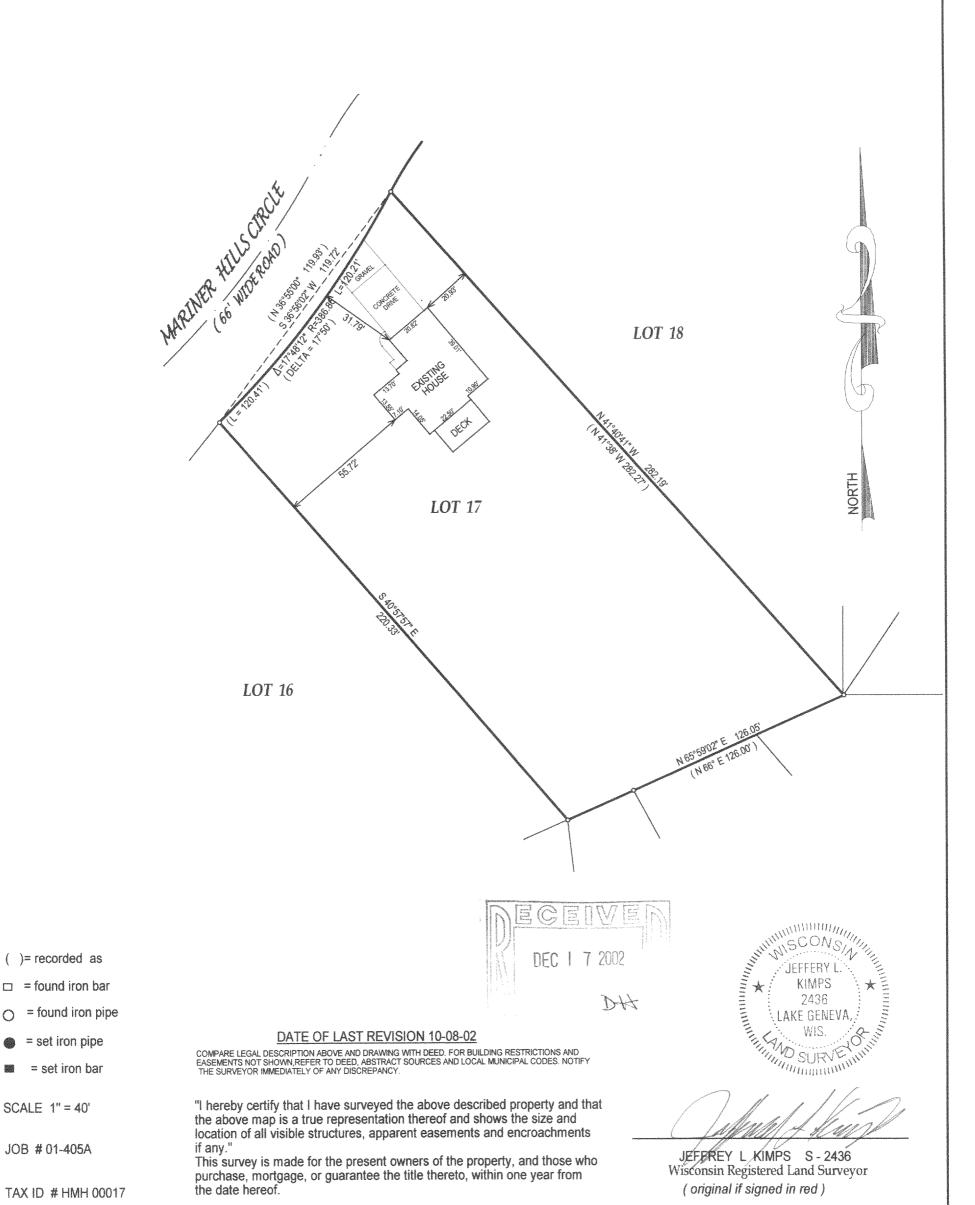

DATED THIS 10 TH, DAY OF SEPTEMBER 2001.