


PLAT OF SURVEY

THE WEST 54 FEET OF LOT 21 OF DROUGHTVILLE PARK
LOCATED IN THE SW 1/4 OF SECTION 25 AND THE NW 1/4 OF SECTION 36
TOWN 4 NORTH, RANGE 16 EAST, WALWORTH COUNTY, WISCONSIN

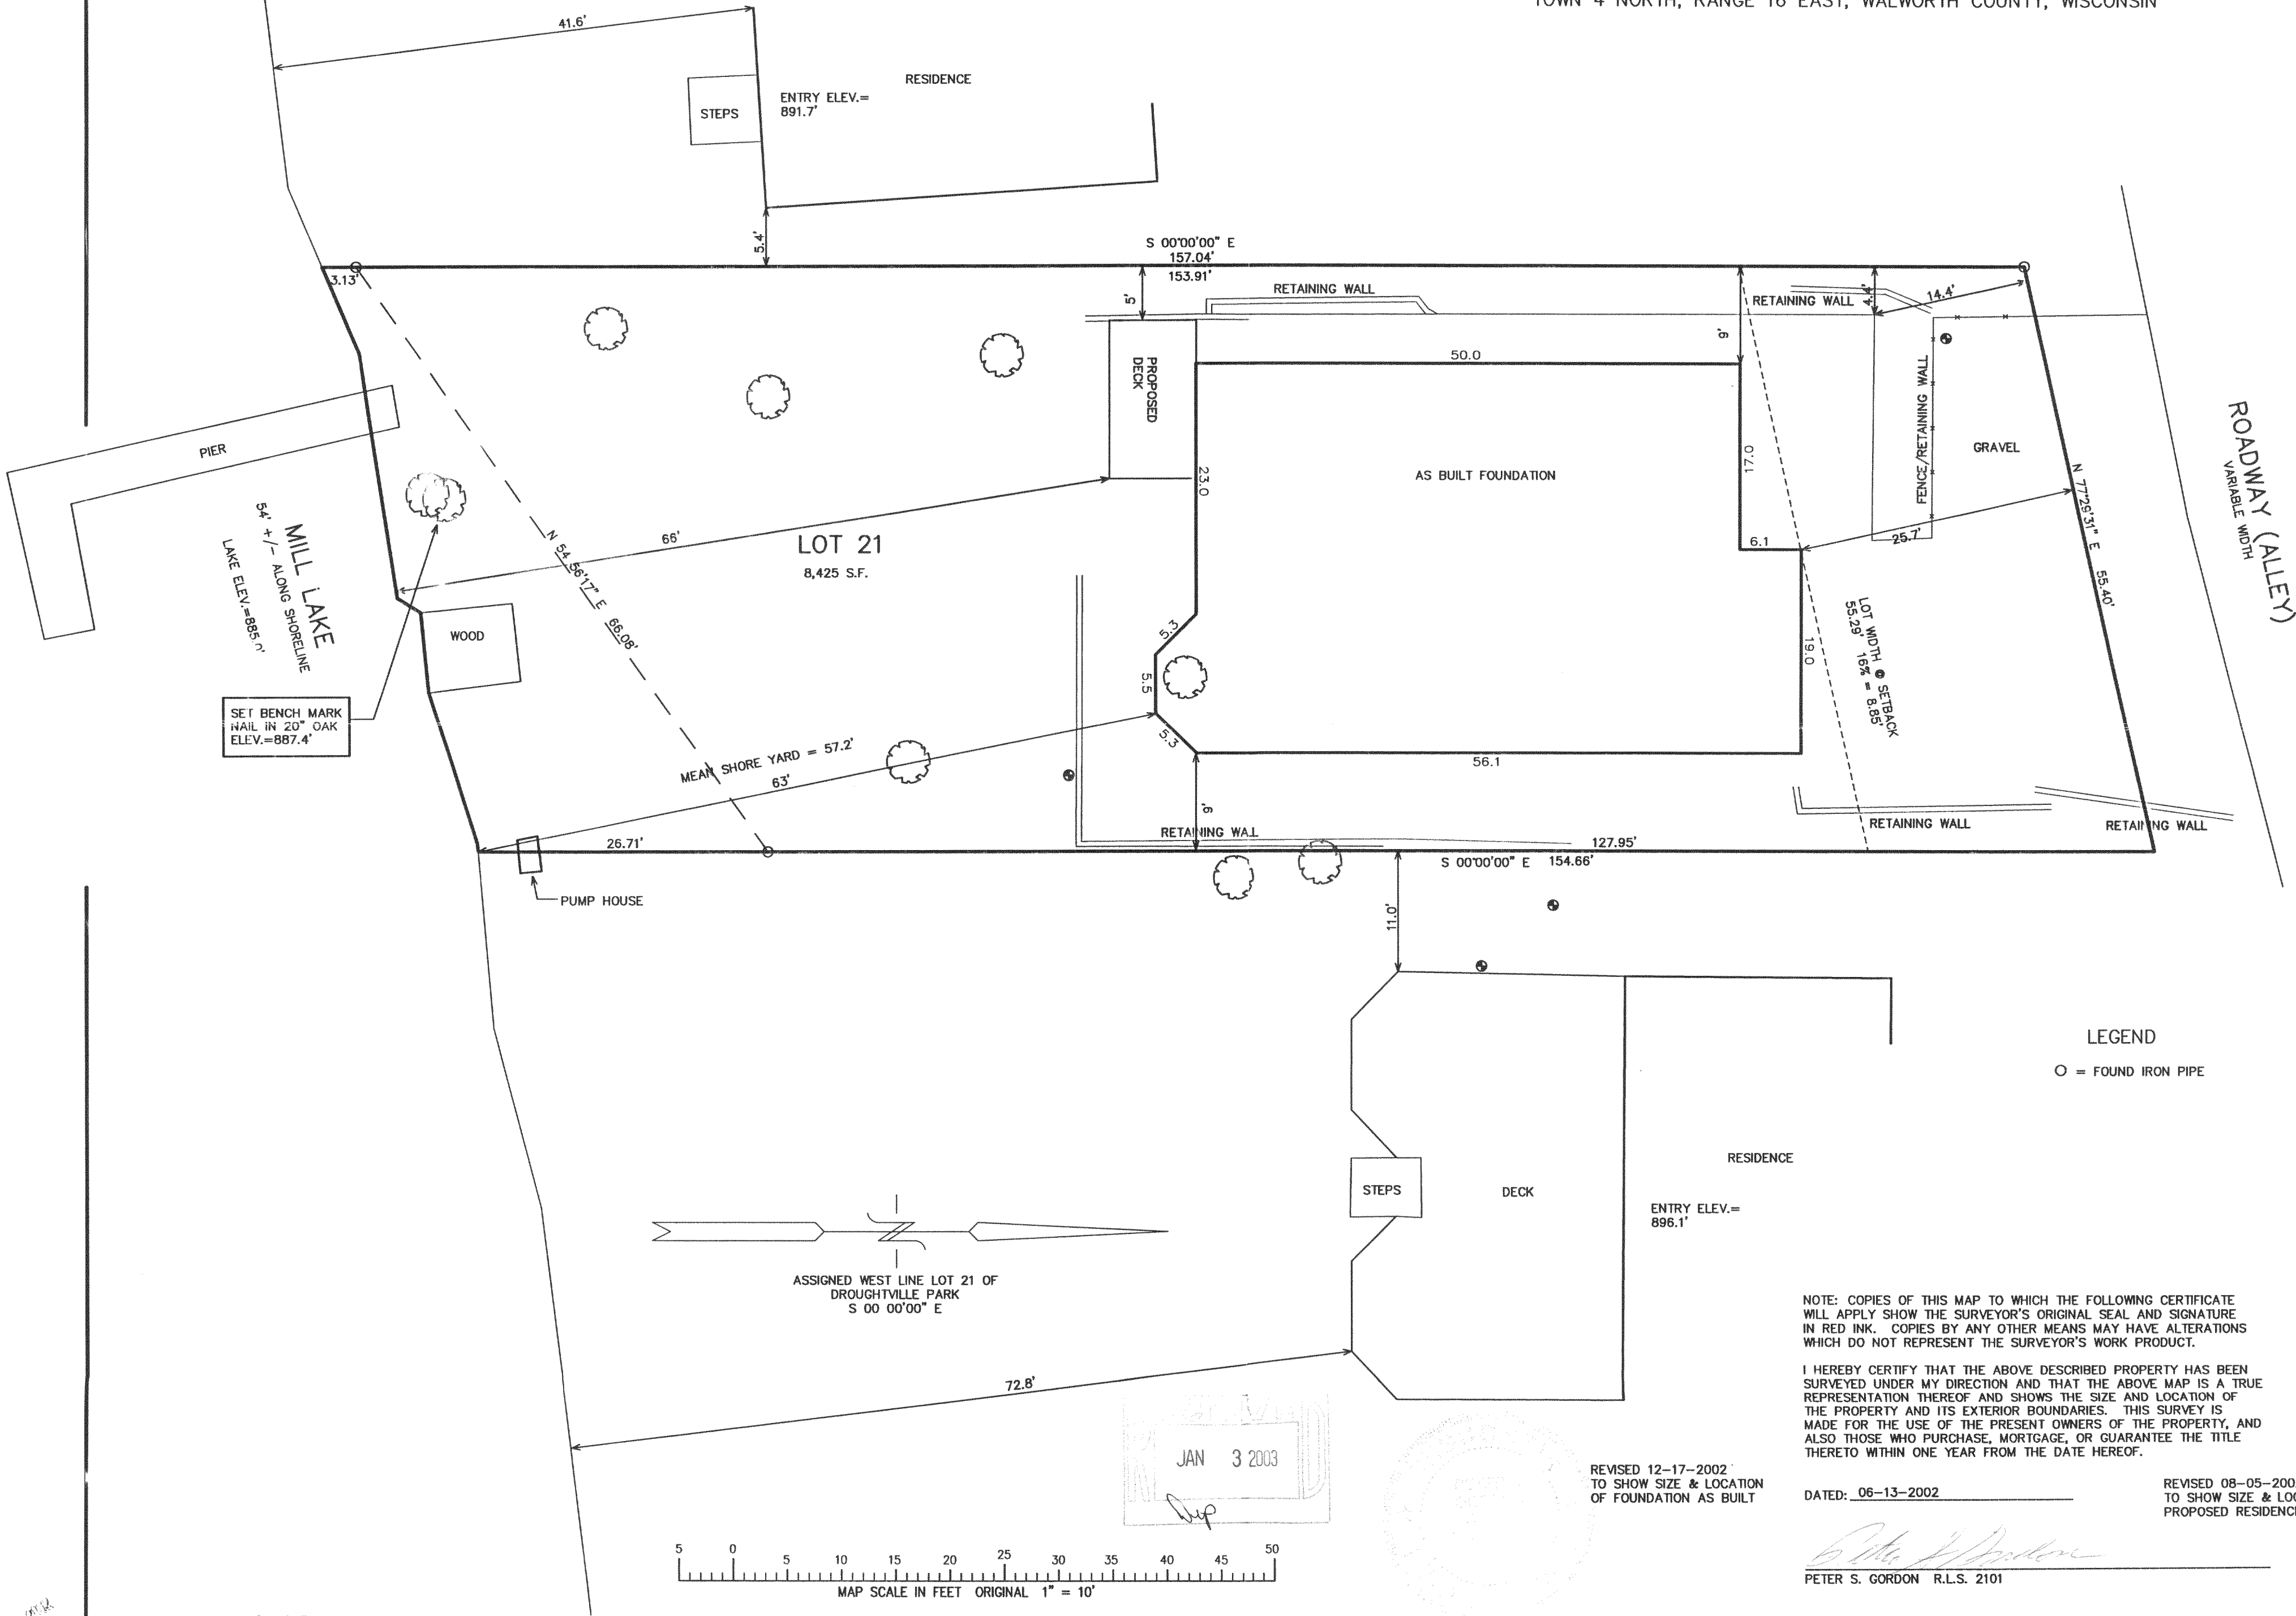

ROADWAY (ALLEY)
VARIABLE WIDTH


WORK ORDERED BY -
CHARLE MADDEN
C/O MADDEN DESIGN
W5989 COUNTY HIGHWAY "ES"
ELKHORN, WI 53121

FARRIS, HANSEN & ASSOCIATES, INC.
ENGINEERING - ARCHITECTURE - SURVEYING
7 RIDGWAY COURT P.O. BOX 437
ELKHORN, WISCONSIN 53121
OFFICE: (262) 723-2098 FAX: (262) 723-5886

LEGEND
O = FOUND IRON PIPE



ASSIGNED WEST LINE LOT 21 OF
DROUGHTVILLE PARK
S 00 00'00" E

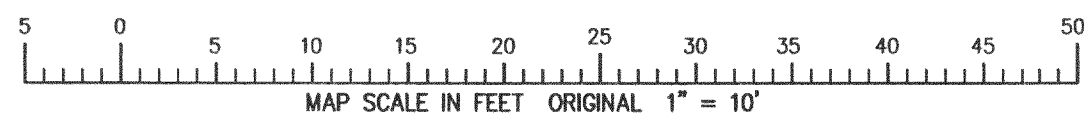

JAN 3 2003
[Signature]



REVISED 12-17-2002
TO SHOW SIZE & LOCATION
OF FOUNDATION AS BUILT

NOTE: COPIES OF THIS MAP TO WHICH THE FOLLOWING CERTIFICATE
WILL APPLY SHOW THE SURVEYOR'S ORIGINAL SEAL AND SIGNATURE
IN RED INK. COPIES BY ANY OTHER MEANS MAY HAVE ALTERATIONS
WHICH DO NOT REPRESENT THE SURVEYOR'S WORK PRODUCT.

I HEREBY CERTIFY THAT THE ABOVE DESCRIBED PROPERTY HAS BEEN
SURVEYED UNDER MY DIRECTION AND THAT THE ABOVE MAP IS A TRUE
REPRESENTATION THEREOF AND SHOWS THE SIZE AND LOCATION OF
THE PROPERTY AND ITS EXTERIOR BOUNDARIES. THIS SURVEY IS
MADE FOR THE USE OF THE PRESENT OWNERS OF THE PROPERTY, AND
ALSO THOSE WHO PURCHASE, MORTGAGE, OR GUARANTEE THE TITLE
THERE TO WITHIN ONE YEAR FROM THE DATE HEREOF.

DATED: 06-13-2002

REVISED 08-05-2002
TO SHOW SIZE & LOCATION OF
PROPOSED RESIDENCE

[Signature]
PETER S. GORDON R.L.S. 2101

REVISIONS

PROJECT NO.
6051
DATE:
06/10/02
SHEET NO.
1 OF 1

416-1850

06/17/02

HD P-23