

# PLAT OF SURVEY -OF-

LOT 4 OF CERTIFIED SURVEY MAP NO. 813,  
RECORDED IN VOLUME 3 OF CERTIFIED SURVEY  
MAPS OF WALWORTH COUNTY ON PAGE 356  
AND LOCATED IN THE NORTHEAST 1/4 OF  
SECTION 35 AND THE NORTHWEST 1/4 OF  
SECTION 36, TOWNSHIP 4 NORTH, RANGE  
16 EAST, TOWN OF LAGRANGE, WALWORTH  
COUNTY, WISCONSIN.

SURVEY FOR: HACKBARTH BUILDERS  
SURVEY LOCATION: W5332 ISLAND WAY

SCALE:  
1" = 30'

- LEGEND
- FOUND 1 3/16" DIA. IRON ROD
  - FOUND 3/4" DIA. IRON ROD
  - ⊕ UTILITY POLE
  - UTILITY BOX
  - 890.0 EXISTING ELEVATION

I HEREBY CERTIFY THAT THE EXISTING  
FOUNDATION AS SHOWN ON THIS PLAT  
OF SURVEY IS LOCATED AS SHOWN  
THUS ( ). DATED THIS 19TH DAY OF  
OCTOBER, 2003.


*Franklin J. Lehman*  
FRANKLIN J. LEHMAN S-2211

20' WIDE ACCESS EASEMENT

NOTE: NO TREES OR VEGETATION  
TO BE REMOVED FOR CONSTRUCTION  
OF PROPOSED BOATHOUSE

B.W. SURVEYING, INC.

LAND SURVEYS  
MAPPING AND PLANNING  
412 N. PINE STREET  
BURLINGTON, WI 53105  
(262)-767-0225

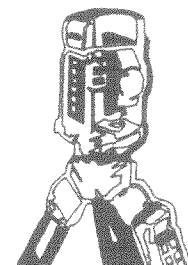

NOV 11 2003


"I hereby certify that I have surveyed the above described  
property and that the above map is a correct representation thereof  
and shows the size and location of the property, its exterior  
boundaries, the location of all visible structures and dimensions  
of all principal buildings thereon, boundary fences, apparent  
easements, roadways and encroachments, if any."

"This survey is made for the use of the present owners of the  
property, and those who purchase, mortgage, or guarantee the  
title thereto within one year from date hereof."

*Franklin J. Lehman*  
FRANKLIN J. LEHMAN S-2211

REV: 11-6-03  
REV: 10-17-03  
AUGUST 7, 2003  
DATE

6002  
JOB NUMBER

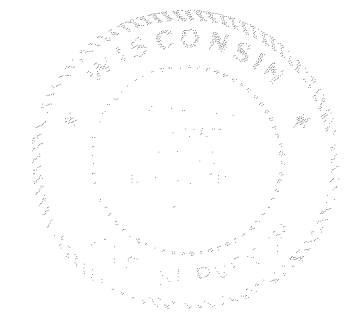

THIS IS NOT AN ORIGINAL PRINT  
UNLESS THIS SEAL IS RED.

HA 813-4

416-1941