


SURVEY & TOPOGRAPHICAL MAPPING  
LOTS 51 AND 52 OF LAUDERDALE HEIGHTS  
LAGRANGE TOWNSHIP  
WALWORTH COUNTY, WISCONSIN

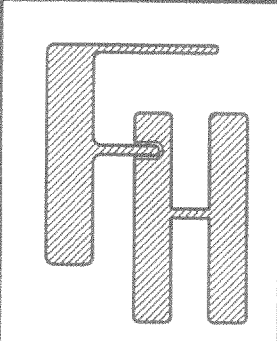


— WORK ORDERED BY —  
JEFF CZAR — CZAR CONSTRUCTION  
W5154 STEWART DRIVE  
ELKHORN, WI 53121

**FARRIS, HANSEN & ASSOCIATES, INC.**  
ENGINEERING — ARCHITECTURE — SURVEYING  
7 RIDGWAY COURT P.O. BOX 437  
ELKHORN, WISCONSIN 53121  
OFFICE: (262) 723-2098 FAX: (262) 723-5886

REVISIONS

PROJECT NO.	6131
DATE	10-05-02
SHEET NO.	1 OF 1

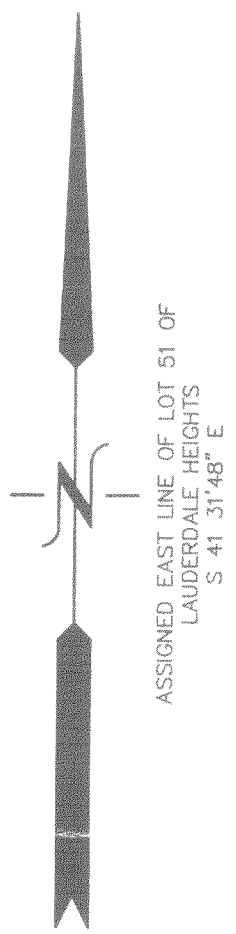


LEGEND  
○ = FOUND IRON PIPE STAKE  
(XXX) = RECORDED AS

NOTE: COPIES OF THIS MAP TO WHICH THE FOLLOWING CERTIFICATE WILL APPLY SHOW THE SURVEYOR'S ORIGINAL SEAL AND SIGNATURE IN RED INK. COPIES BY ANY OTHER MEANS MAY HAVE ALTERATIONS WHICH DO NOT REPRESENT THE SURVEYOR'S WORK PRODUCT.  
I HEREBY CERTIFY THAT THE ABOVE DESCRIBED PROPERTY HAS BEEN SURVEYED UNDER MY DIRECTION AND THAT THE ABOVE MAP IS A TRUE REPRESENTATION THEREOF AND SHOWS THE SIZE AND LOCATION OF THE PROPERTY AND ITS EXTERIOR BOUNDARIES. THIS SURVEY IS MADE FOR THE USE OF THE PRESENT OWNERS OF THE PROPERTY, AND ALSO THOSE WHO PURCHASE, MORTGAGE, OR GUARANTEE THE TITLE THERETO WITHIN ONE YEAR FROM THE DATE HEREOF.

DATED: 10-09-2002

PETER S. GORDON R.L.S. 2101

REVISED 11-05-2002  
01-13-2003 TO SHOW SIZE & LOCATION OF  
FOUNDATION AS BUILT  
REVISED 09-22-2003 TO SHOW AS BUILT DECK

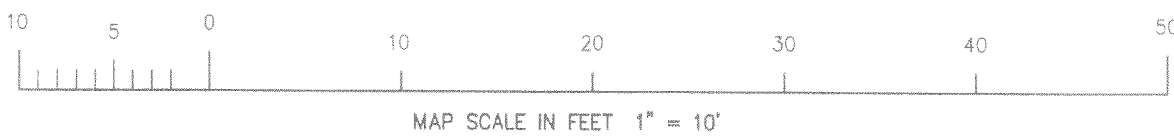

HLH-15

416-1945