
PREPARED FOR:

## PLAT OF SURVEY

J.K. SURVEYING INC. N3705 WILLOWBEND LANE LAKE GENEVA, WI, 53147 262-248-3697

MR. GAMBINO 417 DOUGLAS AV MT. PROSPECT, IL. 60056 -OF-

LOT 20 GLADHURST, A SUBDIVISION LOCATED IN THE SE 1/4 OF SECTION 23, SW 1/4 OF SECTION 24, NW 1/4 OF SECTION 25, AND THE NE 1/4 OF SECTION 26, TOWN 4 NORTH, RANGE 16 EAST, WALWORTH COUNTY, WISCONSIN.

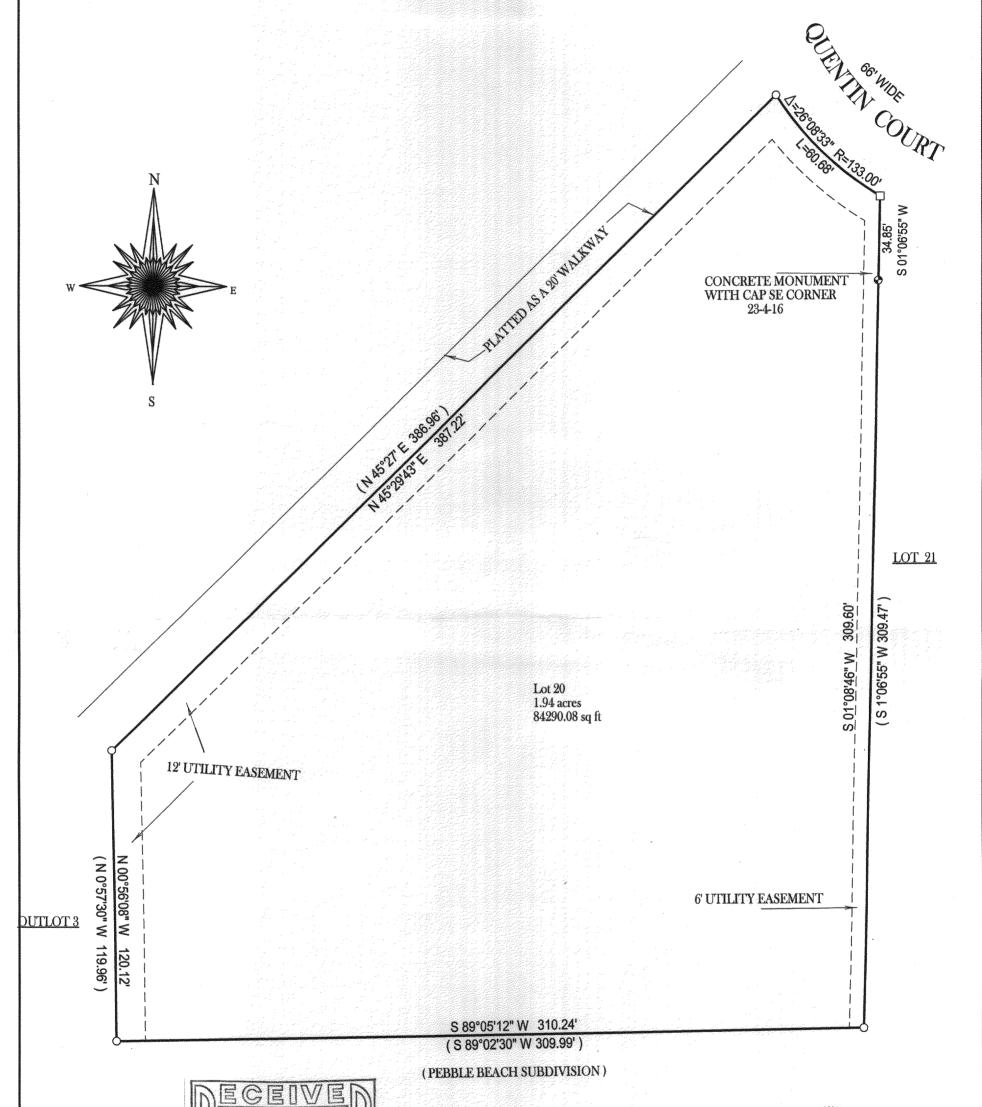

() = RECORDED AS

□ = FOUND IRON BAR

○ = FOUND IRON PIPE

● = SET IRON PIPE

■ = SET IRON BAR

SCALE: 1" =


JOB #:

TAXID#: HG 0020

COMPARE LEGAL DESCRIPTION ABOVE AND DRAWING WITH DEED, FOR BUILDING RESTRICTIONS AND EASEMENTS NOT SHOWN, REFER TO DEED, ABSTRACT SOURCES AND LOCAL MUNICIPAL CODES, NOTIFY THE SURVEYOR IMMEDIATELY OF ANY DISCREPANCY.

AUG 1 3 2004

"I hereby certify that the above described property was surveyed under my supervision and that the above map, to the best of my knowledge and belief, is a true representation thereof and shows the size and location of all visible structures, apparent easements and encroachments if any." This survey is made for the present owners of the property, and those who purchase, mortgage, or guarentee the title thereto, within one year from the date hereof.

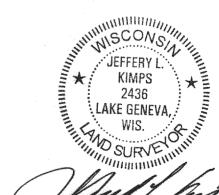

VISCONSIN Registered Land Surveyor (original if signed in red)

DATED THE 15TH, DAY OF April 2004.