

LAND-MARK SURVEYING
Mark L. Miritz

Wisconsin Registered Land Surveyor S-2582

N9330 Knuteson Drive
Whitewater, WI 53190
Phone: (262) 495-3284
FAX: (262) 495-8421
LAND-MARKSURVEYING.COM

LEGAL DESCRIPTION PROVIDED BY CHICAGO TITLE INSURANCE COMPANY,
COMMITMENT NO. 64525

THAT PART OF LOT 70 OF BUBBLING SPRINGS (FIRST ADDITION)
WALWORTH COUNTY, WISCONSIN, DESCRIBED AS FOLLOWS, TO-WIT:
COMMENCING AT THE S.E. CORNER OF LOT 70, RUNNING THENCE
N 48°16'W 36.9 FEET TO AN IRON STAKE; THENCE CONTINUING
IN THE SAME COURSE 79.49 FEET TO AN IRON STAKE; THENCE
N 47°38'E 65.00 FEET TO AN IRON STAKE; THENCE S 69°57'E
81.95 FEET TO AN IRON STAKE; THENCE CONTINUING IN THE
SAME COURSE 42 FEET MORE OR LESS TO THE SHORE OF MIDDLE
LAKE; THENCE IN A SOUTHWESTERLY DIRECTION, ALONG THE SHORELINE
OF SAID MIDDLE LAKE 115 FEET MORE OR LESS TO THE POINT OF
BEGINNING.

PLAT OF SURVEY



PART OF LOT 70, BUBBLING SPRINGS SUBDIVISION
FIRST ADDITION, LOCATED IN SECTION 35, TOWN
4 NORTH, RANGE 16 EAST, TOWN OF LaGRANGE,
WALWORTH COUNTY, WISCONSIN.

PART OF LOT 70
TAX NO. BS1-39A

PART OF LOT 70
TAX NO. BS1-39


OWNERS: DONALD AND JEAN FRITSCHÉ
W5657 RIDGE ROAD
ELKHORN, WI. 53121

RIDGE ROAD
(WIDTH VARIES)

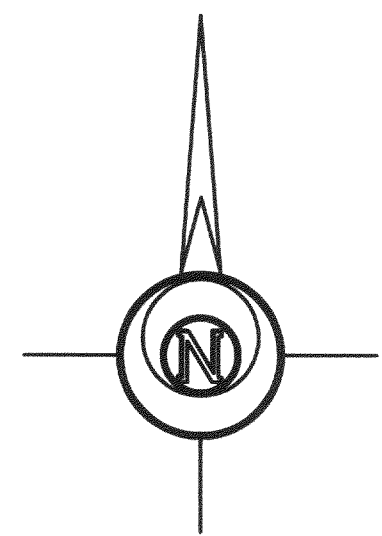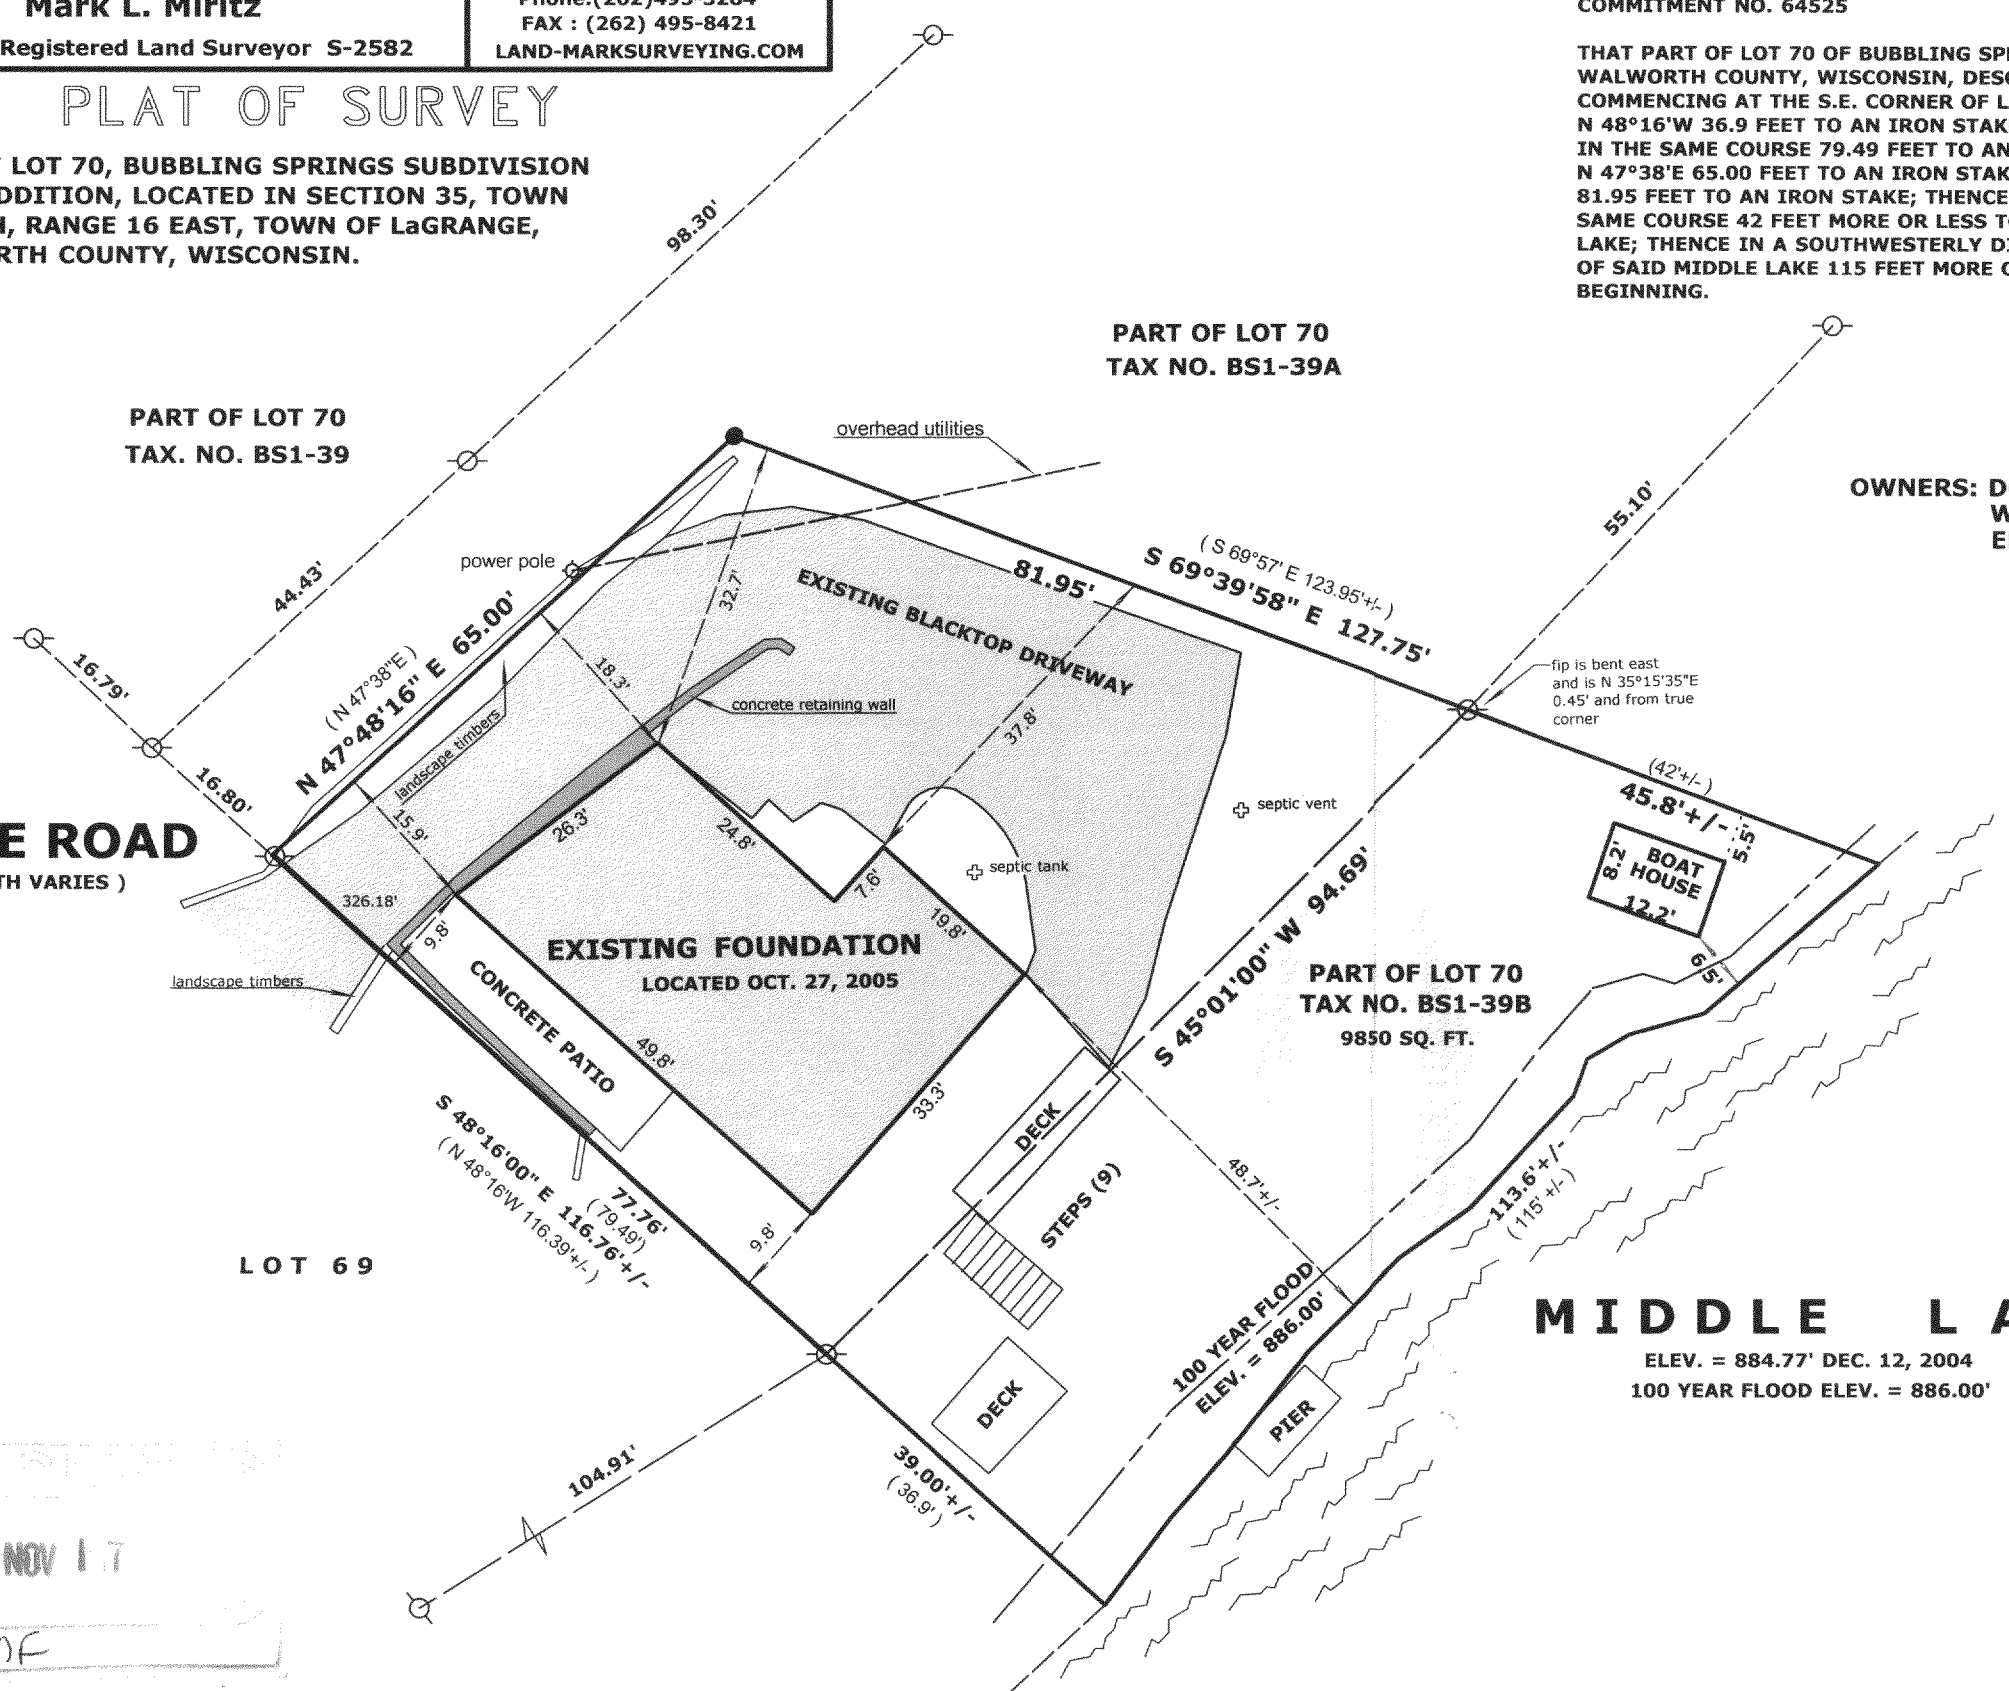

LEGEND

- FOUND IRON PIPE
- FOUND IRON ROD
- FOUND COUNTY MONUMENT
- FOUND CONCRETE MONUMENT
- CHISEL CUT IN CONCRETE
- SET IRON ROD, 24" LONG, WEIGHING 1.5 LBS./LINEAL FT., 3/4" DIA.
- RECORDED AS DIMENSION
- EXISTING FENCE

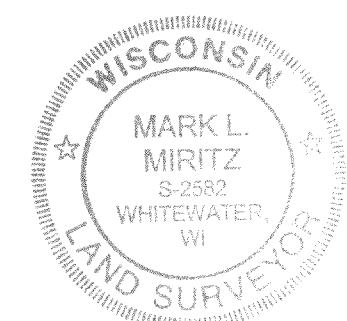

SCALE: 1" = 20 FEET

"I hereby certify that the above described property has been surveyed by me or under my direction and that the above map is a true representation thereof and shows the size and location of the property, its exterior boundaries, the location of all visible structures and dimensions of all principal buildings thereon, boundary fences, apparent easements, roadways and visible encroachments, if any."
"This survey is made for the use of the present owners of the property, and also those who purchase, mortgage, or guarantee the title thereto within one year from date hereof."

Mark L. Miritz
MARK L. MIRITZ
WISCONSIN REGISTERED
LAND SURVEYOR S-2582

REVISED OCT. 28, 2005 DATE: Jan. 7, 2005 JOB NO. 04.1208

NOV 17
SMF

HB 51-39B

416-2150