ENGINEERING - ARCHITECTURE - SURVEYING 7 RIDGWAY COURT - P.O. BOX 437 - ELKHORN, WISCONSIN 53121 PHONE: (262) 723-2098 FAX: (262) 723-5886

PLAT OF SURVEY

LEGAL DESCRIPTION

Lot 7, Block 4, Cool Hill Park, a Subdivision located in the NW 1/4 and the SW 1/4 of Section 35, T4N, R16E, Town of LaGrange, Walworth County, Wisconsin. EXCEPTING THEREFROM all that piece or parcel of land described in Volume 21 of Records on page 359 as Document No.620762.

Tax Key No. HCH 00026

5


- WORK ORDERED BY -KEEFE REAL ESTATE 751 GENEVA PARKWAY LAKE GENEVA, WI.


LEGEND

= FOUND IRON PIPE STAKE

= FOUND IRON REBAR STAKE

(XXX) = RECORDED AS

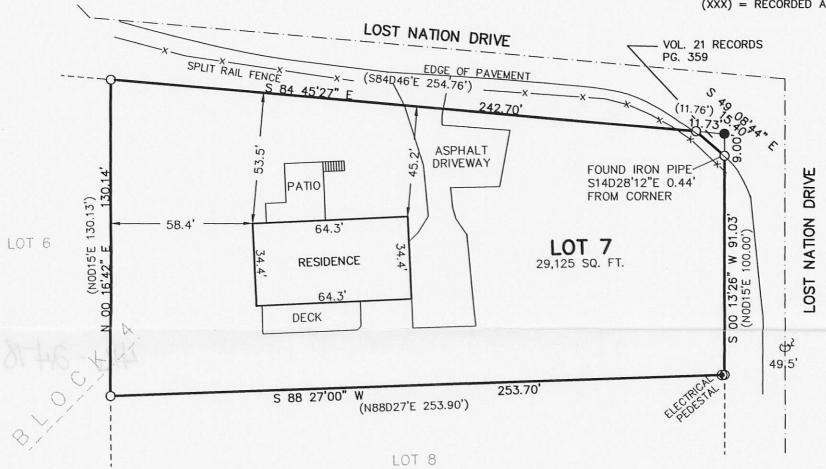

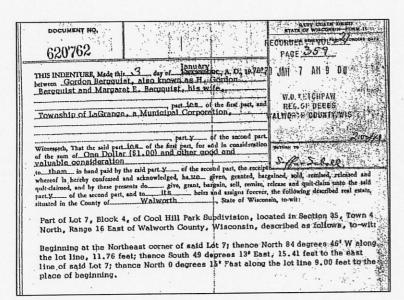

100 50 90 80 70 60 ⁵⁰ 40 30 20 10 MAP SCALE IN FEET ORIGINAL 1" = 40'

416-24

NOTE: COPIES OF THIS MAP TO WHICH THE FOLLOWING CERTIFICATE WILL APPLY SHOW SURVEYOR'S ORIGINAL SEAL AND SIGNATURE IN RED INK. COPIES BY ANY OTHER MEANS MAY HAVE ALTERATIONS WHICH DO NOT REPRESENT THE SURVEYOR'S WORK PRODUCT.

I HEREBY CERTIFY THAT THE ABOVE DESCRIBED PROPERTY HAS BEEN SURVEYED UNDER MY DIRECTION AND THAT THE ABOVE MAP IS A TRUE REPRESENTATION THEREOF AND SHOWS THE SIZE AND LOCATION OF THE PROPERTY, ITS EXTERIOR BOUNDARIES, THE LOCATION OF ALL VISIBLE STRUCTURES, AND DIMENSIONS OF ALL PRINCIPLE BUILDINGS THEREON, BOUNDARY FENCES, APPARENT EASEMENTS, ROADWAYS, AND VISIBLE ENCROACHMENTS, IF ANY. THIS SURVEY IS MADE FOR THE USE OF THE PRESENT OWNERS OF THE PROPERTY, AND ALSO THOSE WHO PURCHASE, MORTGAGE, OR GUARANTEE THE TITLE THERETO WITHIN ONE YEAR FROM THE DATE HEREOF.

DATED: _MAY 19, 2010

PETER S. GORDON R.L.S. 2101



PROJECT: 8150 DATE: 05-19-2010 SHEET 1 OF 1