

ABELL
SURVEYING & MAPPING

1140 SEQUOIA STREET • DELAVAN, WISCONSIN 53115
262-728-6737

BAY DRIVE

NOTE: BEARINGS ARE REFERENCED TO THE RECORDED SUBDIVISION PLAT.





SCALE 1"=30'

LEGEND

- ⊙ - IRON PIPE FOUND
- ⊗ - IRON ROD FOUND
- () - RECORDED AS

PLAT OF SURVEY OF

LOT 12, BUBBLING SPRINGS SUBDIVISION,
LOCATED IN SECTION 34, T4N,R16E,
WALWORTH COUNTY, WISCONSIN.

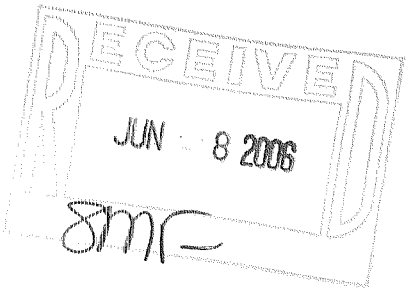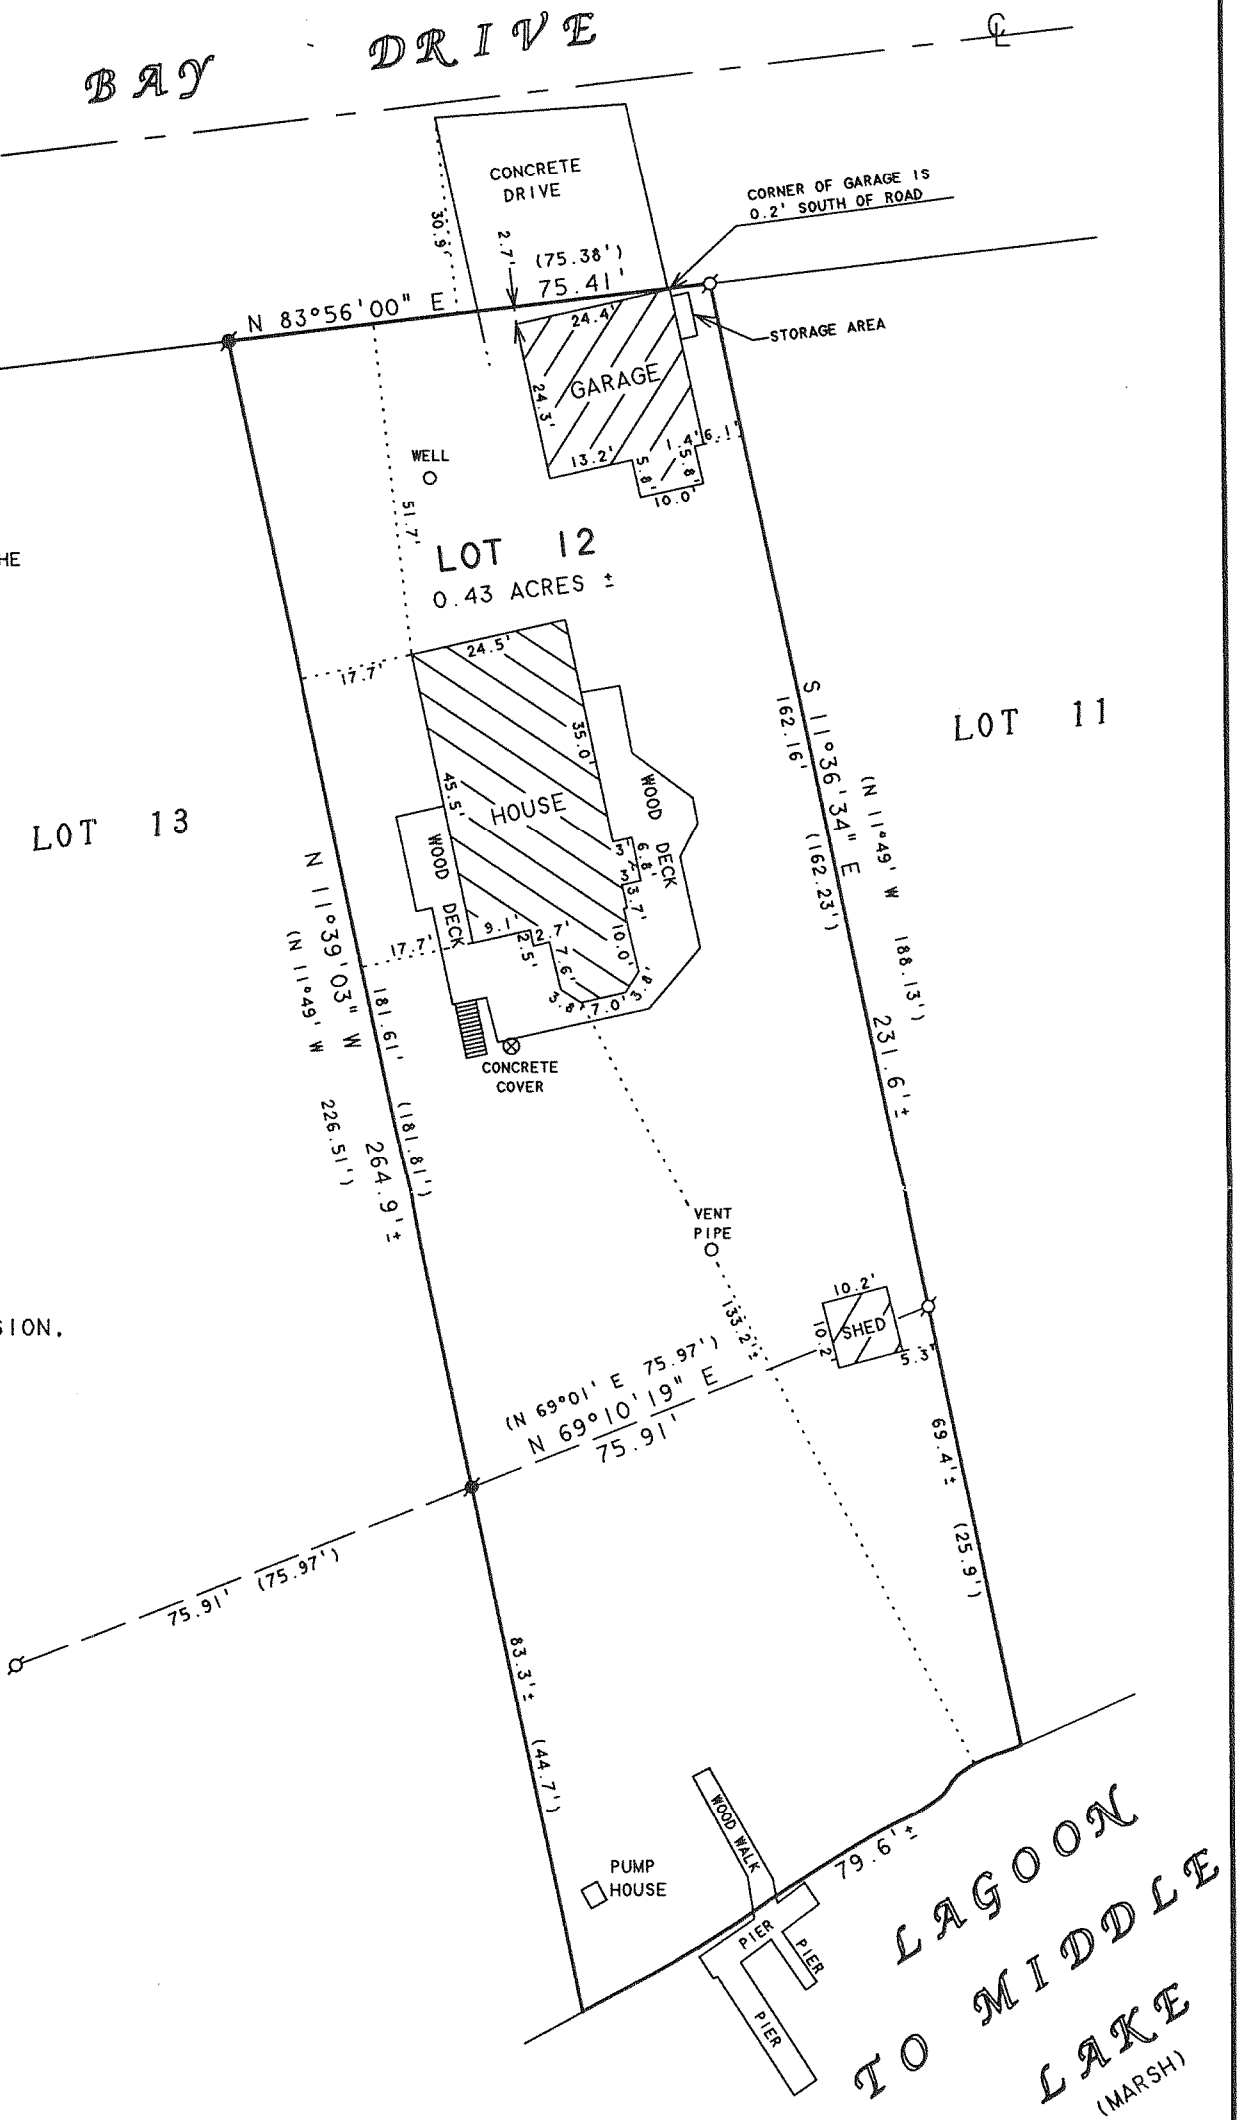

I HEREBY CERTIFY THAT I HAVE SURVEYED THE ABOVE DESCRIBED PROPERTY AND THAT THE ABOVE MAP IS A TRUE REPRESENTATION THEREOF AND SHOWS THE SIZE AND LOCATION OF THE PROPERTY, ITS EXTERIOR BOUNDARIES, THE LOCATION OF ALL VISIBLE STRUCTURES AND DIMENSIONS OF ALL PRINCIPAL BUILDINGS THEREON, BOUNDARY FENCES, APPARENT EASEMENTS, ROADWAYS AND VISIBLE ENCROACHMENTS, IF ANY, TO THE BEST OF MY KNOWLEDGE AND BELIEF.

THIS SURVEY IS MADE FOR THE USE OF THE PRESENT OWNERS OF THE PROPERTY, AND ALSO THOSE WHO PURCHASE, MORTGAGE, OR GUARANTEE THE TITLE THERETO WITHIN ONE (1) YEAR FROM DATE HEREON.

David F. Abell

DAVID F. ABELL
WISCONSIN REGISTERED LAND SURVEYOR, S-1596

ORDERED BY: KEEFE REAL ESTATE
P.O. BOX 460
LAKE GENEVA, WI 53147

April 7, 2006

DATE: _____ JOB NUMBER - 88240A
NOTE: THIS IS NOT A CERTIFIED COPY UNLESS SEALED.

HBS-12

416-2213