
FARRIS, HANSEN & ASSOC. INC.

7 RIDGWAY COURT- P.O. BOX 437 ELKHORN, WSCONSIN 53121 PHONE (262) 723-2098 FAX (262) 723-5886

WORK ORDERED BY: JOHN WARREN 618 NORTH LINCOLN HINSDALE, IL 60521

PLAT OF SURVEY

LOTS 8 AND 8A OF ARROWHEAD PARK LOCATED IN PART OF THE NORTHWEST 1/4 OF THE SOUTHEAST 1/4 OF SECTION 35, TOWN 4 NORTH, RANGE 16 EAST, WALWORTH COUNTY, WISCONSIN

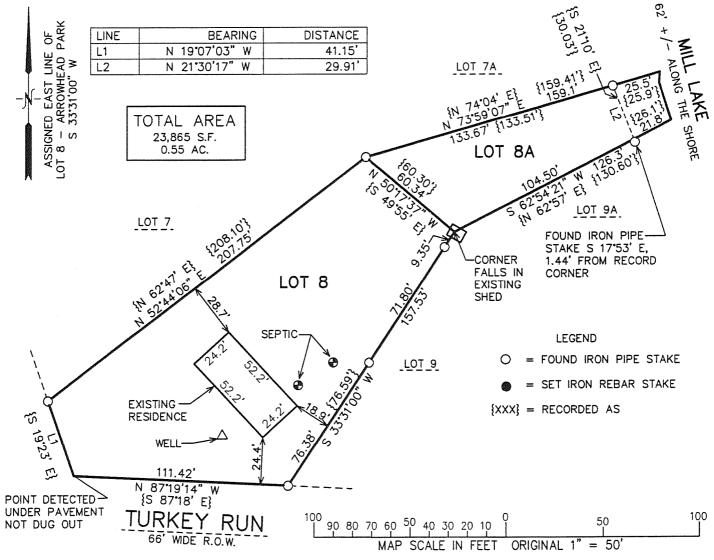

NOTE: COPIES OF THIS MAP TO WHICH THE FOLLOWING CERTIFICATE WILL APPLY SHOW THE SURVEYOR'S ORIGINAL SEAL AND SIGNATURE IN RED INK. COPIES BY ANY OTHER MEANS MAY HAVE ALTERATIONS WHICH DO NOT REPRESENT THE SURVEYOR'S WORK PRODUCT.

I HEREBY CERTIFY THAT THE ABOVE DESCRIBED PROPERTY HAS BEEN SURVEYED UNDER MY DIRECTION AND THAT THE ABOVE MAP IS A TRUE REPRESENTATION THEREOF AND SHOWS THE SIZE AND LOCATION OF THE PROPERTY AND ITS EXTERIOR BOUNDARIES. THIS SURVEY IS MADE FOR THE USE OF THE PRESENT OWNERS OF THE PROPERTY, AND ALSO THOSE WHO PURCHASE, MORTGAGE, OR GUARANTEE THE TITLE THERETO WITHIN ONE YEAR FROM THE DATE HEREOF.

DATED: JANURARY 30, 2007

PETER S. GORDON R.L.S. 2101

FEB 0 6 2007 HAP 1 1

FEB 1 9 2007

THIS INSTRUMENT DRAFTED BY PETER S. GORDON PROJECT NO. 7216 DATED: 01/30/2007 SHEET 1 OF 1 SHEETS

ELKHORN

L. SUFN

416-2261