


1140 SEQUOIA STREET • DELAVAN, WISCONSIN 53115
262-728-6737

RECEIVED
JUL 18 2007
879

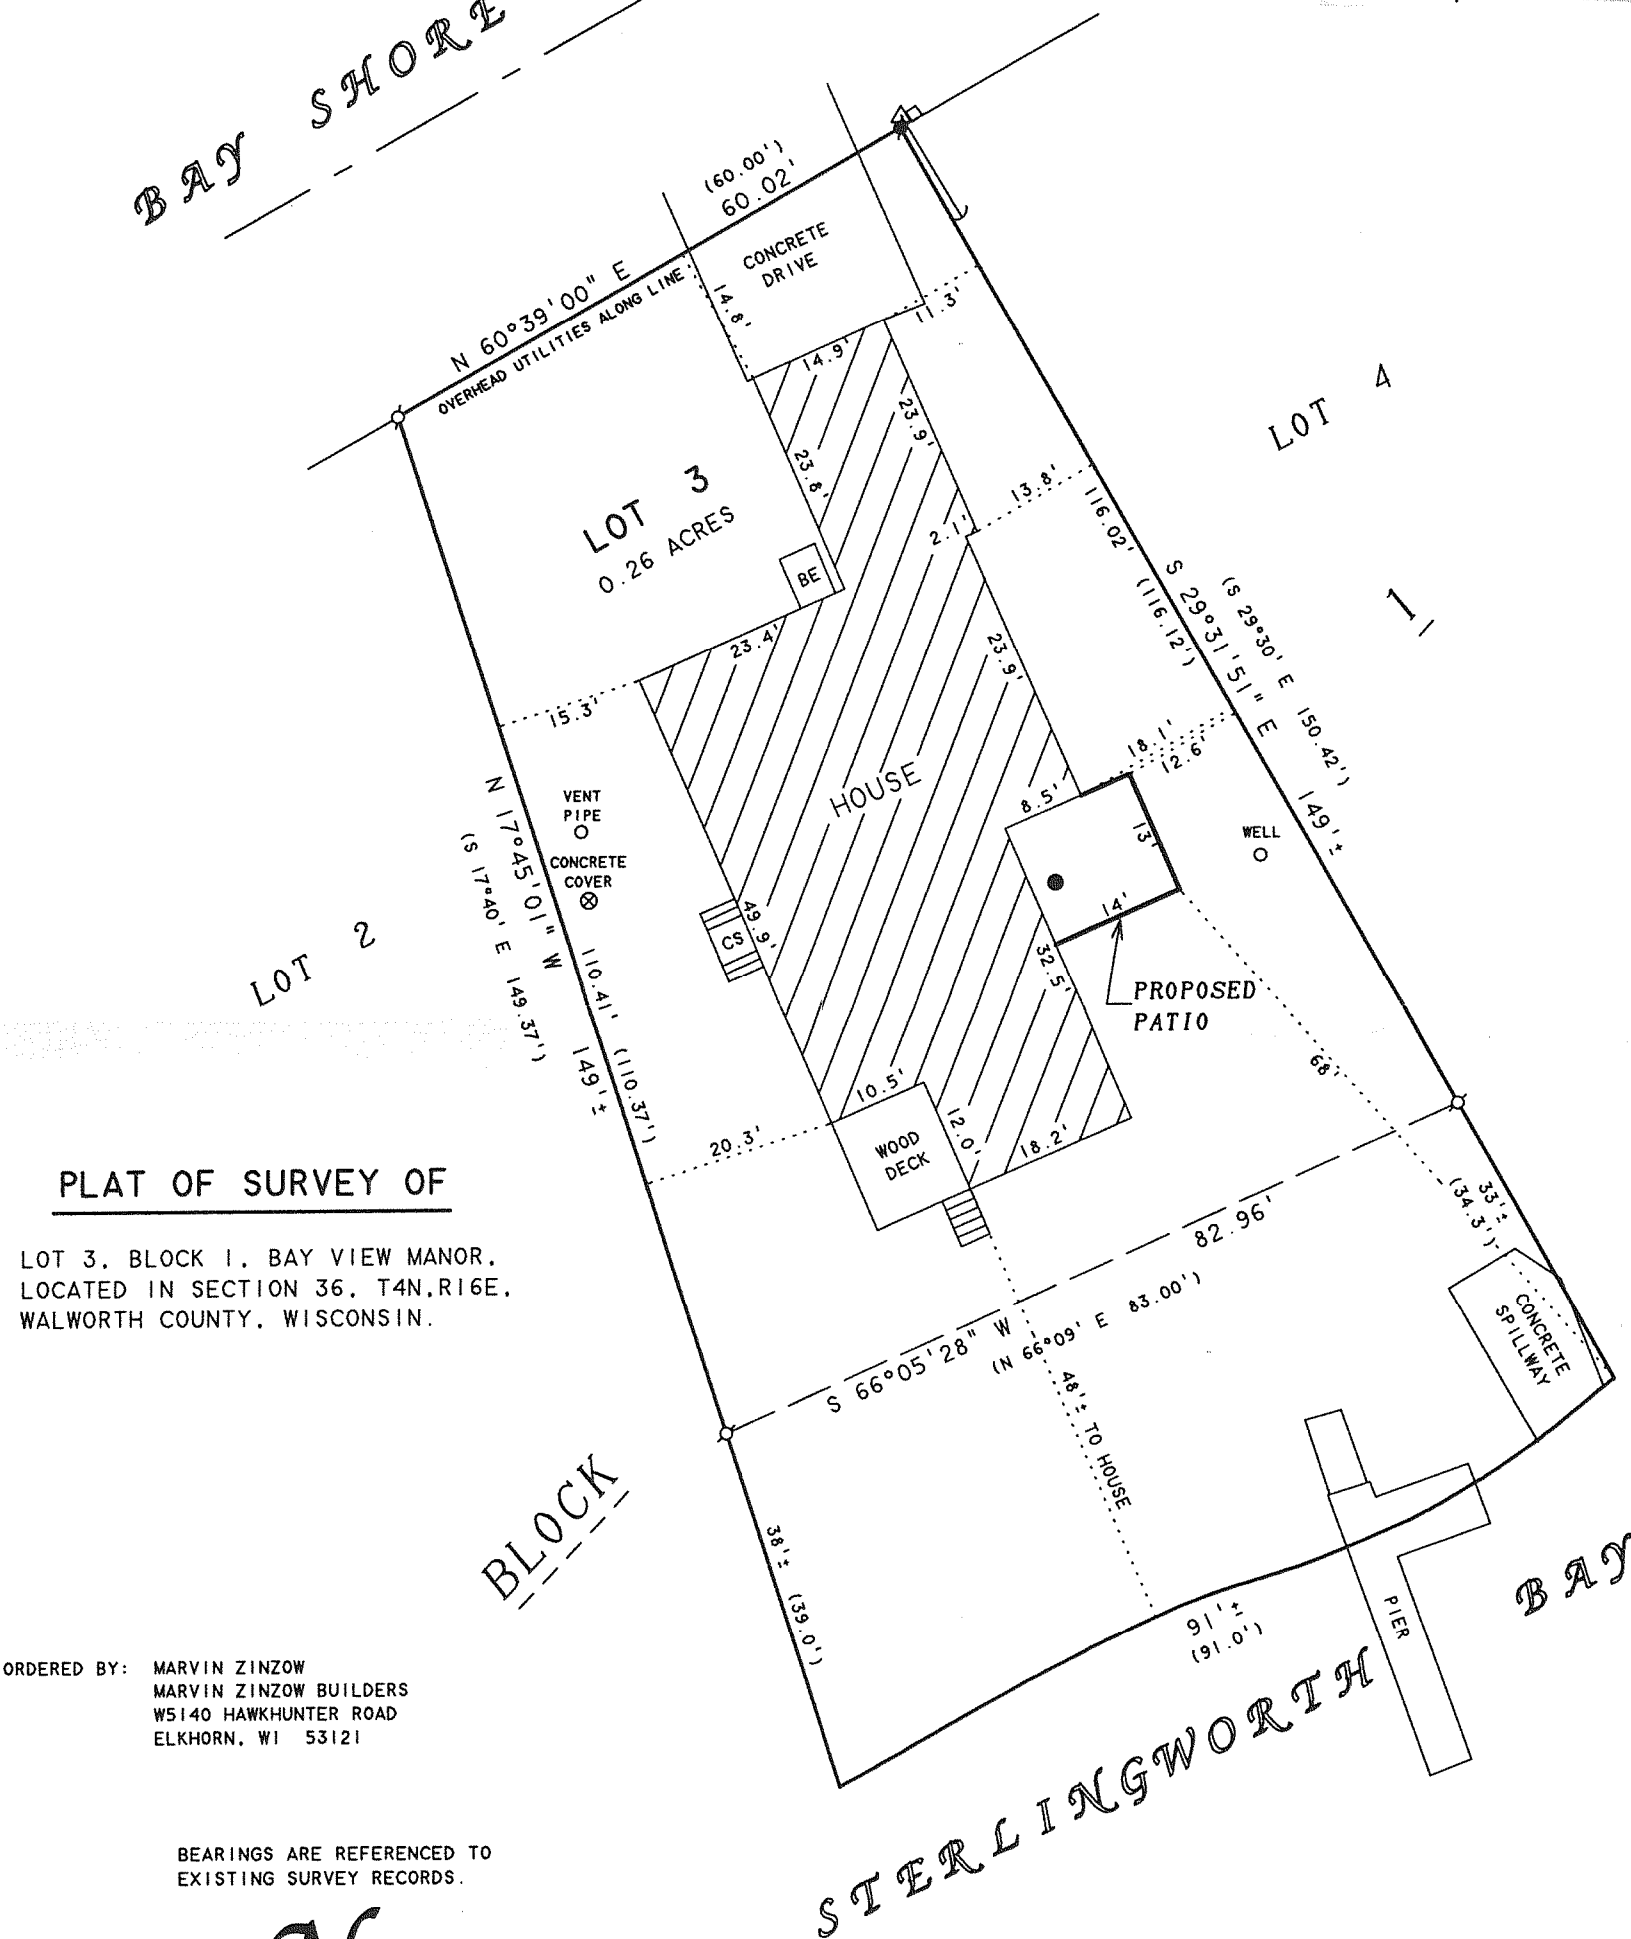

ORDERED BY: MARVIN ZINZOW
MARVIN ZINZOW BUILDERS
W5140 HAWKHUNTER ROAD
ELKHORN, WI 53121

BEARINGS ARE REFERENCED TO
EXISTING SURVEY RECORDS.



SCALE 1" = 20'

LEGEND

- ♂ - IRON PIPE FOUND
 ♂ - IRON ROD FOUND
 △ - UTILITY POLE
 (—) - GUYWIRE
 □ - UTILITY PED
 ● - 3" CAPPED PIPE
 BE - BASEMENT ENTRY
 () - RECORDED AS

I HEREBY CERTIFY THAT I HAVE SURVEYED THE ABOVE DESCRIBED PROPERTY AND THAT THE ABOVE MAP IS A TRUE REPRESENTATION THEREOF AND SHOWS THE SIZE AND LOCATION OF THE PROPERTY, ITS EXTERIOR BOUNDARIES, THE LOCATION OF ALL VISIBLE STRUCTURES AND DIMENSIONS OF ALL PRINCIPAL BUILDINGS THEREON, BOUNDARY FENCES, APPARENT EASEMENTS, ROADWAYS AND VISIBLE ENCROACHMENTS, IF ANY, TO THE BEST OF MY KNOWLEDGE AND BELIEF.

THIS SURVEY IS MADE FOR THE USE OF THE PRESENT OWNERS OF THE PROPERTY, AND ALSO THOSE WHO PURCHASE, MORTGAGE, OR GUARANTEE THE TITLE THERETO WITHIN ONE (1) YEAR FROM DATE HEREON.

DAVID F. ABELL
WISCONSIN REGISTERED LAND SURVEYOR, S-1596

June 29, 2007

DATE _____ JOB NUMBER - 88052A
NOTE: THIS IS NOT A CERTIFIED COPY UNLESS SEALED.

HB-3

416-2277