

Middle  
Lake

# Plat of Survey

of


Lot 2 of Certified Survey Map No. 3783,  
recorded in Vol. 22 of Certified Survey Maps of Walworth County  
on Page 348 and located in the Northeast 1/4 and the Northwest  
1/4 of Section 35, Town 4 North, Range 16 East, Town of LaGrange,  
Walworth County, Wisconsin.

Surveyed for: **Keefe Real Estate, Inc.**  
751 Geneva Parkway  
P.O. Box 460  
Lake Geneva, Wisconsin. 53147

Lot 1  
C.S.M. 848

Lot 2  
0.636 Acre  
27,718 Sq.Ft.

Bearings referenced to C.S.M. 3783, a  
rotation of 1°38'48" to the Wisconsin  
State Plane Coordinate System, South  
Zone.

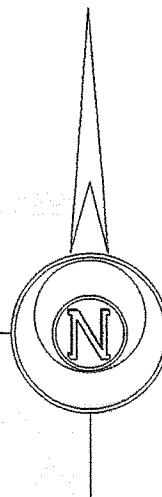

Adjacent house to West:  
-Distance from screen  
porch to shore is 60.5'  
-House corner to shore  
is 67.5'  
Based on field measurements  
taken in 2004. No new field work  
done to verify these dimensions

Lot 1  
C.S.M. 3783


Copyright © 2007 by Jensen & Olson Land Surveying, LLC.

All rights reserved. No part of this survey plat may be reproduced  
or transmitted in any form by any means - graphic, electronic, or  
mechanical, including photocopying, tracing, or information storage  
and retrieval systems - without permission in writing from Douglas  
G. Olson, Jensen & Olson Land Surveying, LLC.


I hereby certify that I have surveyed the above described  
property and the map hereon is correct to the best of my professional  
knowledge and belief and shows the size and location of the property,  
its exterior boundaries, the location and dimensions of all visible  
structures thereon, boundary fences, apparent easements and roadways  
and visible encroachments, if any.

This survey is made for the exclusive use of the present owners  
of property, and also those who purchase, mortgage or guarantee title  
thereto, within one year from the date hereof.

Douglas G. Olson  
Wisconsin Registered Land Surveyor - 2093

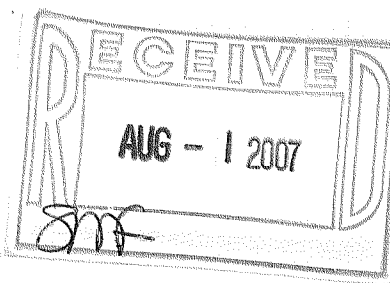

Block 3  
Thansland

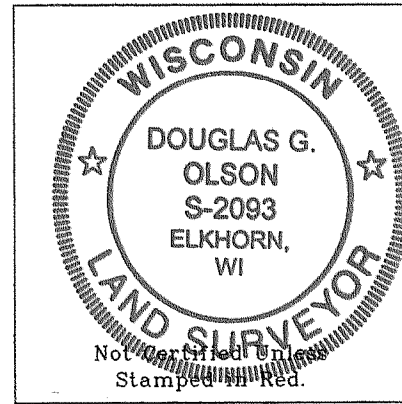

Notes: 1) This survey plat is not  
certified unless signed  
and sealed in red ink.

2) This survey is subject to Wisconsin lien laws.  
This Plat of Survey is the notice of intent  
to file lien. Lien waiver required.

Sheet 1 of 1 Sheets

Job Reference Number

2007.070

## Legend

- Found Iron Pipe
- Found Iron Rod, 3/4" dia.
- Recorded Information
- Concrete Cover
- Utility Box or Pedestal
- Light Pole
- Asphalt Surface
- Concrete Surface
- Stone
- Gravel



**Jensen & Olson Land Surveying, LLC**

45 South Wisconsin Street P.O. Box 322  
Elkhorn, Wisconsin. 53121  
Telephone (262) 723-3434  
Facsimile (262) 723-8044

Scale in Feet

1" = 20'

0' 10' 20' 40'

Survey Date: May 24, 2007.

Revisions: No. 1 - Shore dimensions

HA3783-2

416-2283