

FARRIS, HANSEN & ASSOCIATES, INC.

ENGINEERING - ARCHITECTURE - SURVEYING

7 RIDGWAY COURT - P.O. BOX 437 - ELKHORN, WISCONSIN 53121

PHONE: (262) 723-2098 FAX: (262) 723-5886

PLAT OF SURVEY OF

All of the following described parcels of land located in Block 4 of Green Lake Park Subdivision, Walworth County, Wisconsin:


A parcel of land located in Block 4 of Green Lake Park Subdivision, which subdivision is located in the SE 1/4 of Section 26, T4N, R16E, described as follows, to-wit: Commencing at the angle point in the E'ly line of Lot 12, Block 2 of said subdivision; thence S 74° 04' E 50.50 feet to a point on the E'ly line of said road; thence S 4° 30' W along the road 255.70 feet to the place of beginning; thence S 86° 00' E 158.92 feet to a point; thence S 16° 14' E 25 feet to a point; thence S 75° 45' W 160.50 feet to said road; thence N 14° W along said road 27.50 feet; thence N 10° 30' W along said road 26.88 feet to a point; thence N 4° 30' E along said road 21.53 feet to the place of beginning.

Together with rights in common with the owners of certain parcels described by metes and bounds and commonly referred to as Lots 1 to 9, Block 4, Green Lake Park Subdivision, to use Lot 12, Block 2 of Green Lake Park Subdivision as a means of access to the Lake, for the purpose of maintaining piers, a beach and the like.

Also, together with rights in common with the owners of said parcels to use the following parcel, to-wit: (Parcel referred to as Forest Preserve or Lot 13, Block 4). A parcel of land located in Block 4 of Green Lake Park Subdivision, which subdivision is located in the SW 1/4 of Section 26, T4N, R16E, described as follows, to-wit: Commencing at the S 1/4 Section corner of said Section 26, thence N 6° 32' E along the N-S 1/4 Section line of said Section 26, 443.88 feet to the place of beginning; thence continuing N 6° 32' E along the N-S 1/4 Section line 620.97 feet to a point on said line which is S 6° 32' W 170.00 feet from the NE corner of Block 4 of Green Lake Park Subdivision; thence N 82° 28' W 290 feet; thence S 6° 32' W 40 feet; thence N 83° 28' W 217.50 feet; thence S 26° 19' W 33.72 feet; thence S 4° 30' W 145 feet; thence S 16° 14' E 50 feet; thence S 58° 23' E 30 feet; thence S 89° 46' E 40 feet; thence S 3° 54' E 80 feet to the NE'ly line of a public road; thence along said Public Road as follows: S 72° 38' E 55.08 feet; S 64° 00' E 58.10 feet; S 22° 33' E 108.00 feet; thence S 2° 11' W 151.40 feet to the last point on said road; thence S 84° 32' E 241.20 feet to the place of beginning; for the purposes of recreation and the like, it being understood that the same shall continue as a part of the Forest Preserve.

Tax Key No: HGP 00036

LEGAL DESCRIPTION OF RECORD FROM TITLE COMMITMENT PROVIDED BY CLIENT

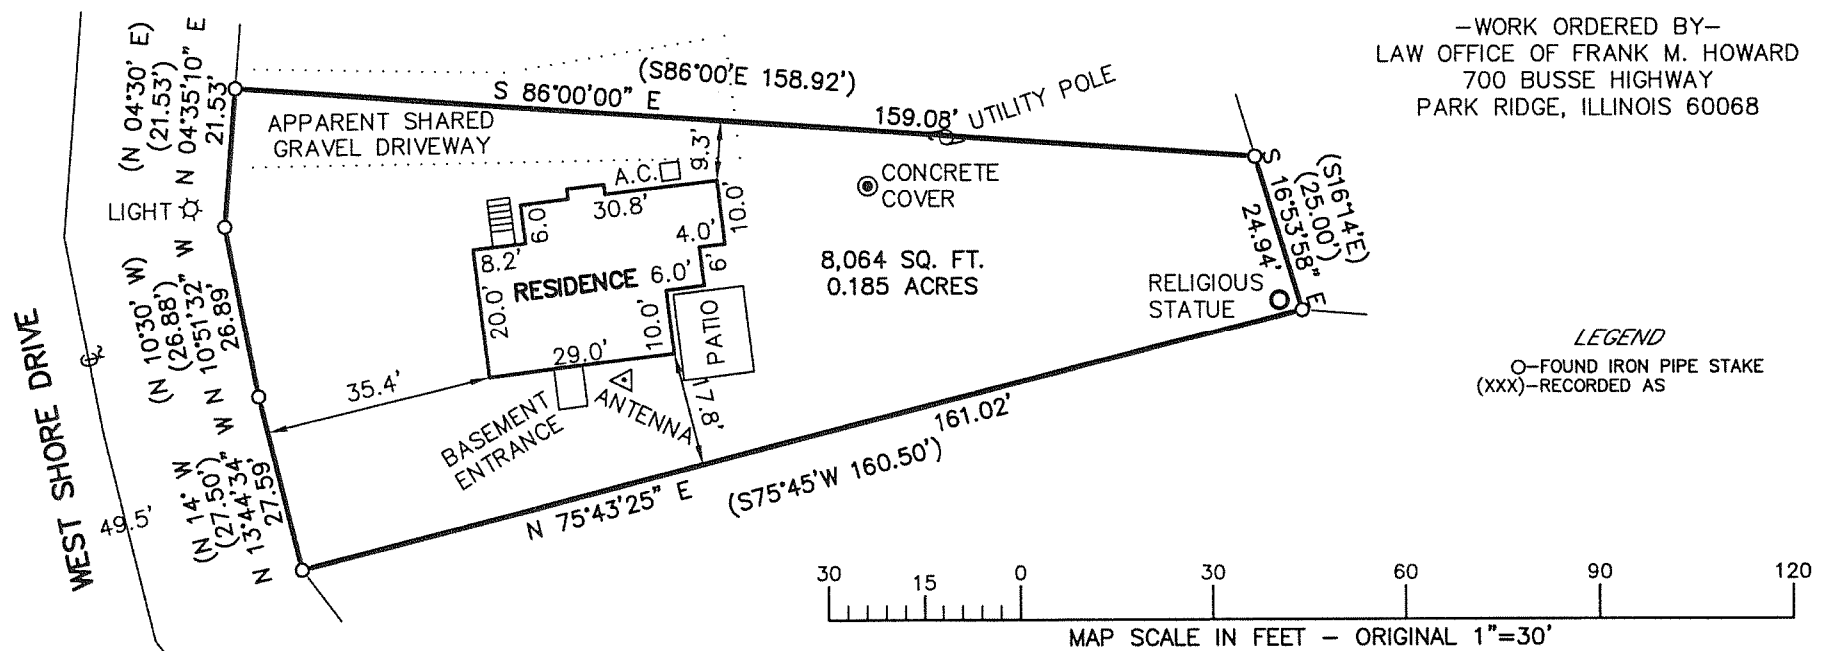



-WORK ORDERED BY-
LAW OFFICE OF FRANK M. HOWARD
700 BUSSE HIGHWAY
PARK RIDGE, ILLINOIS 60068

NOTE: COPIES OF THIS MAP TO WHICH THE FOLLOWING CERTIFICATE WILL APPLY SHOW THE SURVEYOR'S ORIGINAL SEAL AND SIGNATURE IN RED INK. COPIES BY ANY OTHER MEANS MAY HAVE ALTERATIONS WHICH DO NOT REPRESENT THE SURVEYOR'S WORK PRODUCT. I HEREBY CERTIFY THAT THE ABOVE DESCRIBED PROPERTY HAS BEEN SURVEYED UNDER MY DIRECTION AND THAT THE ABOVE MAP IS A TRUE REPRESENTATION THEREOF AND SHOWS THE SIZE AND LOCATION OF THE PROPERTY, ITS EXTERIOR BOUNDARIES, THE LOCATION OF ALL VISIBLE STRUCTURES, AND DIMENSIONS OF ALL PRINCIPLE BUILDINGS THEREON, BOUNDARY FENCES, APPARENT EASEMENTS, ROADWAYS, AND VISIBLE ENCROACHMENTS, IF ANY. THIS SURVEY IS MADE FOR THE USE OF THE PRESENT OWNERS OF THE PROPERTY, AND ALSO THOSE WHO PURCHASE, MORTGAGE, OR GUARANTEE THE TITLE THERETO WITHIN ONE YEAR FROM THE DATE HEREOF.

DATED: 9/25/2007

PETER S. GORDON

PROJECT: 7438
DATE: 09/25/2007
SHEET 1 OF 1

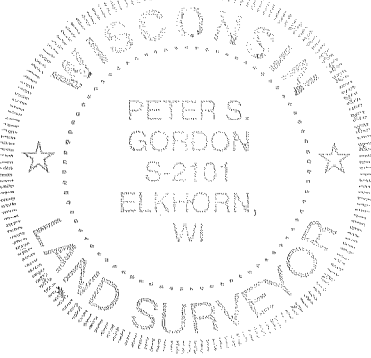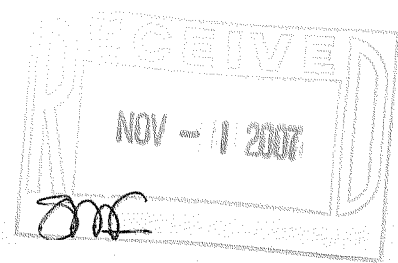

ASSIGNED THE NORTH LINE OF THIS PARCEL S 86°00'00" E

SEP 25 2007 HGP-36

416-2308