

ABELL
SURVEYING & MAPPING

1140 SEQUOIA STREET • DELAVAN, WISCONSIN 53115
262-728-6737

NOTE: BEARINGS ARE REFERENCED TO THE
RECORDED SUBDIVISION PLAT.


N



SCALE 1"=20'

LEGEND


- - IRON PIPE FOUND
- - IRON ROD FOUND
- () - RECORDED AS

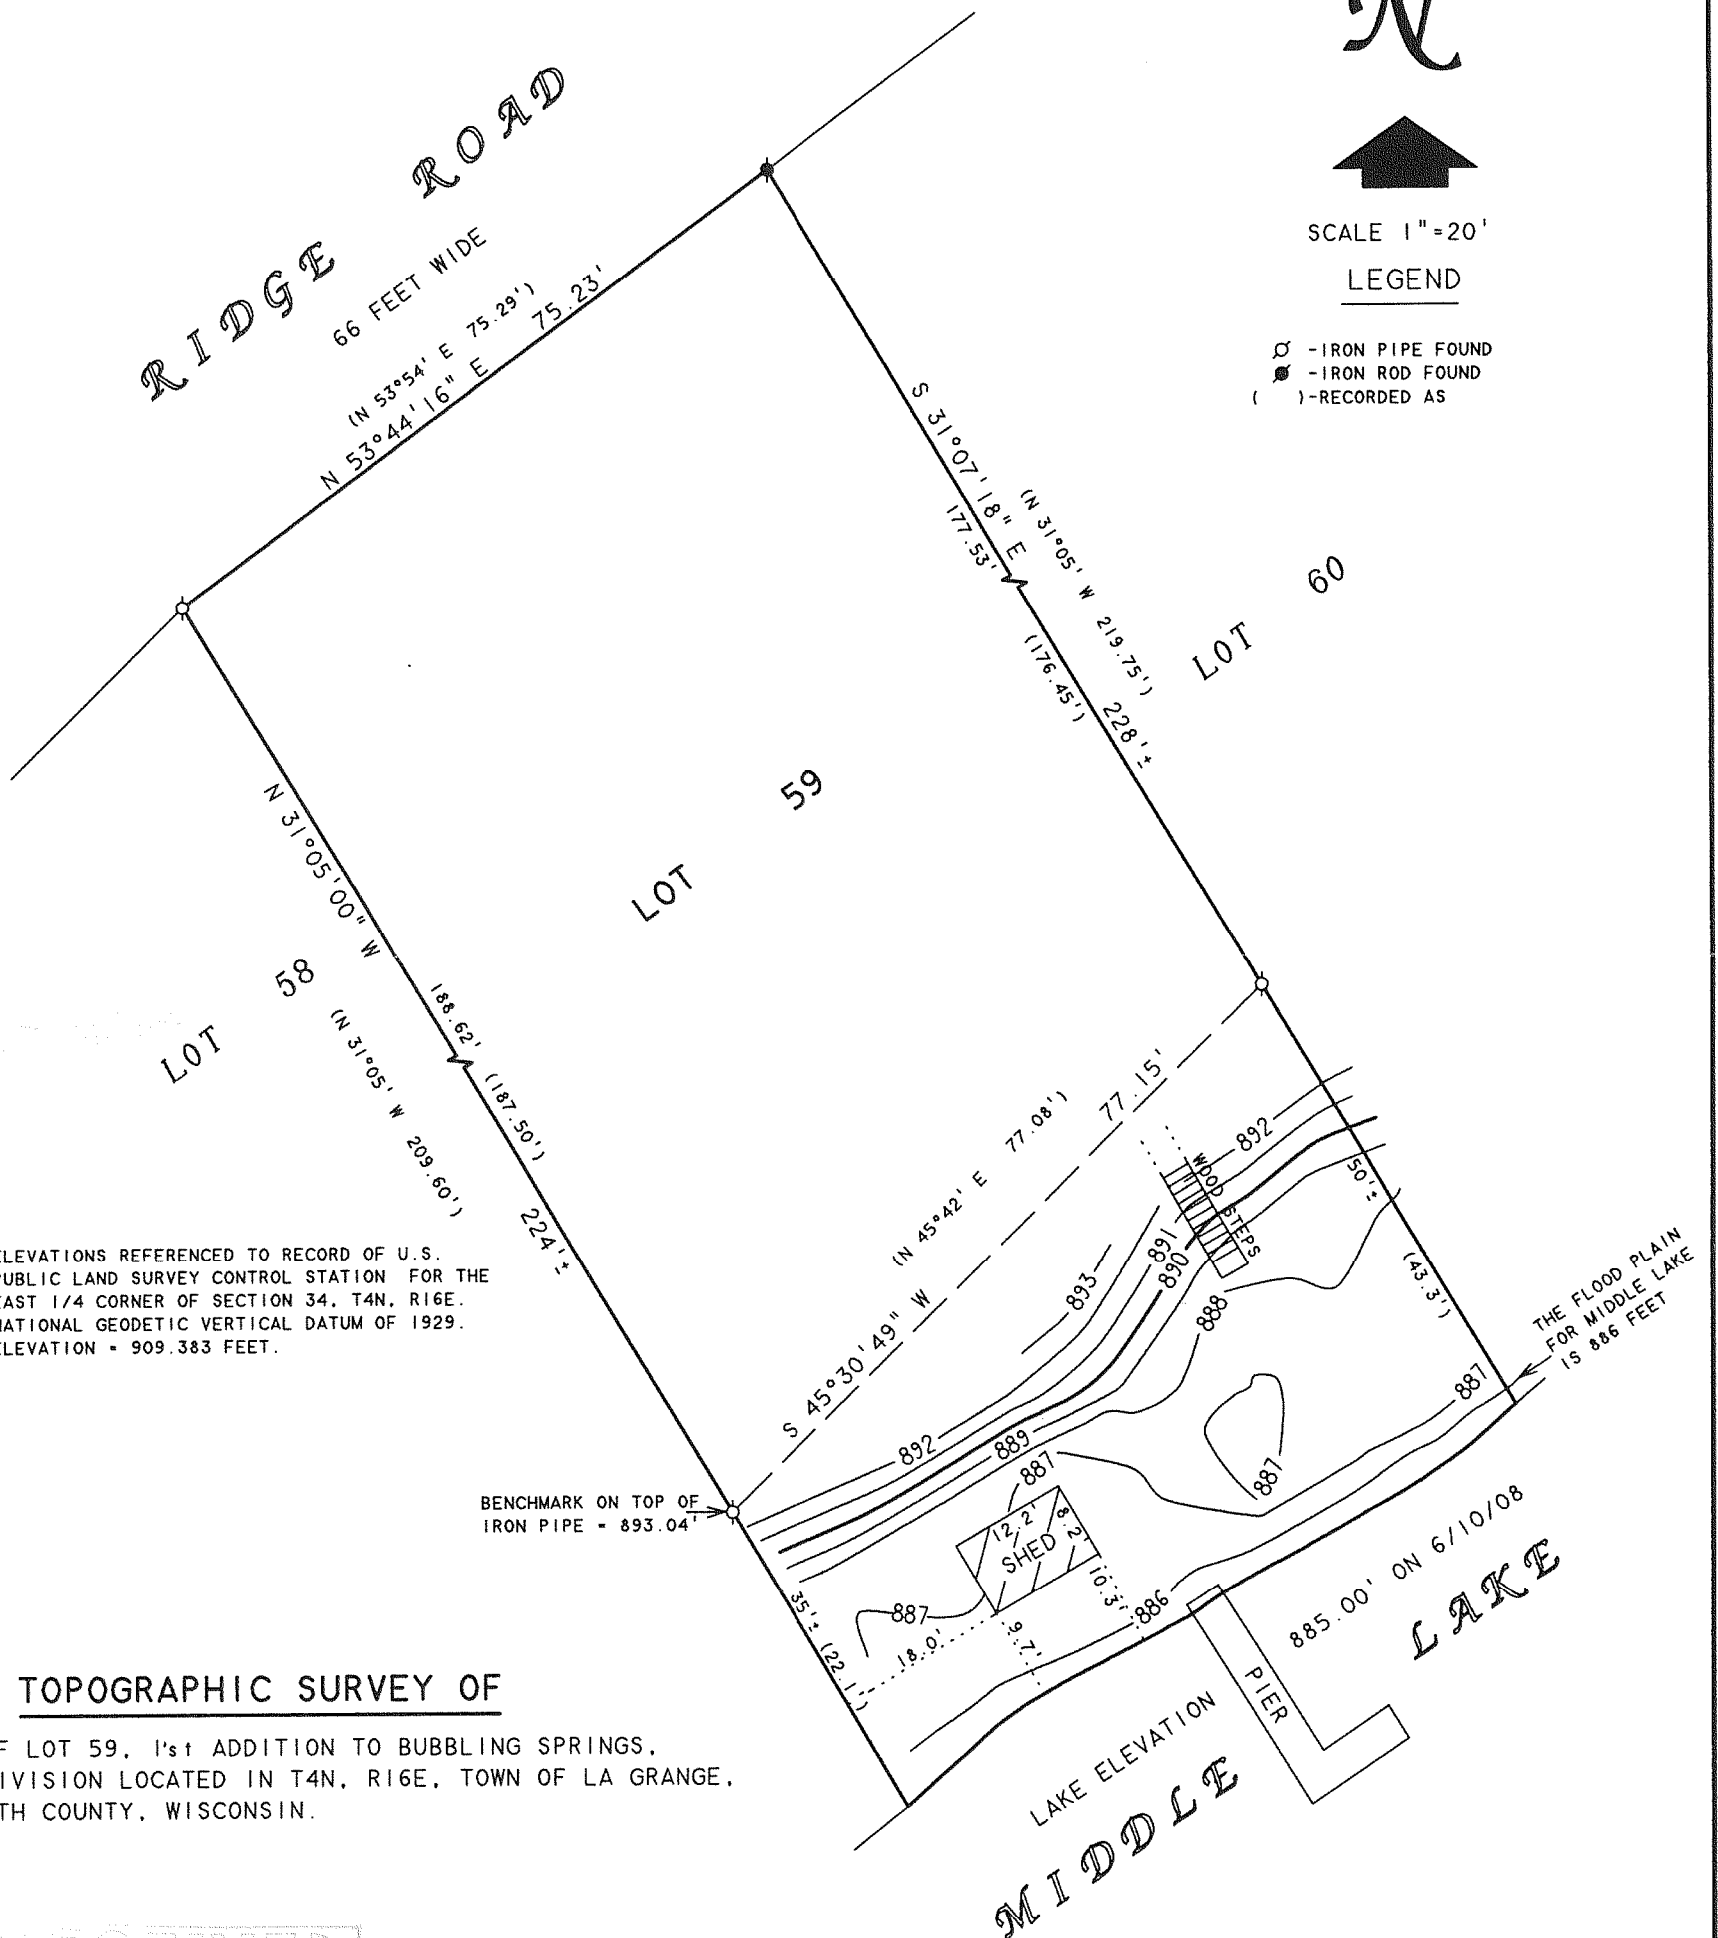

NOTE: ELEVATIONS REFERENCED TO RECORD OF U.S.
PUBLIC LAND SURVEY CONTROL STATION FOR THE
EAST 1/4 CORNER OF SECTION 34, T4N, R16E.
NATIONAL GEODETIC VERTICAL DATUM OF 1929.
ELEVATION = 909.383 FEET.

TOPOGRAPHIC SURVEY OF

PART OF LOT 59, 1st ADDITION TO BUBBLING SPRINGS,
A SUBDIVISION LOCATED IN T4N, R16E, TOWN OF LA GRANGE,
WALWORTH COUNTY, WISCONSIN.

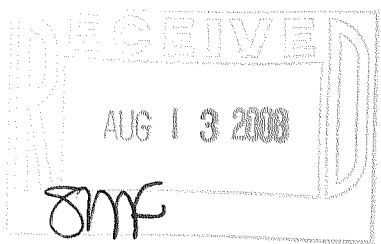

ORDERED BY: JOHN NASON
W5717 RIDGE ROAD
ELKHORN, WI 53121

I, DAVID F. ABELL, DO HEREBY CERTIFY THAT I HAVE SURVEYED THE PROPERTY HEREON
DESCRIBED ACCORDING TO THE OFFICIAL RECORDS AND THAT THE PLAT HEREON IS A
CORRECT REPRESENTATION OF THE PROPERTY LINES TO THE BEST OF MY KNOWLEDGE AND
BELIEF.

David F. Abell

DAVID F. ABELL
WISCONSIN REGISTERED LAND SURVEYOR, S-1596

June 11, 2008

DATE: June 11, 2008 JOB NUMBER - 89049A
NOTE: THIS IS NOT A CERTIFIED COPY UNLESS SEALED.

HBS1-28

416-2353