
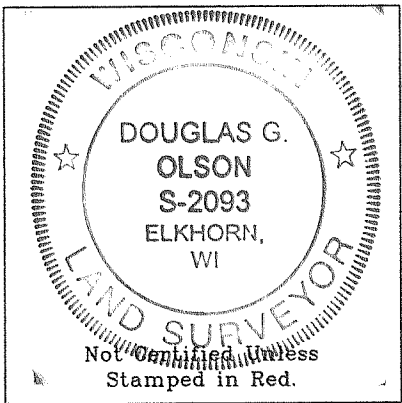


Plat of Survey

of
Lots 3 and 4 of La Selva,
a subdivision located in the Fractional Southeast 1/4 of
Section 26, Town 4 North, Range 16 East, Town of LaGrange,
Walworth County, Wisconsin.

also
Commencing at a point that is 33.00 feet South 22° East
of and 19.50 feet South 69°45' West of the Southeast
corner of Lot 2 of LaSelva Subdivision, LaGrange
Township, Walworth County, Wisconsin, thence Southerly
at right angles to the South side of the road 60.00 feet
to an iron stake, thence Easterly parallel to the South
side of the road 21.33 feet to a point, thence
Northeasterly parallel to the South side of the road
54.34 feet to an iron stake, thence Northerly at right
angles 60.00 feet to the South side of the road, thence
Westerly along the South side of the road to the place
of beginning.

Surveyed for: **Kirk Hinrich**
816 Castlewood Lane
Deerfield, Illinois. 60015

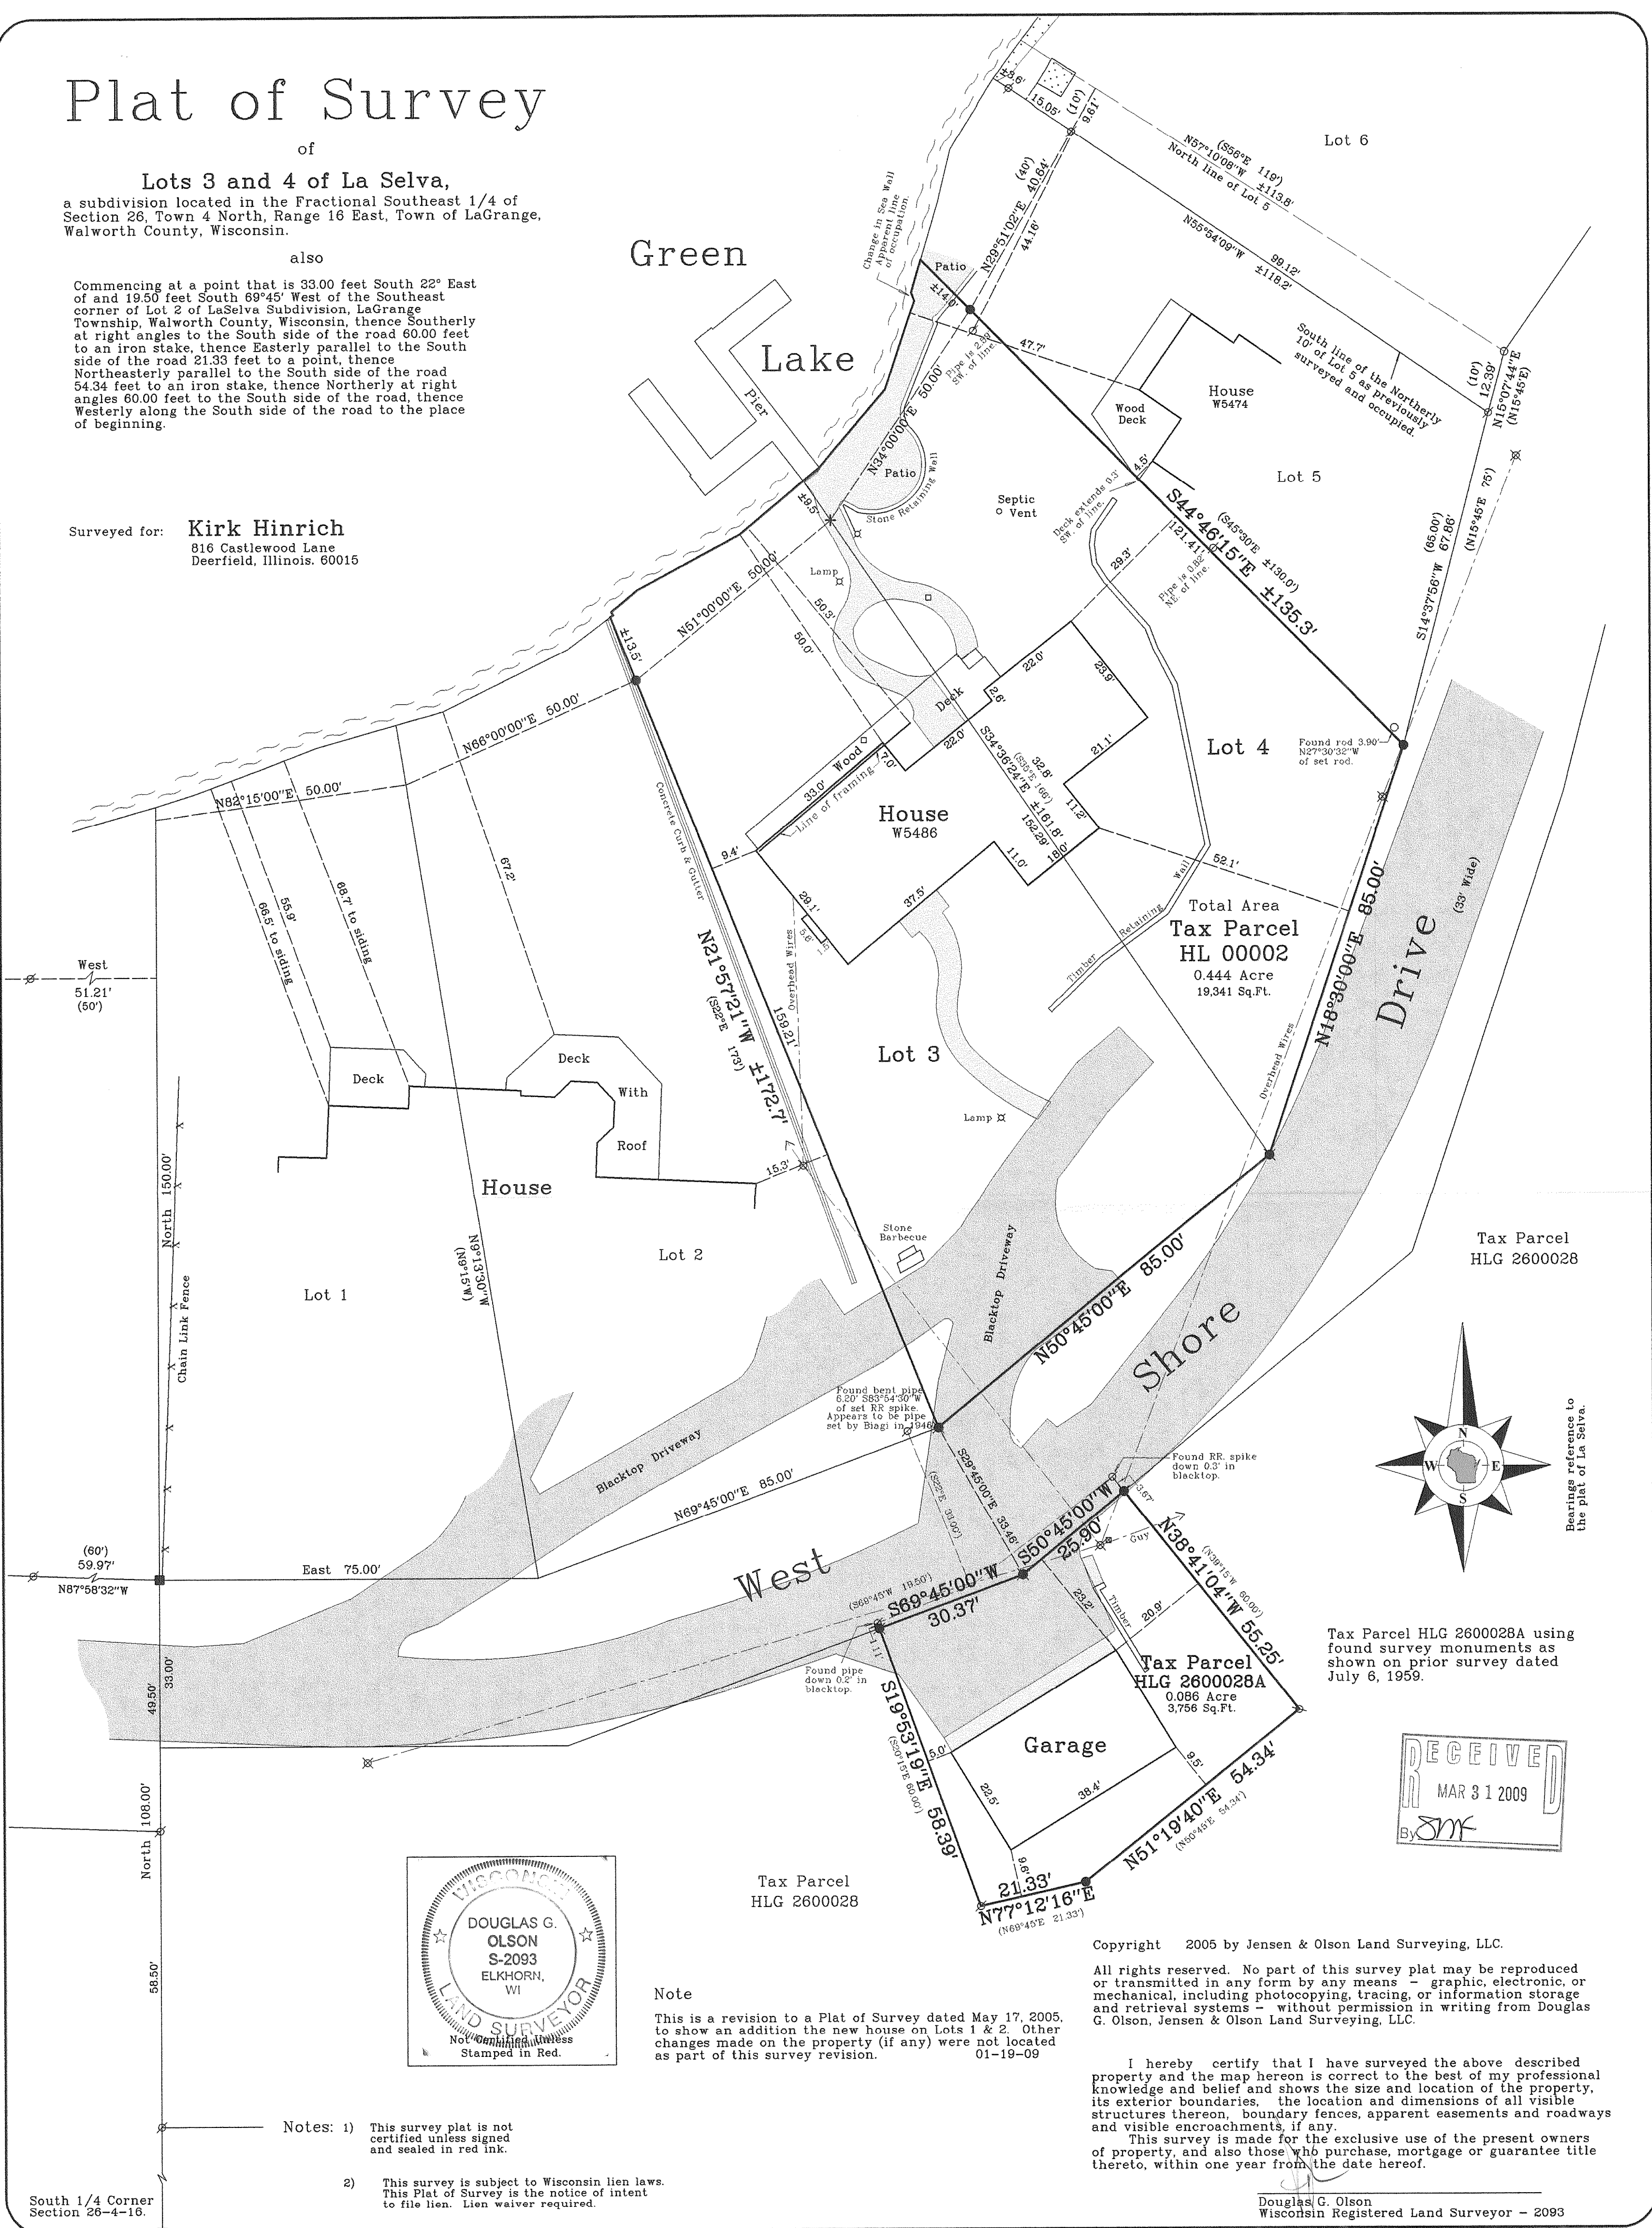

- Notes: 1) This survey plat is not certified unless signed and sealed in red ink.
- 2) This survey is subject to Wisconsin lien laws. This Plat of Survey is the notice of intent to file lien. Lien waiver required.

Note

This is a revision to a Plat of Survey dated May 17, 2005, to show an addition the new house on Lots 1 & 2. Other changes made on the property (if any) were not located as part of this survey revision.

Copyright 2005 by Jensen & Olson Land Surveying, LLC.

All rights reserved. No part of this survey plat may be reproduced or transmitted in any form by any means - graphic, electronic, or mechanical, including photocopying, tracing, or information storage and retrieval systems - without permission in writing from Douglas G. Olson, Jensen & Olson Land Surveying, LLC.

I hereby certify that I have surveyed the above described property and the map hereon is correct to the best of my professional knowledge and belief and shows the size and location of the property, its exterior boundaries, the location and dimensions of all visible structures thereon, boundary fences, apparent easements and roadways and visible encroachments, if any.

This survey is made for the exclusive use of the present owners of property, and also those who purchase, mortgage or guarantee title thereto, within one year from the date hereof.

Douglas G. Olson
Wisconsin Registered Land Surveyor - 2093

Sheet 1 of 1 Sheets

Job Reference Number
2008.133

Legend


- Found Concrete Monument
- Found Iron Pipe
- Found Iron Rod
- Set Chiseled Cross
- Found RR Spike
- Recorded Information
- Asphalt Surface
- Utility Pole
- Concrete
- Cover from prior survey



Jensen & Olson Land Surveying, LLC

45 South Wisconsin Street P.O. Box 322
Elkhorn, Wisconsin. 53121
Telephone (262) 723-3434
Facsimile (262) 723-8044

Scale in Feet

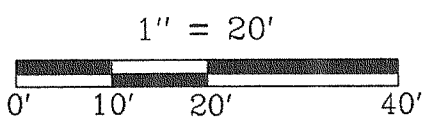

Survey Date: May 17, 2005.
Revisions: No. 1 - New house to the West

2008.133

HL-2

416-2396