




Plat of Survey

of
Lot 21 of Green Lake Subdivision,
located in the Northwest 1/4 of Section 25, Town 4 North, Range
16 East, Town of LaGrange, Walworth County, Wisconsin.

Surveyed for:
Coldwell Banker, Leith & Associates
102 North Wisconsin Street
Elkhorn, Wisconsin. 53121

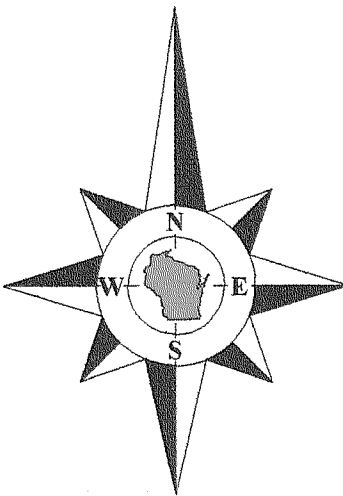

Bearings reference to the plat
of Green Lake Subdivision.

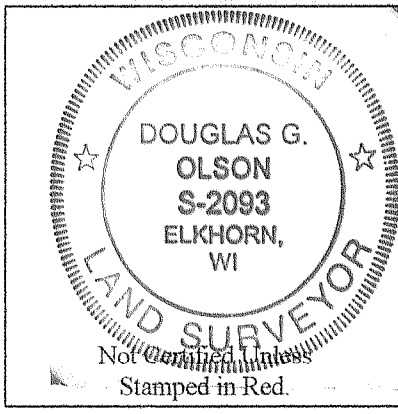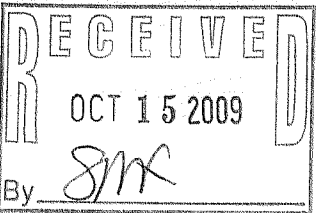

- Notes:**
- 1) This survey plat is not certified unless signed and sealed in red ink.
 - 2) This survey is subject to Wisconsin lien laws. This Plat of Survey is the notice of intent to file lien. Lien waiver required.

Copyright 2009 by Jensen & Olson Land Surveying, LLC.

All rights reserved. No part of this survey plat may be reproduced or transmitted in any form by any means - graphic, electronic, or mechanical, including photocopying, tracing, or information storage and retrieval systems - without permission in writing from Douglas G. Olson, Jensen & Olson Land Surveying, LLC.

I hereby certify that I have surveyed the above described property and the map hereon is correct to the best of my professional knowledge and belief and shows the size and location of the property, its exterior boundaries, the location and dimensions of all visible structures thereon, boundary fences, apparent easements and roadways and visible encroachments, if any.

This survey is made for the exclusive use of the present owners of the property, and also those who purchase, mortgage or guarantee title thereto, within one year from the date hereof.

Douglas G. Olson
Wisconsin Registered Land Surveyor - 2093

Survey Date: May 21, 2009.

Revisions:

Scale in Feet

1" = 20'

0' 10' 20' 40'

Jensen & Olson Land Surveying, LLC

45 South Wisconsin Street * P.O. Box 322 * Elkhorn, Wisconsin. 53121

Telephone: (262) 723-3434 * Facsimile: (262) 723-8044

Email: jensen.olson@elknet.net

Legend

- Found Iron Rod, 3/4" dia.
- Recorded Information
- Concrete Foundation
- Septic Vent - PVC Pipe
- Utility Pedestal
- Asphalt Surface
- Concrete Surface
- Pavers

Sheet 1 of 1 Sheets

Drawing Name: HGS-2009.025-2009.025 Plat

Job Reference Number

2009.025

2009.025

HGS-21

416-2418