

Plat of Survey


Unit 31 of Lauderdale Shores
A Recreational Vehicle Condominium,

located in the Northwest 1/4 of Section 25, Town 4 North, Range
16 East, Town of LaGrange, Walworth County, Wisconsin.
Also, lands described in a Quit Claim Deed recorded December 8, 2003 as Document No. 586500 as shown below:


Real estate designated as Limited Common Element No. 31-A according to Second Amendment to Declaration of Condominium of Lauderdale Shores Condominium recorded on November 5, 1987, in the Walworth County, Wisconsin Register of Deeds Office in Volume 416 on pages 199 through 202, as Document No. 155175.

Grantee further acknowledges that they are aware that the Second Amendment to the Declaration of Condominium of Lauderdale Shores Condominium recorded as Document No. 155175 has been declared void and invalid by the Walworth County Circuit Court, and is utilized in this document solely as a reference to describe the land subject of this document.

Surveyed for: **Dorothy Maag**
10515 West Grand Avenue, Apt. 208
Melrose Park, Illinois. 60164

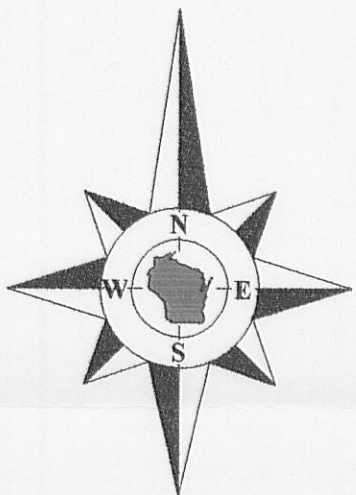

Bearings reference to the plat of
Lauderdale Shores A Recreational
Vehicle Condominium.

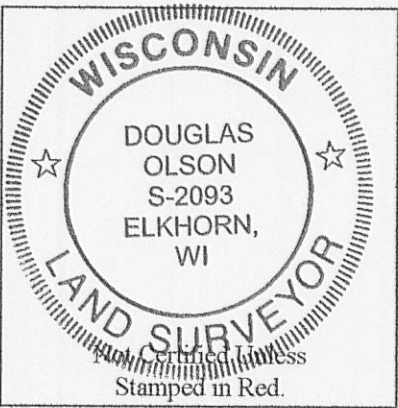

Notes:



- 1) This survey plat is not certified unless signed and sealed in red ink.
- 2) This survey is subject to Wisconsin lien laws. This Plat of Survey is the notice of intent to file lien. Lien waiver required.

Copyright 2009 by Jensen & Olson Land Surveying, LLC.

All rights reserved. No part of this survey plat may be reproduced or transmitted in any form by any means - graphic, electronic, or mechanical, including photocopying, tracing, or information storage and retrieval systems - without permission in writing from Douglas G. Olson, Jensen & Olson Land Surveying, LLC.

I, Douglas G. Olson, Wisconsin Registered Land Surveyor, do hereby certify that this survey was performed by me, or under my direction in full compliance with the owner's/agent's instructions and Chapter A-E 7 of the Wisconsin Administrative Code "Minimum Standards for Property Surveys"; and that this map is an accurate representation thereof to the best of my knowledge and belief.


Douglas G. Olson
Wisconsin Registered Land Surveyor - 2093

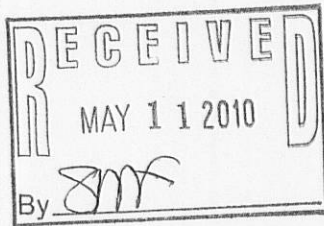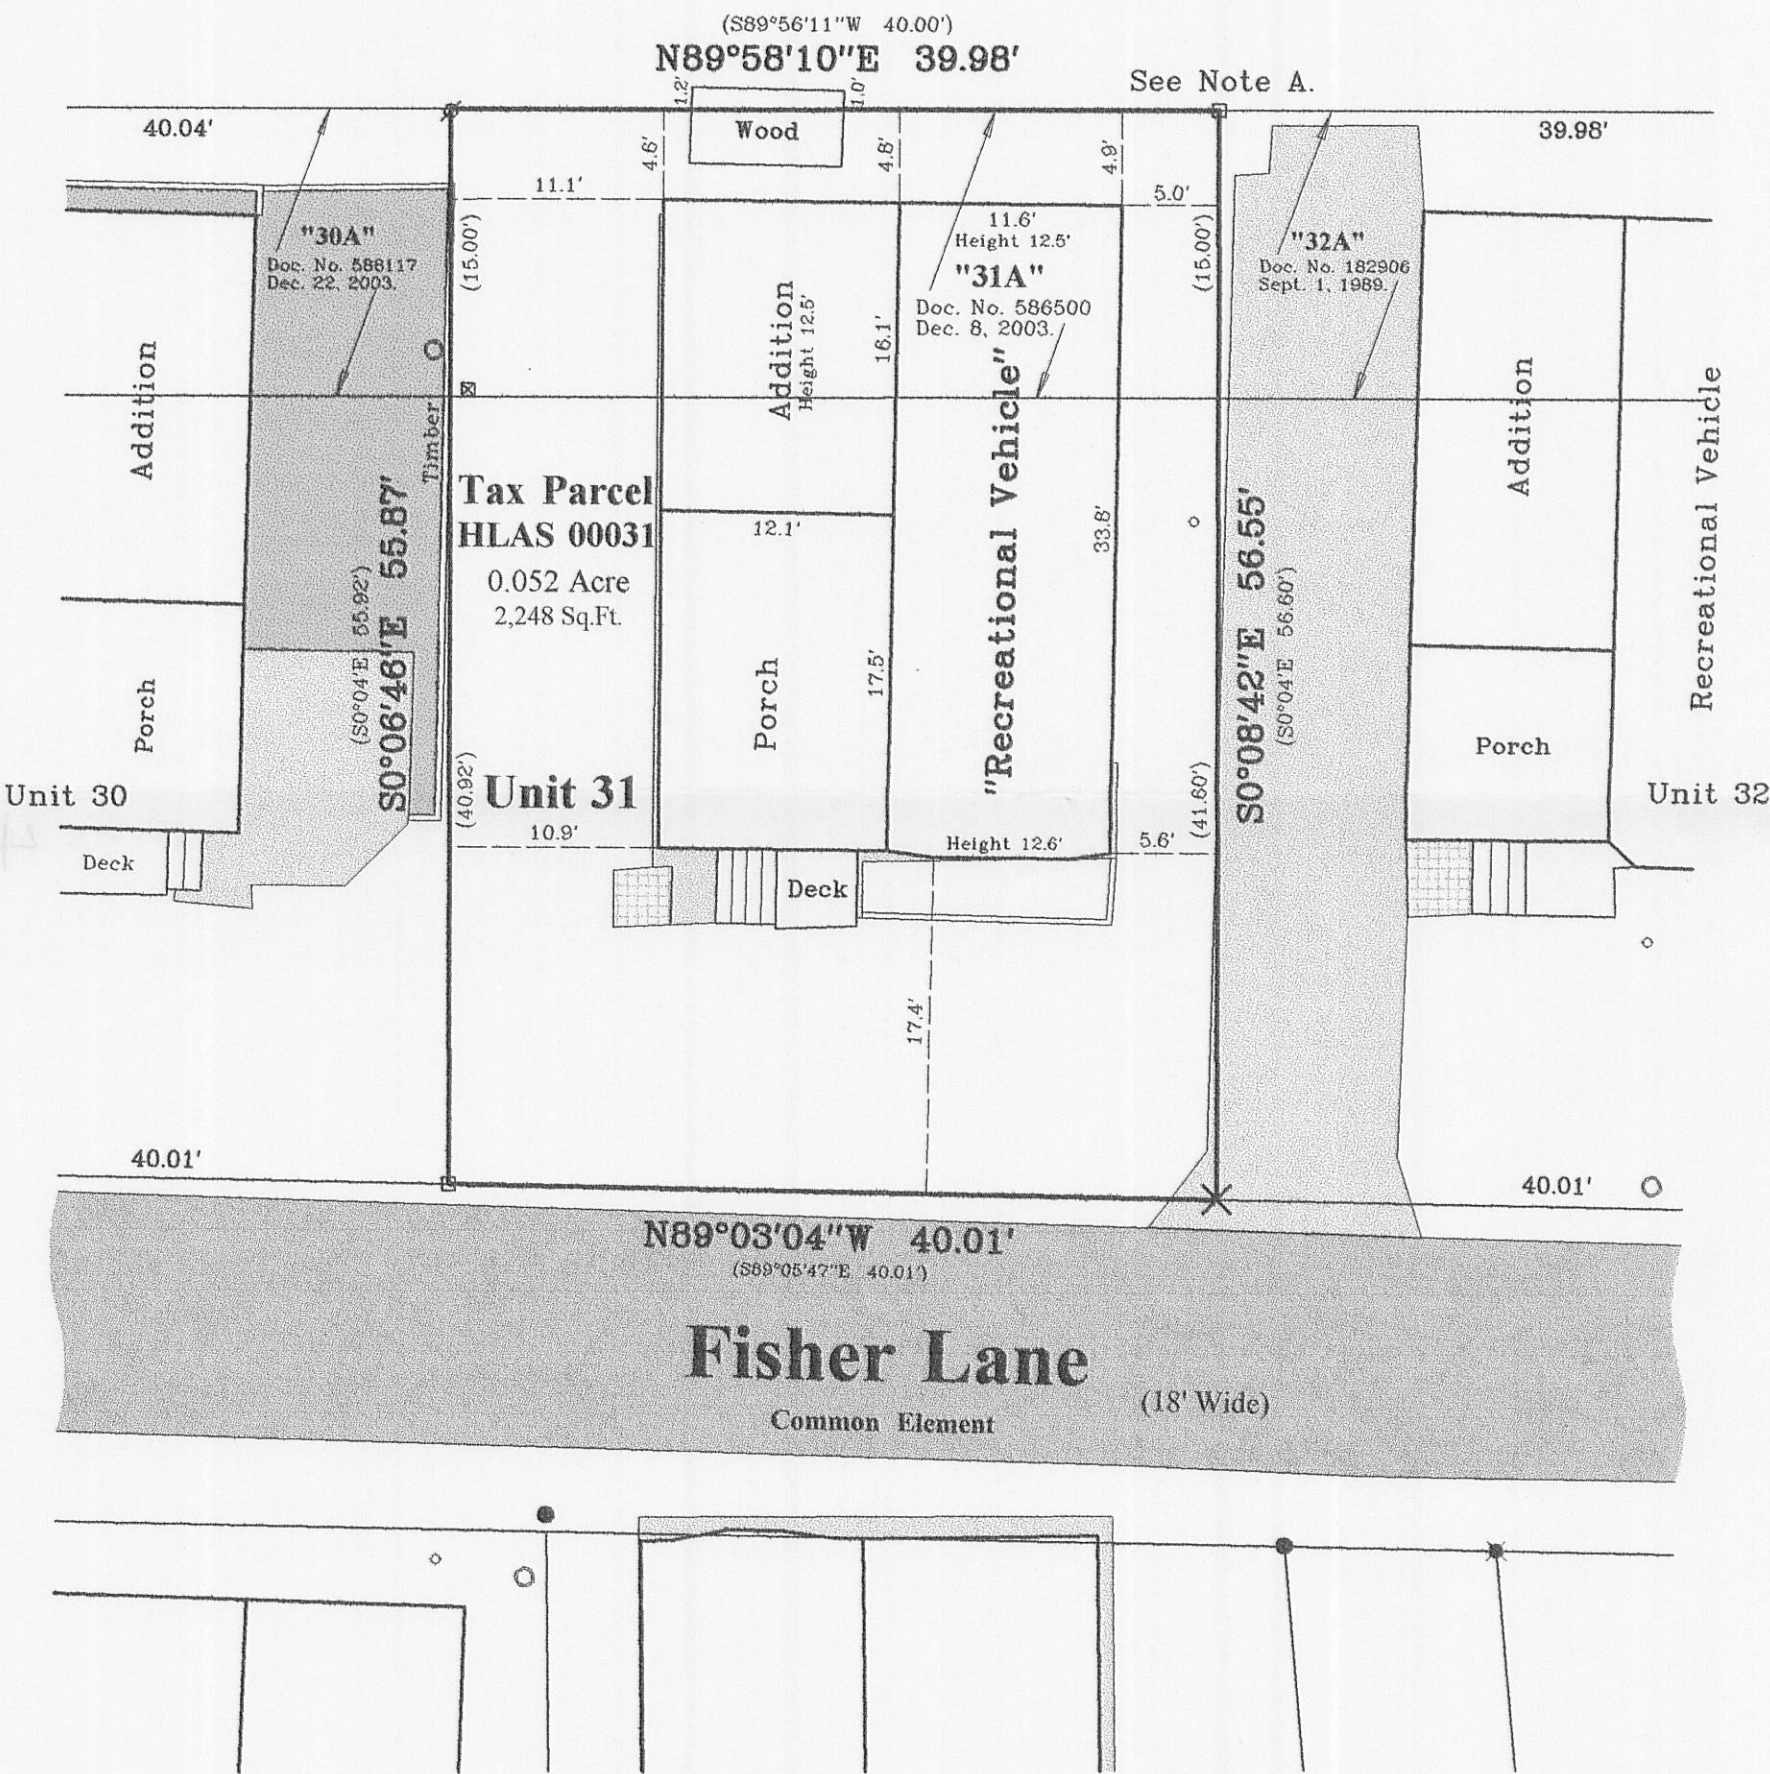

Note A.

The Second Amendment to Declaration of Condominium of Lauderdale Shores Condominium (Second Amendment) was recorded November 5, 1987 in Vol. 416 on Page 199 as Document No. 155175. Among other things this amendment created Limited Common Elements (L.C.E.) 16A, and 21A through 35A inclusive. On June 17, 1991 the Second Amendment was declared to be "null, void and of no legal effect" by Walworth County Circuit Court (File no. 89-CV-326). On December 8, 2003 the lands which were designated as L.C.E. 31A according to Second Amendment were conveyed by Land Contract to the adjacent owner of Unit 31. The former L.C.E. numbers are noted on this plat within quotations for reference purposes only.

Survey Date: November 19, 2003
Revisions: No. 1 - Misc.

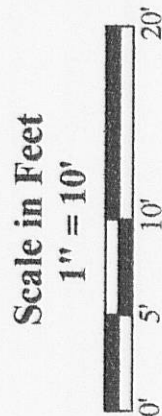

Jensen & Olson Land Surveying, LLC
45 South Wisconsin Street * P.O. Box 322 * Elkhorn, Wisconsin. 53121
Telephone: (262) 723-3434 * Facsimile: (262) 723-8044
Email: jensen.olson@elknet.net

Legend
Found Iron Pipe ● Found Iron Rod
Found Railroad Spike
Set Iron Rod, 3/4" dia.
Set Chiseled Cross
Recorded Information
Asphalt Surface
Gravel Surface
Pavers or Stone
Manhole
Pedestal
Water Spigot

Sheet 1 of 1 Sheets
Drawing Name: HLG-2500028A2
Job Reference Number
2009.100
2009.100