
FARRIS, HANSEN & ASSOCIATES, INC.

ENGINEERING - ARCHITECTURE - SURVEYING
7 RIDGWAY COURT - P.O. BOX 437 - ELKHORN, WISCONSIN 53121
PHONE: (262) 723-2098 FAX: (262) 723-5886

WORK ORDERED BY –
 KEEFE REAL ESTATE
 751 GENEVA PARKWAY
 LAKE GENEVA, WI. 53147

PLAT OF SURVEY

Lot 4 of Certified Survey Map No. 26, recorded in the Office of the Register of Deeds for Walworth County, Wisconsin, on August 8, 1967, in Volume 1, Page 26, as Document No. 594059, being in the Southwest ¼ of Section 35, Town 4 North, Range 16 East. Said land being in the Town of LaGrange, County of Walworth, and State of Wisconsin.

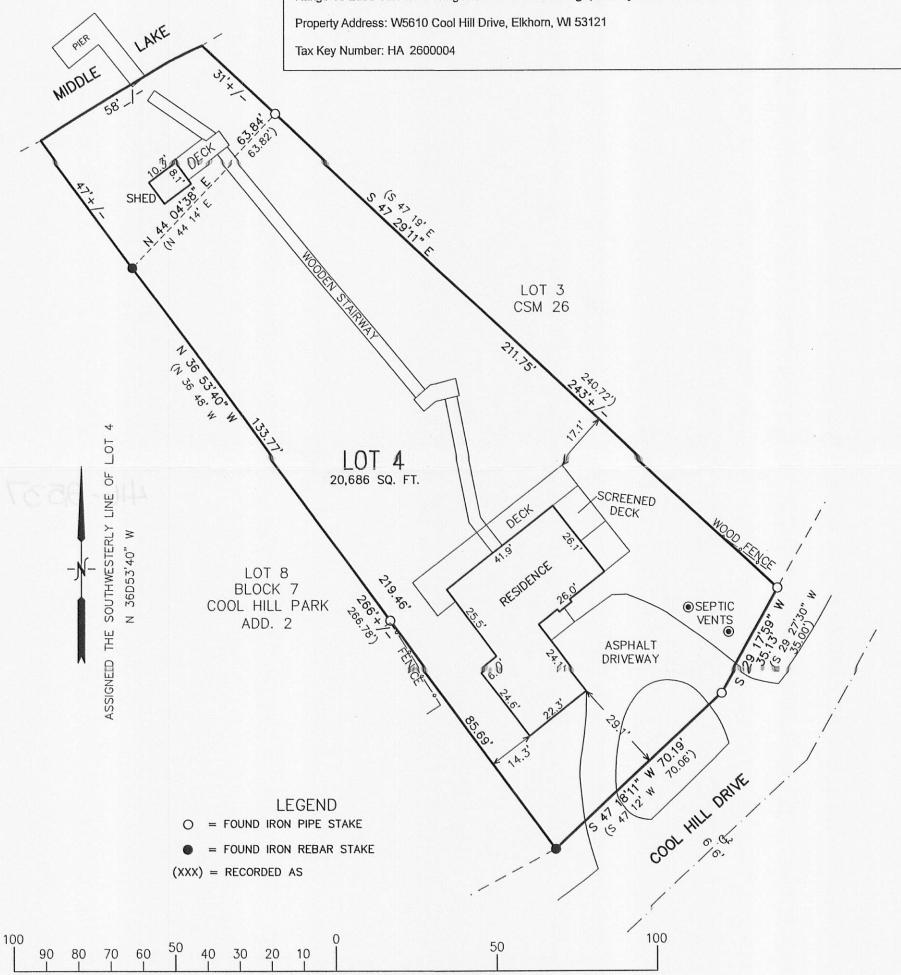

MAP SCALE IN FEET ORIGINAL 1" = 30'

NOTE: COPIES OF THIS MAP TO WHICH THE FOLLOWING CERTIFICATE WILL APPLY SHOW SURVEYOR'S ORIGINAL SEAL AND SIGNATURE IN RED INK. COPIES BY ANY OTHER MEANS MAY HAVE ALTERATIONS WHICH DO NOT REPRESENT THE SURVEYOR'S WORK PRODUCT.

I HEREBY CERTIFY THAT THE ABOVE DESCRIBED PROPERTY HAS BEEN SURVEYED UNDER MY DIRECTION AND THAT THE ABOVE MAP IS A TRUE REPRESENTATION THEREOF AND SHOWS THE SIZE AND LOCATION OF THE PROPERTY, ITS EXTERIOR BOUNDARIES, THE LOCATION OF ALL VISIBLE STRUCTURES, AND DIMENSIONS OF ALL PRINCIPLE BUILDINGS THEREON, BOUNDARY FENCES, APPARENT EASEMENTS, ROADWAYS, AND VISIBLE ENCROACHMENTS, IF ANY. THIS SURVEY IS MADE FOR THE USE OF THE PRESENT OWNERS OF THE PROPERTY, AND ALSO THOSE WHO PURCHASE, MORTGAGE, OR GUARANTEE THE TITLE THERETO WITHIN ONE YEAR FROM THE DATE HEREOF.

DATED: JUNE 3, 2011

PETER S. GORDÓN R.L.S. 2101

DEGE IVE JUN 2 9 2011 By See



PROJECT: 8372 DATE: 06-03-2011 SHEET 1 OF 1

JUN 0 3 2020 HA 26-4

416-2537

* \Projects\8372\dcad\survey

6/3/2011