


SKETCH OF EASEMENT FOR
 GEORGE THOMPSON

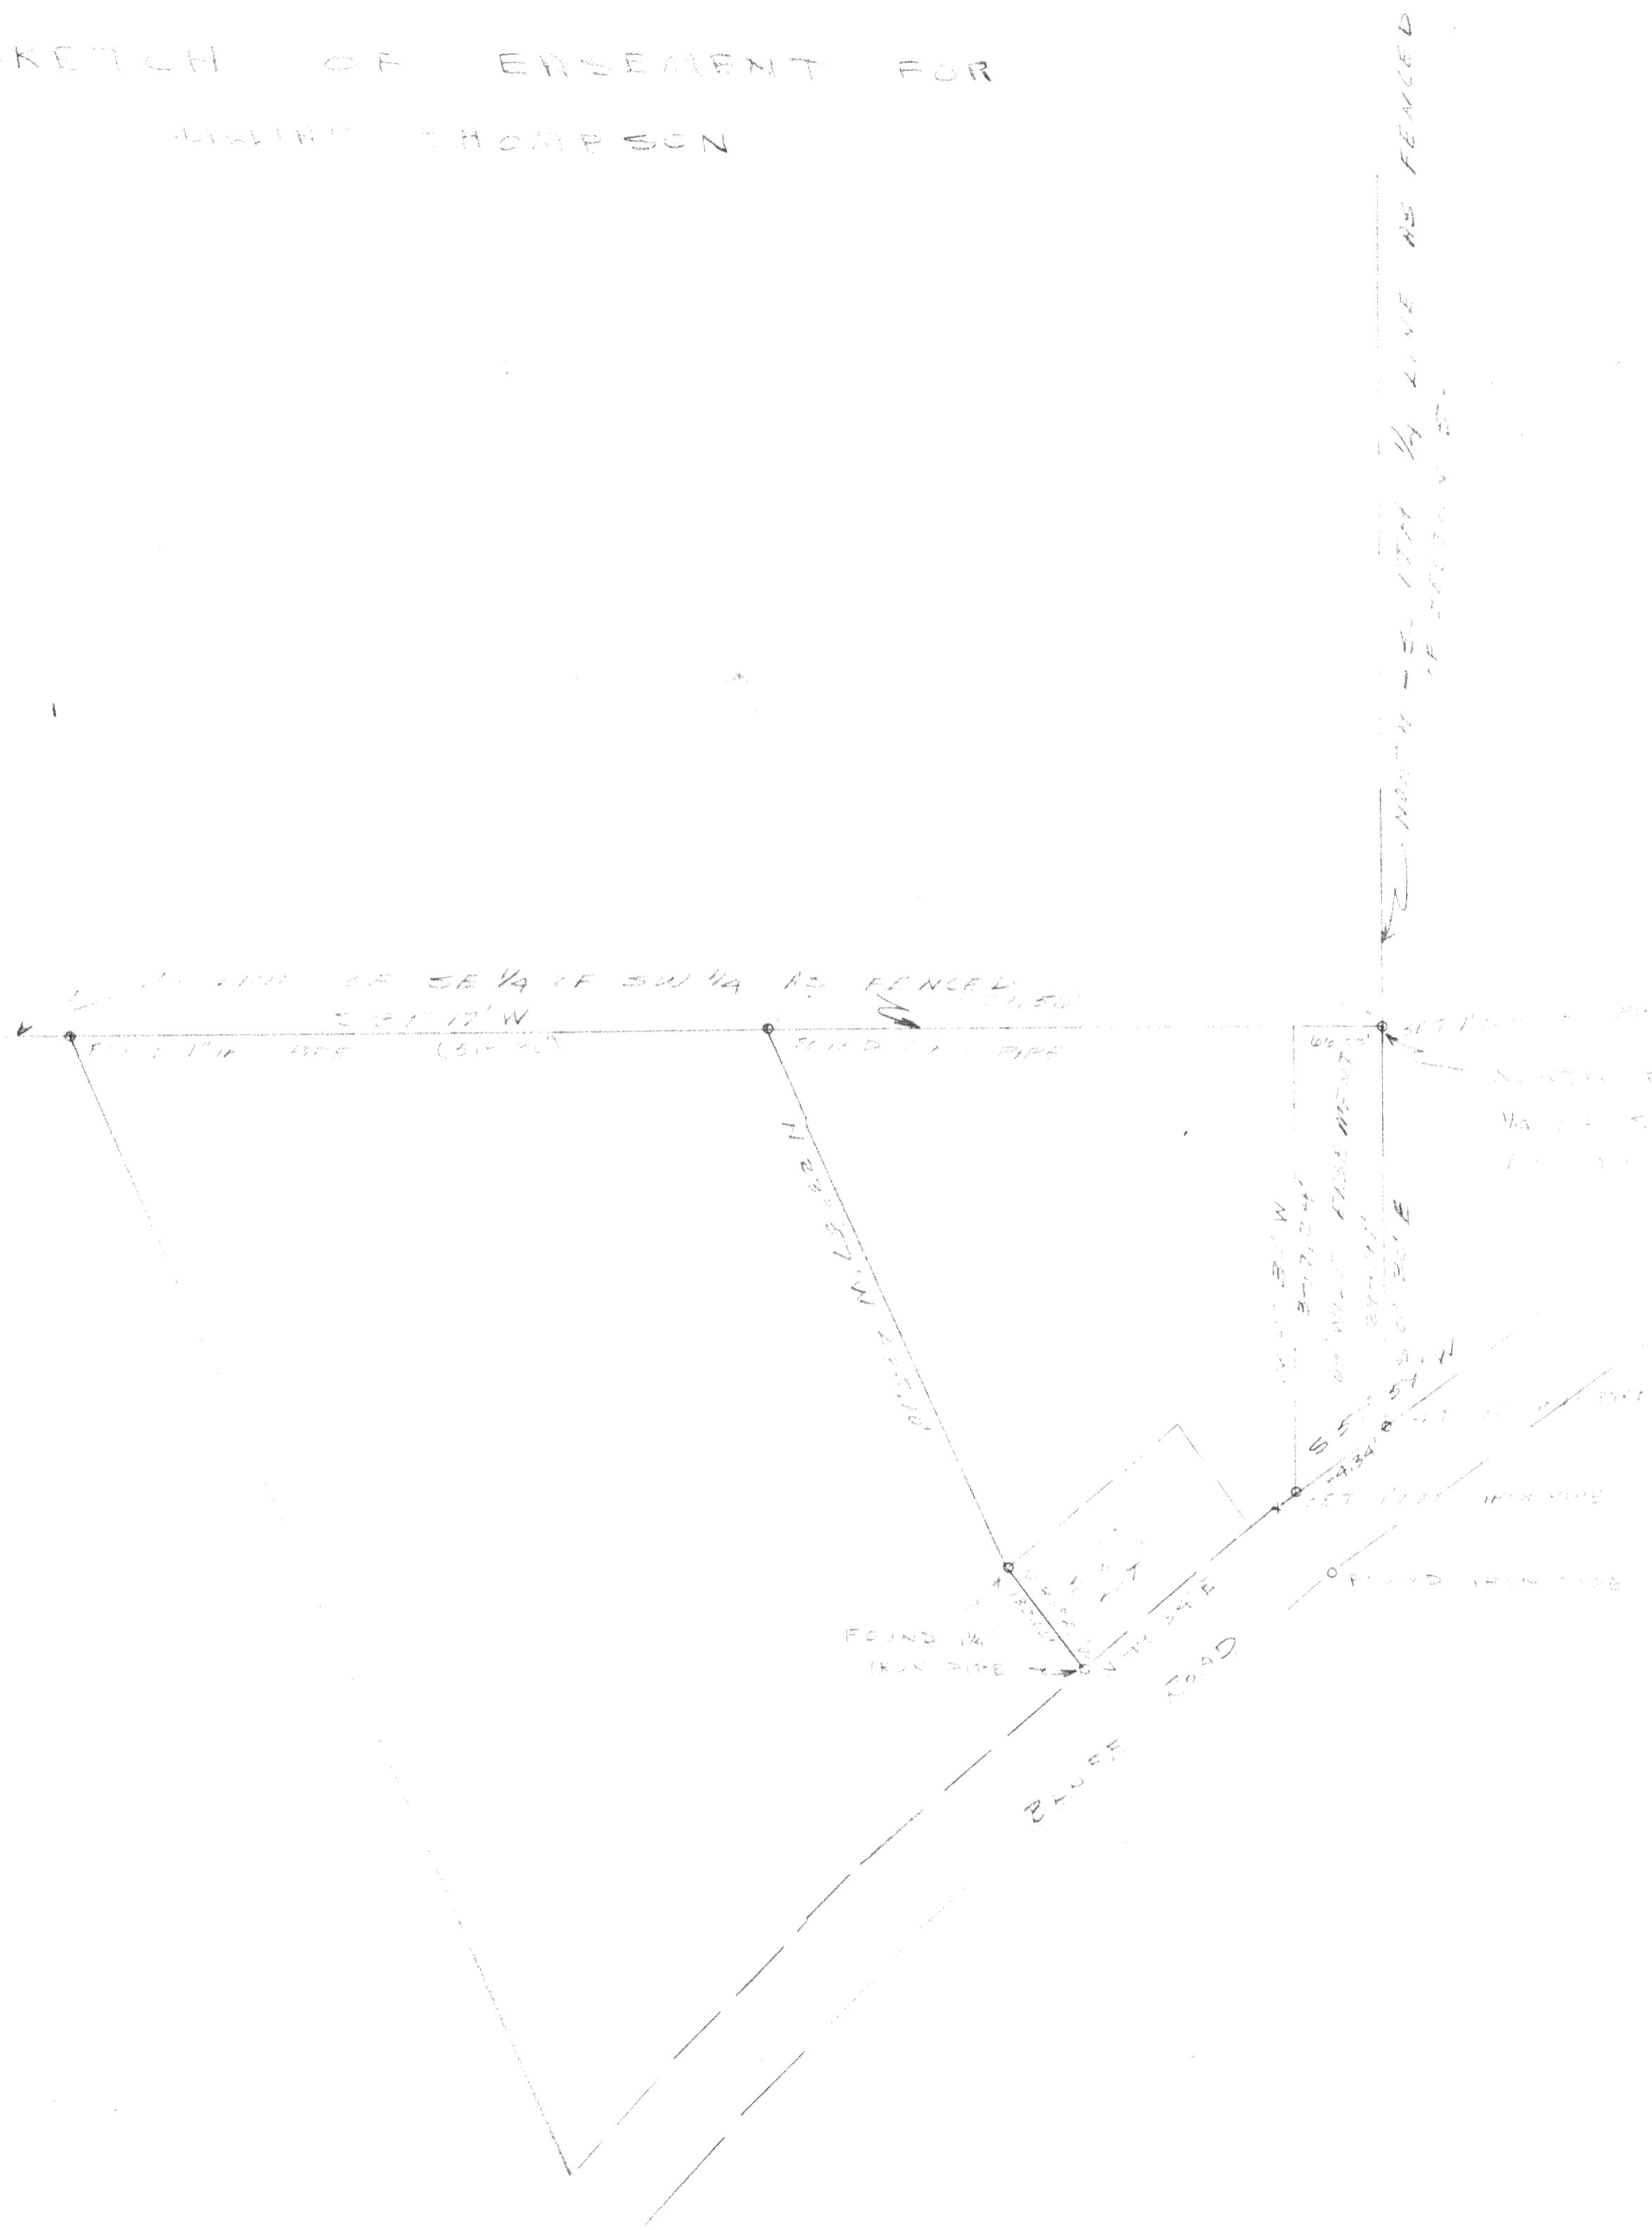

LG-5-11D

416-254

George Thompson