
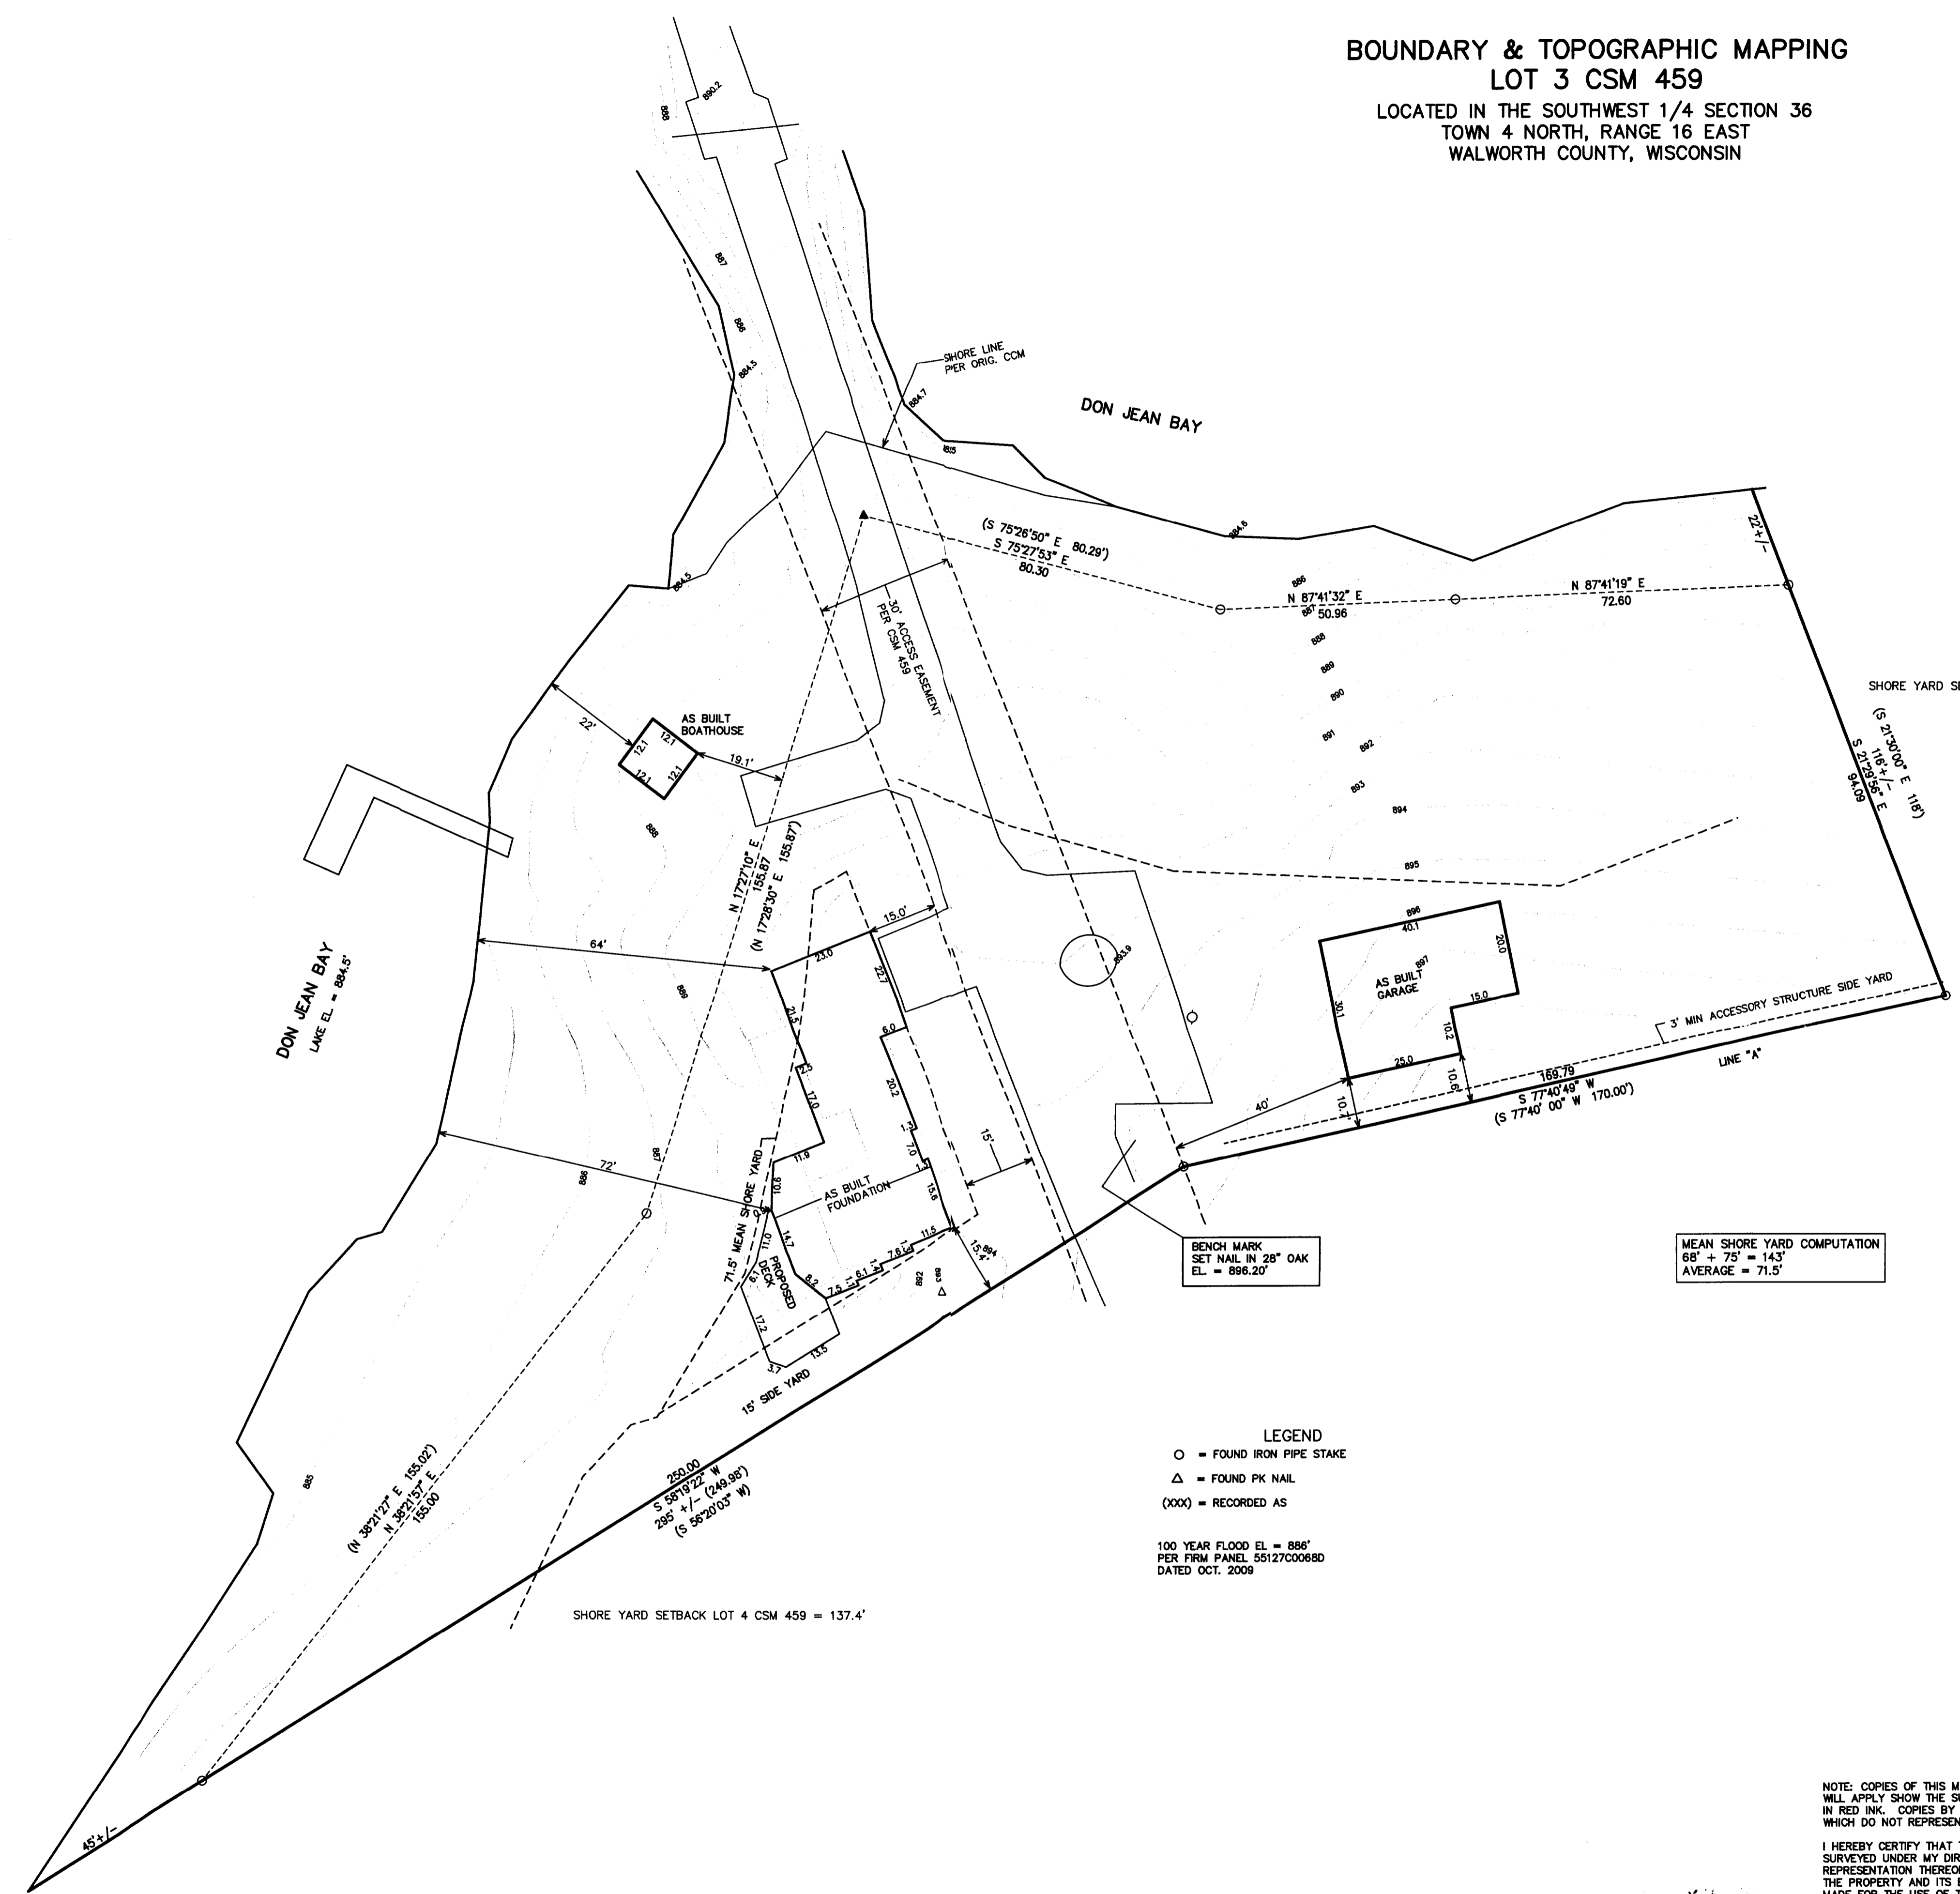


BOUNDARY & TOPOGRAPHIC MAPPING
LOT 3 CSM 459
 LOCATED IN THE SOUTHWEST 1/4 SECTION 36
 TOWN 4 NORTH, RANGE 16 EAST
 WALWORTH COUNTY, WISCONSIN

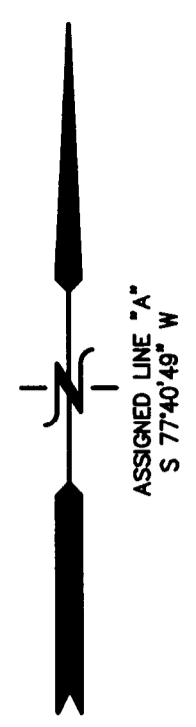

BENCH MARK
 SET NAIL IN 28\" OAK
 EL. = 896.20'

MEAN SHORE YARD COMPUTATION
 68' + 75' = 143'
 AVERAGE = 71.5'

LEGEND
 ○ = FOUND IRON PIPE STAKE
 △ = FOUND PK NAIL
 (XXX) = RECORDED AS

100 YEAR FLOOD EL. = 886'
 PER FIRM PANEL 55127C0068D
 DATED OCT. 2009

NOTE: COPIES OF THIS MAP TO WHICH THE FOLLOWING CERTIFICATE WILL APPLY SHOW THE SURVEYOR'S ORIGINAL SEAL AND SIGNATURE IN RED INK. COPIES BY ANY OTHER MEANS MAY HAVE ALTERATIONS WHICH DO NOT REPRESENT THE SURVEYOR'S WORK PRODUCT.

I HEREBY CERTIFY THAT THE ABOVE DESCRIBED PROPERTY HAS BEEN SURVEYED UNDER MY DIRECTION AND THAT THE ABOVE MAP IS A TRUE REPRESENTATION THEREOF AND SHOWS THE SIZE AND LOCATION OF THE PROPERTY AND ITS EXTERIOR BOUNDARIES. THIS SURVEY IS MADE FOR THE USE OF THE PRESENT OWNERS OF THE PROPERTY, AND ALSO THOSE WHO PURCHASE, MORTGAGE, OR GUARANTEE THE TITLE THERETO WITHIN ONE YEAR FROM THE DATE HEREOF.

DATED: OCTOBER 21, 2011 REVISION 12-15-2011
 TO SHOW AS BUILT STRUCTURES

JAN - 5 2012

PETER S. GORDON R.L.S. 2101

MAP SCALE IN FEET ORIGINAL 1" = 20'

ORDERED BY:
 SWEETWATERS BUILDERS
 PO BOX 404
 DELAVAN, WI.

FARRIS, HANSEN & ASSOCIATES, INC.
 ENGINEERING - ARCHITECTURE - SURVEYING
 7 RIDGWAY COURT P.O. BOX 437
 ELKHORN, WISCONSIN 53121
 OFFICE: (262) 723-2098 FAX: (262) 723-5886

REVISIONS

PROJECT NO.
 8465
 DATE
 10-21-2011
 SHEET NO.
 1 OF 1

HA 459-3

416-2561