
Found Found Found (Record Willity Concre O Septic

Job Reference Number 2011.063

2011.063

416-2566

Plat of Survey

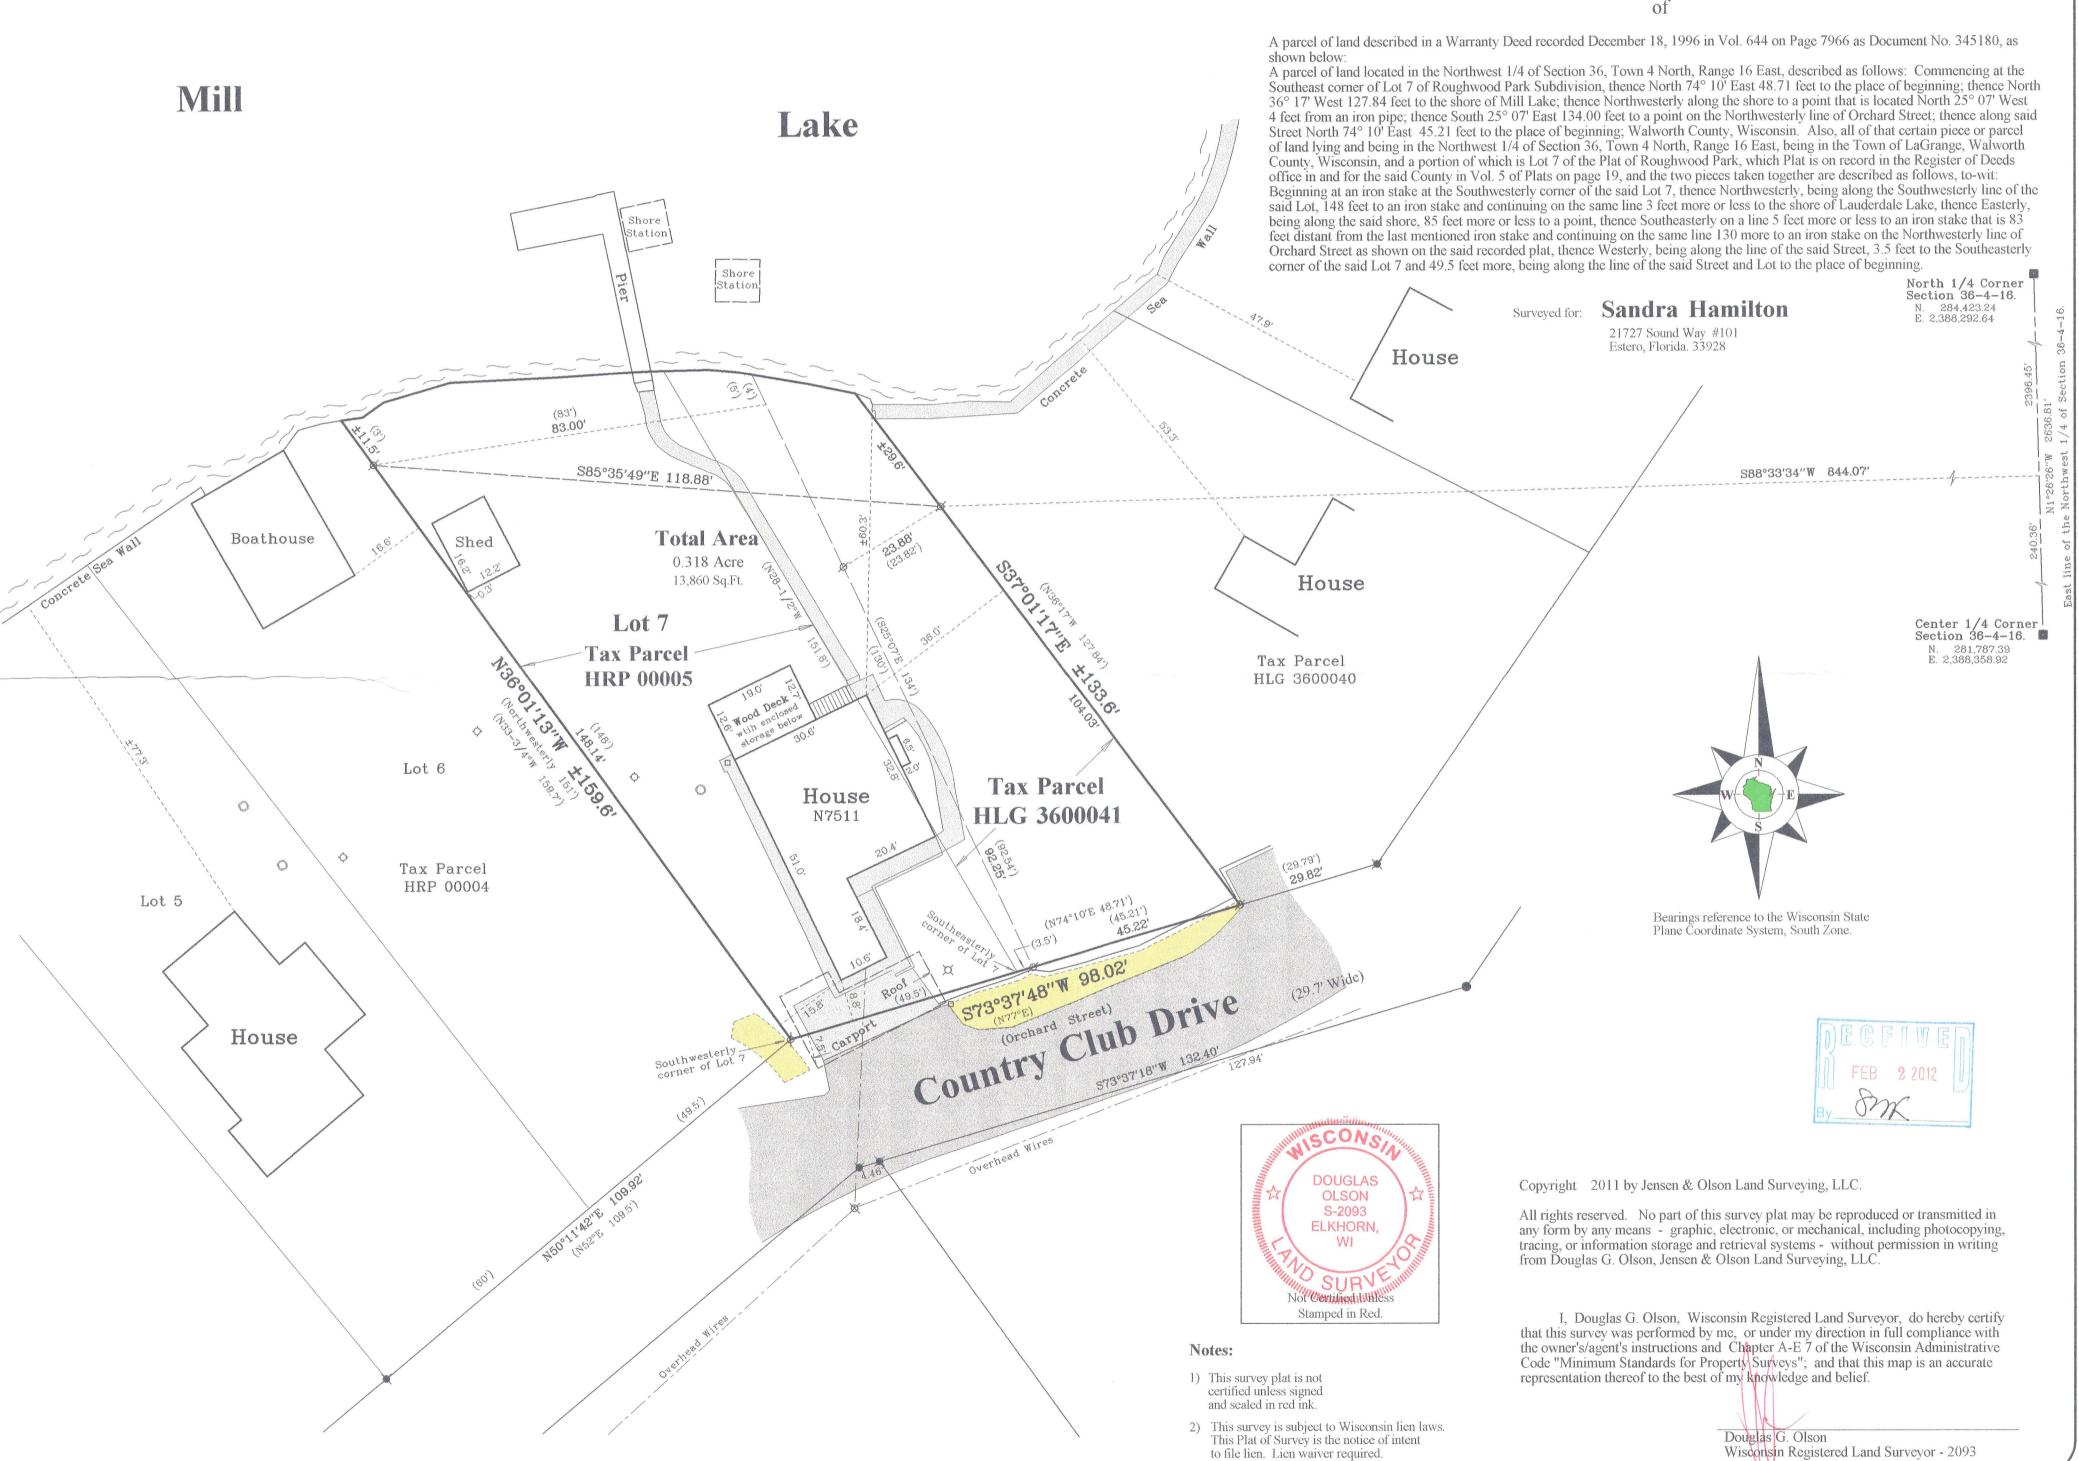

to file lien. Lien waiver required.