


**LOTS 18 AND 19 OF BLOCK 2 OF THANSLAND SUBDIVISION
AND ADJACENT LANDS TO THE SOUTH, LOCATED IN THE
NE 1/4 OF SECTION 35, TOWN 4 NORTH, RANGE 16 EAST,
WALWORTH COUNTY, WISCONSIN.**

SITE ADDRESS: W5488 LOST NATION ROAD

LEGAL DESCRIPTION:
(RECORDED IN VOL. 554 P. 927)

Lot 19 in Block 2 of Than's Land Subdivision, according to the recorded plat thereon. Also a piece or parcel of land situated directly South of Lot 19 in Block 2 of Than's Land Subdivision, which parcel is a continuation of said Lot 19 to the South, and is described as follows: Commencing at the Southeast corner of said Lot 19; running South 359 feet to an iron stake; thence Southwesterly 61.25 feet more or less along the North side of the existing road to an iron stake; thence Southwesterly 100 feet to the Northwest corner of Lot 18 along the South line of said Lot 19 to the place of beginning. Lot 18 in Block 2 of Than's Land Subdivision, according to the recorded plat thereon. Also a piece or parcel of land situated directly North of Lot 18 and West 50 feet of the following: Commencing at the Southeast corner of Lot 16 of said block; thence West 145 feet to the Southwest corner of Lot 18; thence North 145 feet to the North line of said Lot 18; thence North parallel to the North line of said Lot 18 to an iron stake; thence Northeasterly 179 feet to an iron stake; thence North parallel with the North and South 1/4 section line to the place of beginning.

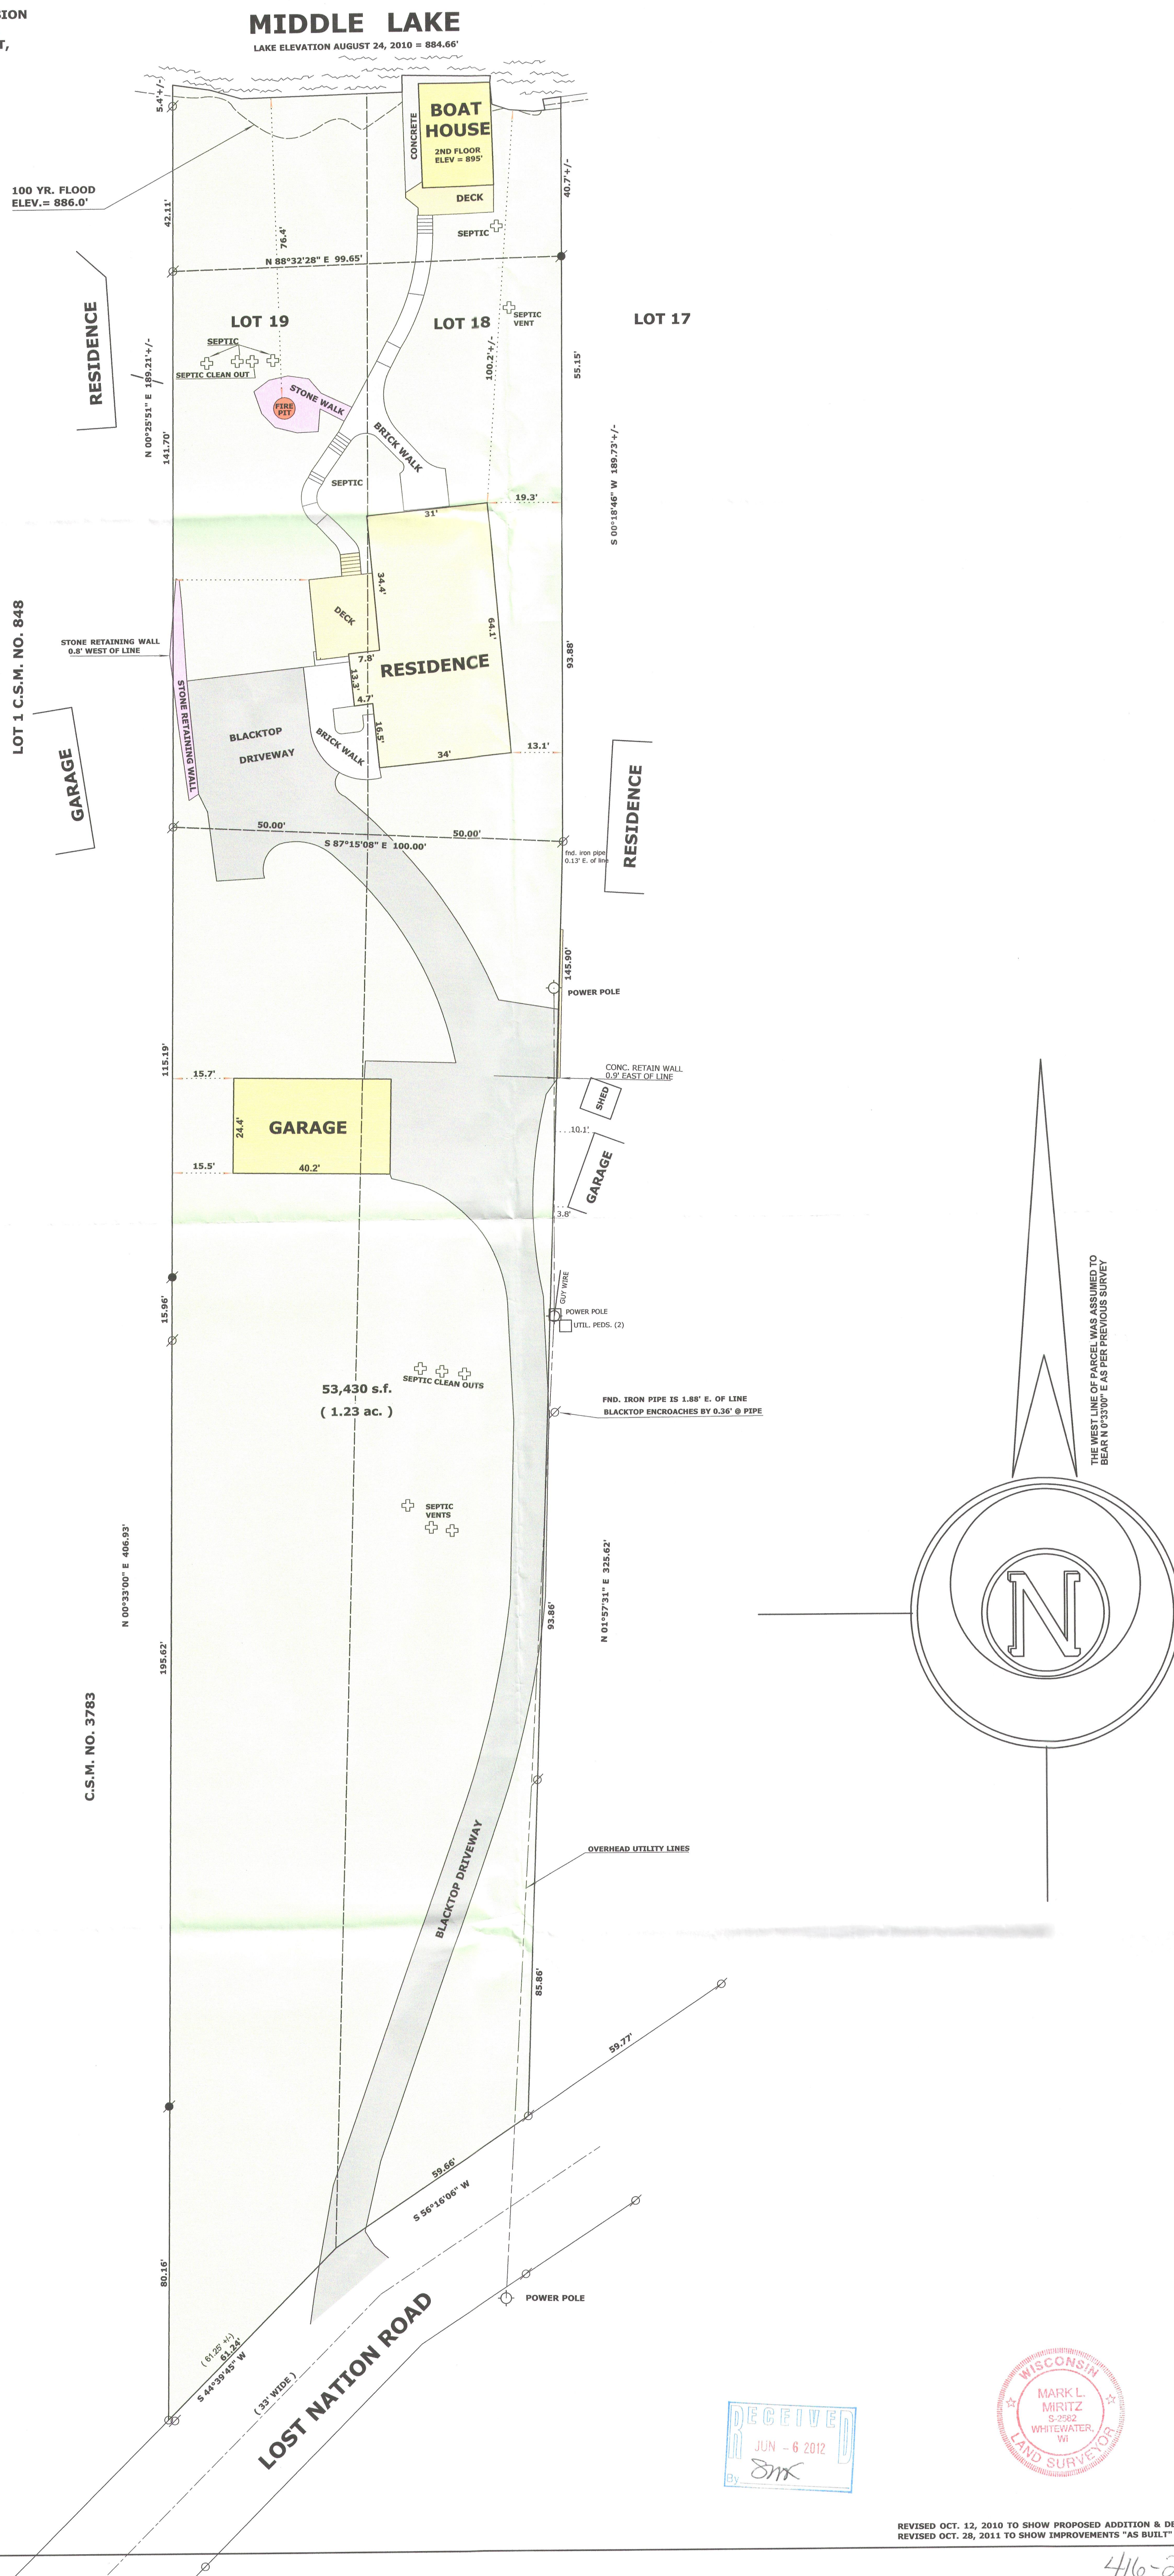

LEGEND

- | | |
|---|-----------------------|
| | FOUND IRON PIPE |
| | FOUND IRON ROD |
| (x x) | RECORDED AS DIMENSION |

SCALE: 1 INCH = 20 FEET

"I hereby certify that the above described property has been surveyed by me or under my direction and that the above map is a true representation thereof and shows the size and location of the property, its exterior boundaries, the location of all visible structures and dimensions of all principal buildings thereon, boundary fences, apparent easements, roadways and visible encroachments, if any."

"This survey is made for the use of the present owners of the property, and also those who purchase, mortgage, or guarantee the title thereto within one year from date hereof."

MARK L. MIRITZ
WISCONSIN REGISTERED
LAND SURVEYOR S-2582

DATE: AUGUST 31, 2010 JOB NO. 06.305

REVISED OCT. 12, 2010 TO SHOW PROPOSED ADDITION & DECK
REVISED OCT. 28, 2011 TO SHOW IMPROVEMENTS "AS BUILT"

HTL - 25

416-2594