

FARRIS, HANSEN & ASSOCIATES, INC.



ENGINEERING — ARCHITECTURE — SURVEYING
7 RIDGWAY COURT — P.O. BOX 437 — ELKHORN, WISCONSIN 53121
PHONE: (262) 723-2098 FAX: (262) 723-5886

— WORK ORDERED BY —
FRANK & CLAUDIA MICHALSKI
W4969 HAWK ROAD
ELKHORN, WI. 53121

PLAT OF SURVEY

LOT 14 WALNUT HILLS SUBDIVISION

LOCATED IN THE NE 1/4 OF THE NW 1/4 AND THE NW 1/4 OF THE NE 1/4 AND THE SW 1/4
OF THE NE 1/4, ALL IN SECTION 36, T4N, R16E, WALWORTH COUNTY, WI.

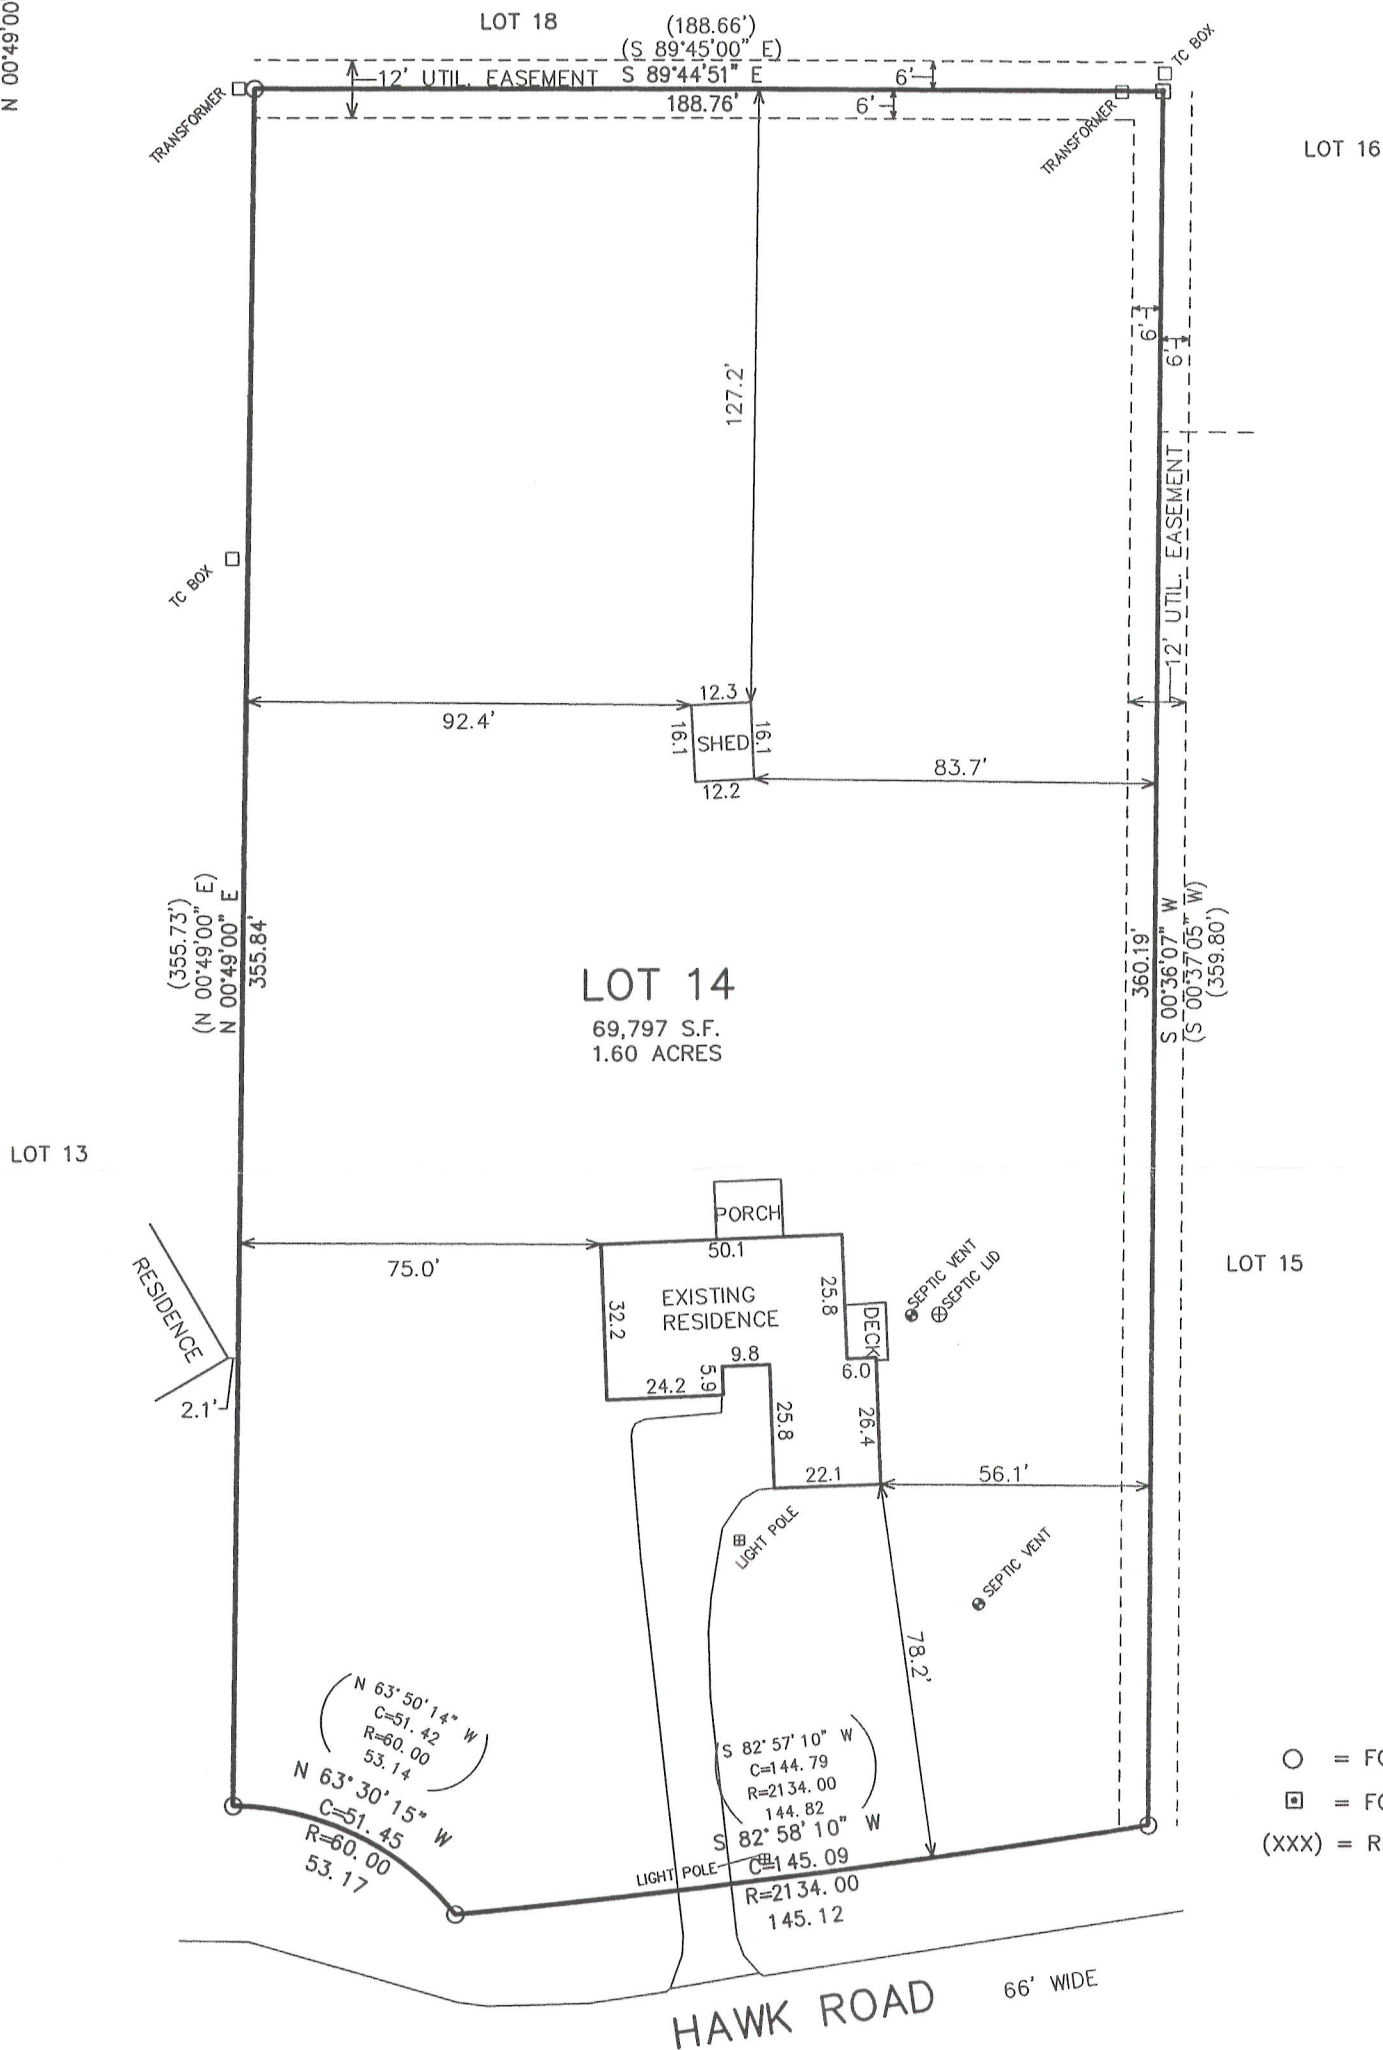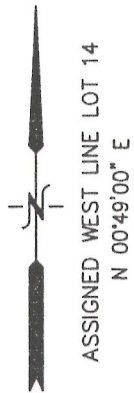

LEGEND
○ = FOUND IRON PIPE STAKE
□ = FOUND CONCRETE MONUMENT
(XXX) = RECORDED AS

NOTE: COPIES OF THIS MAP TO WHICH THE FOLLOWING CERTIFICATE
WILL APPLY SHOW THE SURVEYOR'S ORIGINAL SEAL AND SIGNATURE
IN RED INK. COPIES BY ANY OTHER MEANS MAY HAVE ALTERATIONS
WHICH DO NOT REPRESENT THE SURVEYOR'S WORK PRODUCT.

I HEREBY CERTIFY THAT THE ABOVE DESCRIBED PROPERTY HAS BEEN
SURVEYED UNDER MY DIRECTION AND THAT THE ABOVE MAP IS A TRUE
REPRESENTATION THEREOF AND SHOWS THE SIZE AND LOCATION OF
THE PROPERTY AND ITS EXTERIOR BOUNDARIES. THIS SURVEY IS
MADE FOR THE USE OF THE PRESENT OWNERS OF THE PROPERTY, AND
ALSO THOSE WHO PURCHASE, MORTGAGE, OR GUARANTEE THE TITLE
THERE TO WITHIN ONE YEAR FROM THE DATE HEREOF.

DATED: SEPTEMBER 17, 2012

Peter S. Gordon
PETER S. GORDON R.L.S. 2101



PROJECT: 8651
DATE: 09-17-2012
SHEET 1 OF 1

HTLW-14
SEP 17 2012

416-2618