


Plat of Survey


of
Lot 24 of Block 1 of Bay View Manor,
 a subdivision located in the Northwest 1/4 of Section 36, Town 4 North, Range 16 East, Town of LaGrange, Walworth County, Wisconsin.

Surveyed for: **Keefe Real Estate, Inc.**
 1040 North Wisconsin Street
 Elkhorn, Wisconsin. 53121

Sterlingworth Bay

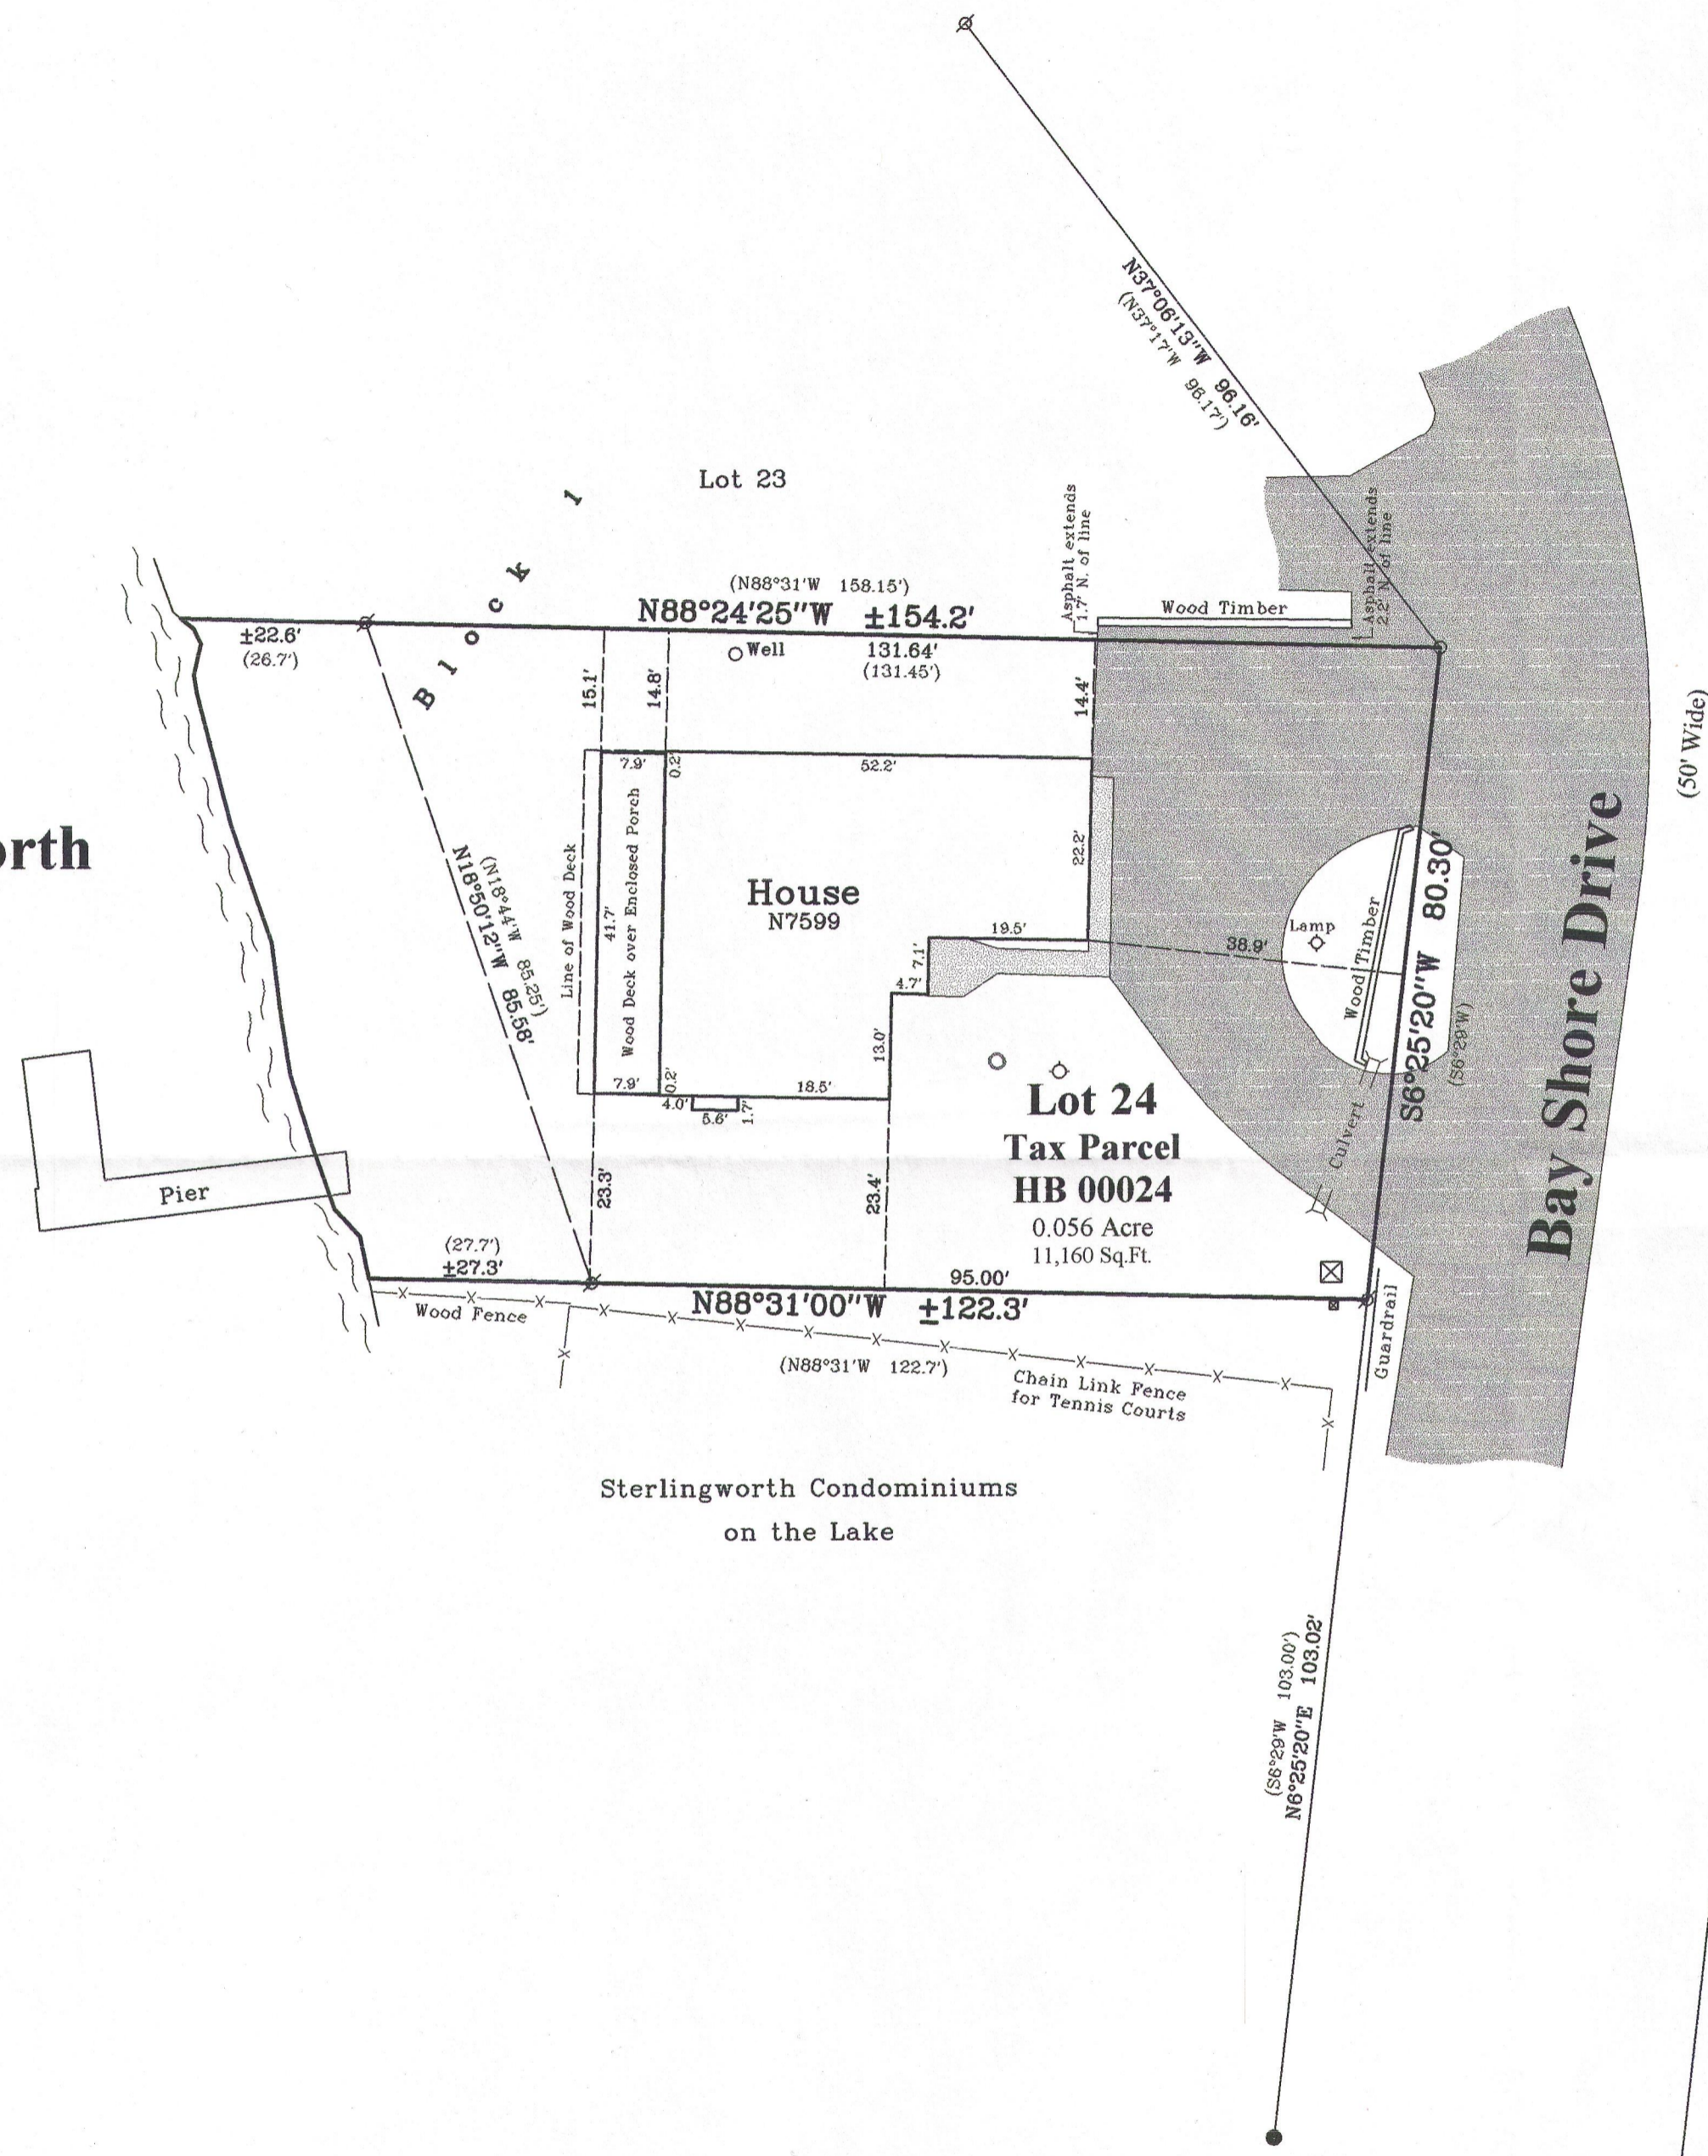

Bearings reference to the plat of Bay View Manor.

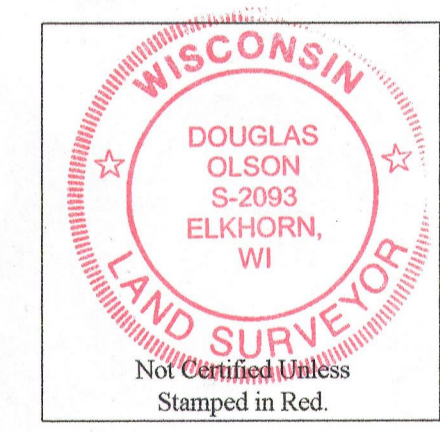


- Notes:**
- 1) This survey plat is not certified unless signed and sealed in red ink.
 - 2) This survey is subject to Wisconsin lien laws. This Plat of Survey is the notice of intent to file lien. Lien waiver required.

Copyright 2012 by Jensen & Olson Land Surveying, LLC.

All rights reserved. No part of this survey plat may be reproduced or transmitted in any form by any means - graphic, electronic, or mechanical, including photocopying, tracing, or information storage and retrieval systems - without permission in writing from Douglas G. Olson, Jensen & Olson Land Surveying, LLC.


I hereby certify that I have surveyed the above described property and the map hereon is correct to the best of my professional knowledge and belief and shows the size and location of the property, its exterior boundaries, the location and dimensions of all visible structures thereon, boundary fences, apparent easements and roadways and visible encroachments, if any.
 This survey is made for the exclusive use of the present owners of the property, and also those who purchase, mortgage or guarantee title thereto, within one year from the date hereof.

Douglas G. Olson
 Wisconsin Registered Land Surveyor - 2093

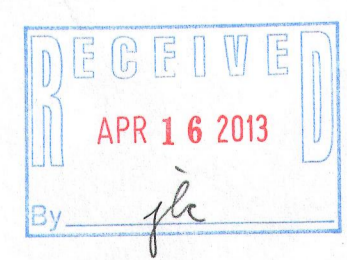

HB 00024 4116-264D

Survey Date: January 4, 2013.
 Revisions:

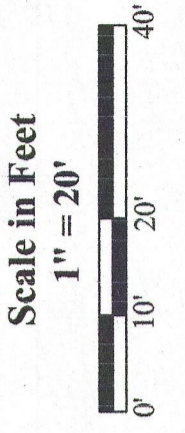

Jensen & Olson Land Surveying, LLC
 45 South Wisconsin Street * P.O. Box 322 * Elkhorn, Wisconsin. 53121
 Telephone: (262) 723-3434 * Facsimile: (262) 723-8044
 Email: jensen.olson@elknet.net

Legend
 Found Iron Pipe 1-8/16" dia.
 Found Iron Rod.
 Found P.K. Nail
 Recorded Information
 Utility Box or Pedestal
 Concrete Cover
 Asphalt Surface
 Concrete

Sheet 1 of 1 Sheets
 Drawing Name: hb-16-2012127-2012127(Plat.sj)
 Job Reference Number
2012.127

2012.127